

QUORUM DR.


MARCEY ST.

FACTORY STREET

BELT LINE ROAD

ST. LOUIS & SOUTHWESTERN RAILROAD

DALLAS PARKWAY

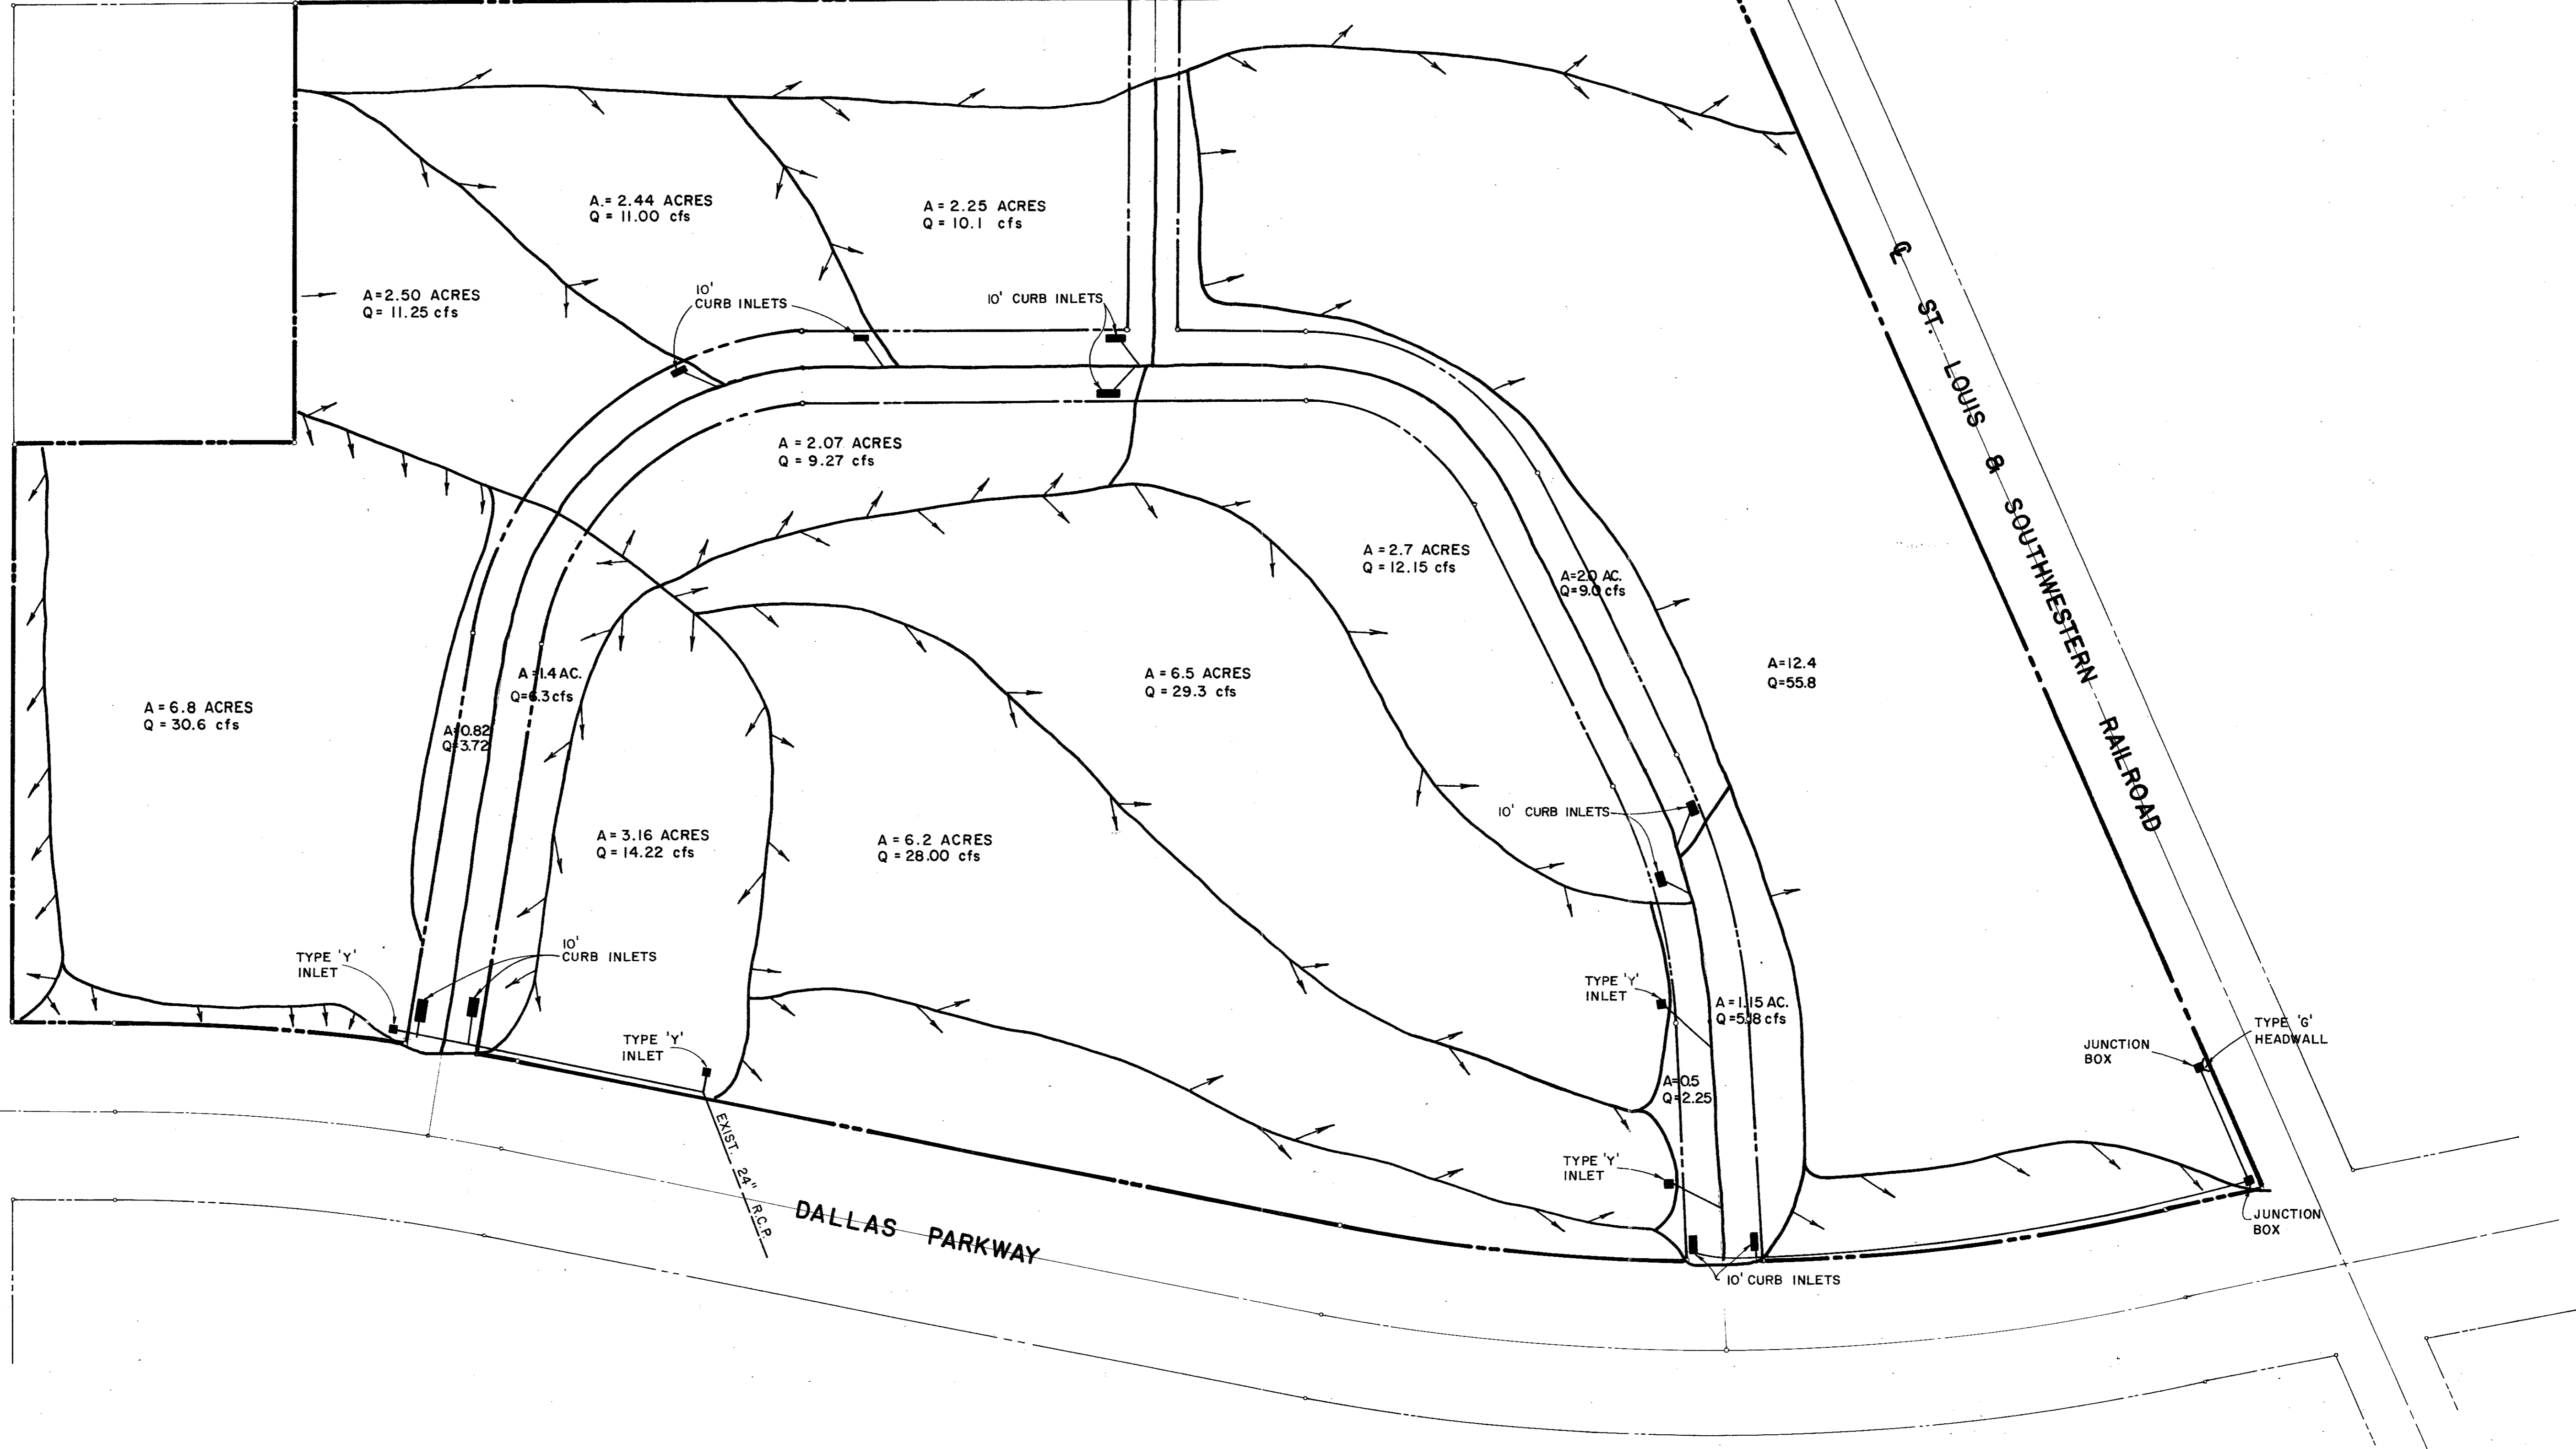

DRAINAGE PLAN

QUORUM NORTH
CITY OF ADDISON, TEXAS



SCALE: 1"=100'

REVISED TO CONFORM TO
CONSTRUCTION RECORDS:
BY K.A.B.
DATE 6-25-80

REVISED TO CONFORM TO
CONSTRUCTION RECORDS:
BY _____
DATE _____

Graham Associates, Inc.
CONSULTING ENGINEERS & PLANNERS