


SCALE: HORIZ. 1" = 40'  
VERT. 1" = 4'

BENCHMARKS:  
" □ " ON NOSE ISLAND SOUTH SIDE BELT LINE  
AT DALLAS PARKWAY ELEVATION 630.77  
WATER DEPARTMENT BENCHMARK ON INLET ON NORTH-  
WEST CORNER OF DALLAS PARKWAY & BELT LINE ROAD  
ELEVATION 632.10

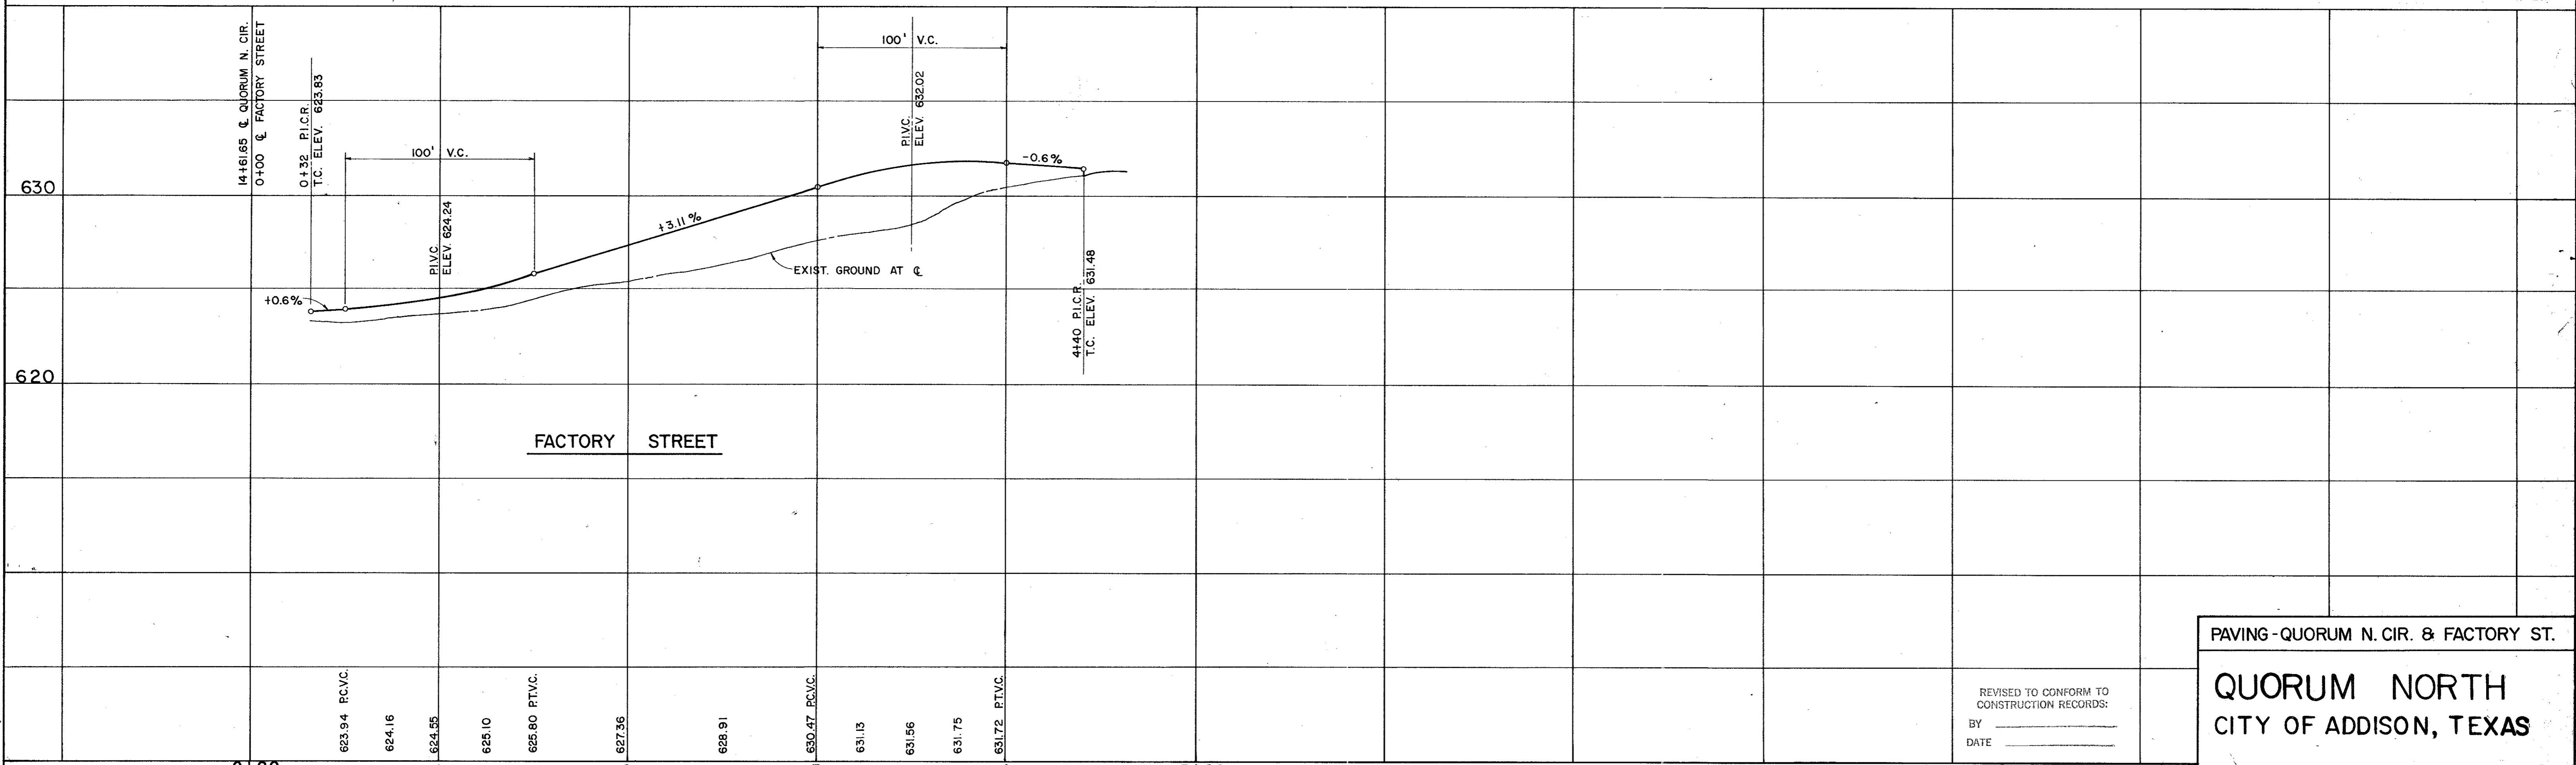

REVISED TO CONFORM TO  
CONSTRUCTION RECORDS:  
BY \_\_\_\_\_  
DATE \_\_\_\_\_

PAVING - QUORUM N. CIR. & FACTORY ST.

**QUORUM NORTH**  
CITY OF ADDISON, TEXAS

REVISED TO CONFORM TO  
CONSTRUCTION RECORDS:  
BY K.A.B.  
DATE 6-25-80

**Graham Associates, Inc.**  
CONSULTING ENGINEERS & PLANNERS

Date: 9-79  
File: 314-1441  
Drawn By: G.A.I. Sheet 7 of 19