


24 25+00 26

SCALE: HORIZ. 1" = 40'  
VERT. 1" = 4'

BENCHMARKS:  
" □ " ON NOSE ISLAND SOUTH SIDE BELT LINE  
AT DALLAS PARKWAY ELEVATION 630.77  
WATER DEPARTMENT BENCHMARK ON INLET ON NORTH-  
WEST CORNER OF DALLAS PARKWAY & BELT LINE ROAD  
ELEVATION 632.10

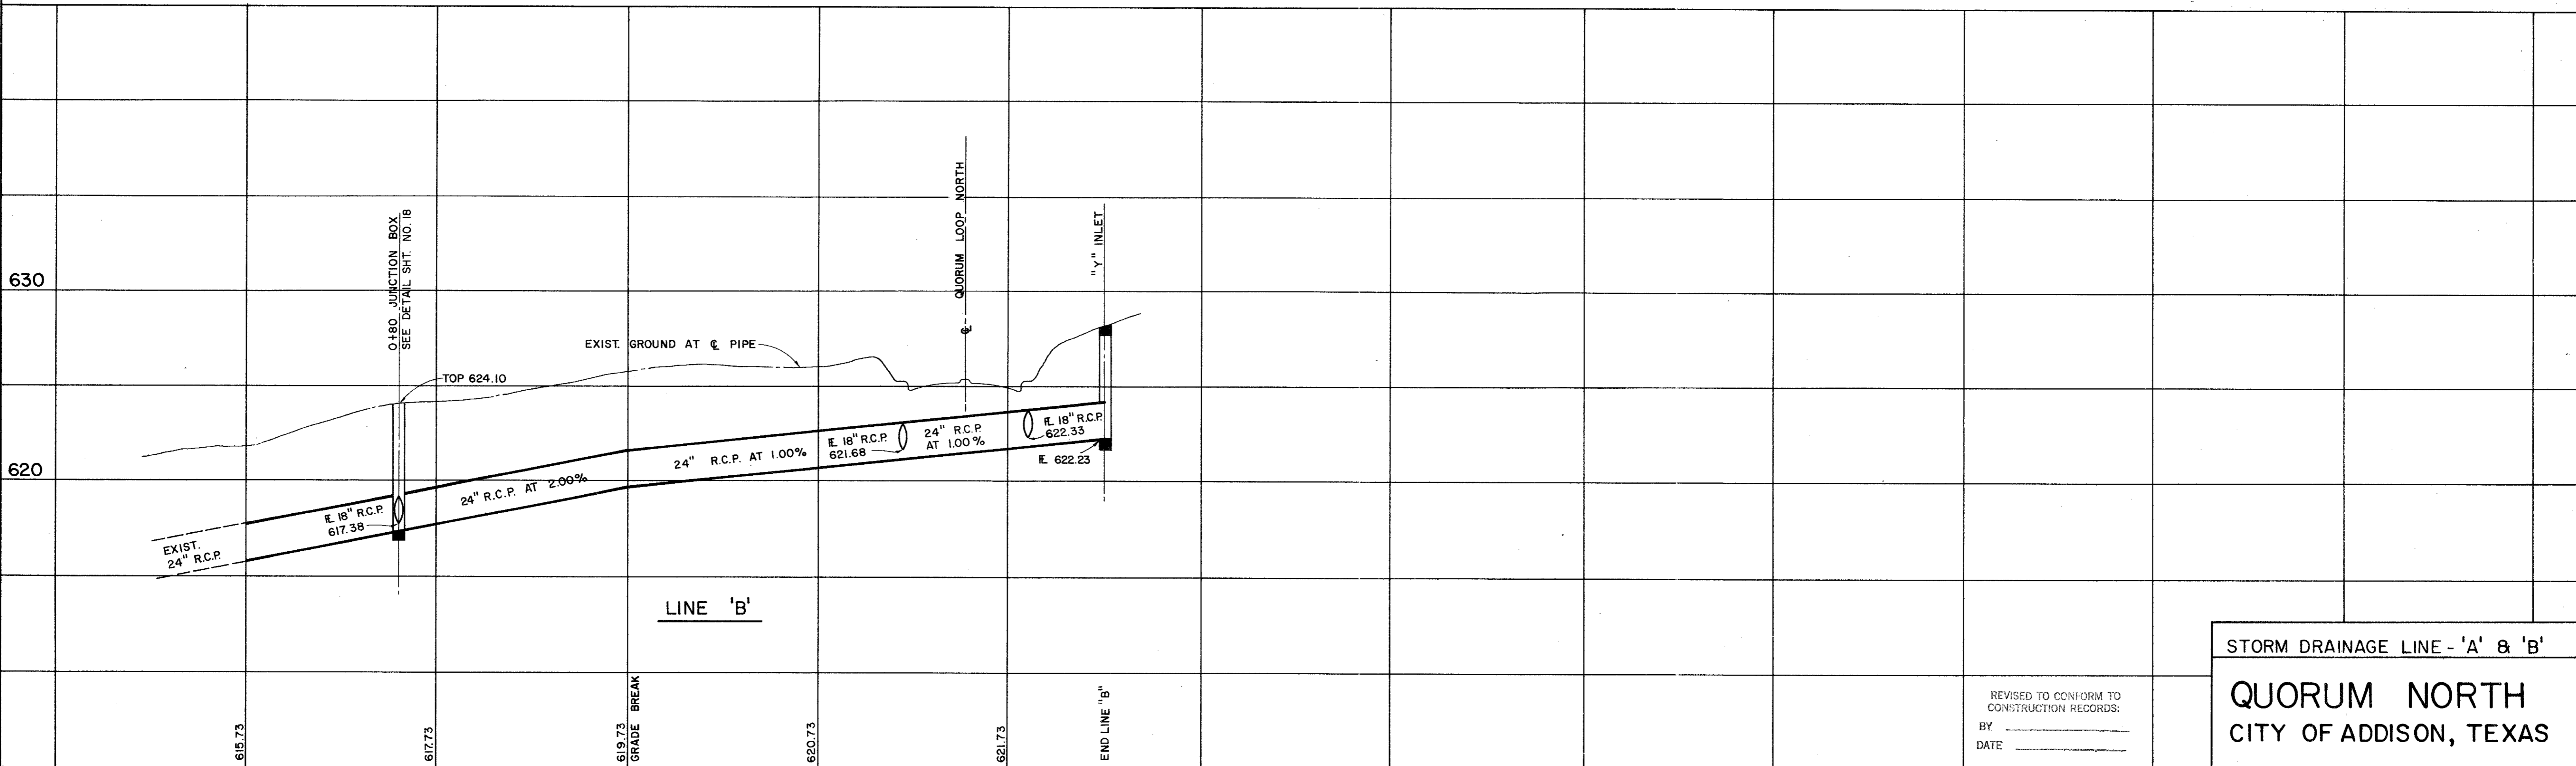

0+00 1 2 3 4 4+50 5+00 6 7 8

REVISED TO CONFORM TO  
CONSTRUCTION RECORDS:  
BY \_\_\_\_\_  
DATE \_\_\_\_\_

STORM DRAINAGE LINE - 'A' & 'B'  
**QUORUM NORTH**  
CITY OF ADDISON, TEXAS

REVISED TO CONFORM TO  
CONSTRUCTION RECORDS:  
BY K.A.O.  
DATE 6-25-80

**Graham Associates, Inc.**  
CONSULTING ENGINEERS & PLANNERS

Drawn By: G.A.I. Sheet 9 Of 19

Date 9-79  
File 314-1441