


0+00 602.31 602.48 602.66 602.83 603.01 603.18 603.36 603.53 603.71 603.88 604.06 604.25 604.55 604.85 605.15 605.45 605.75 606.05 606.35 606.65 606.45 607.25

SCALE: HORIZ. 1" = 40'
VERT. 1" = 4'

BENCHMARKS:
 " " ON NOSE ISLAND SOUTH SIDE BELT LINE AT DALLAS PARKWAY ELEVATION 630.77
 WATER DEPARTMENT BENCHMARK ON INLET OF NORTH-WEST CORNER OF DALLAS PARKWAY & BELT LINE ROAD ELEVATION 632.10

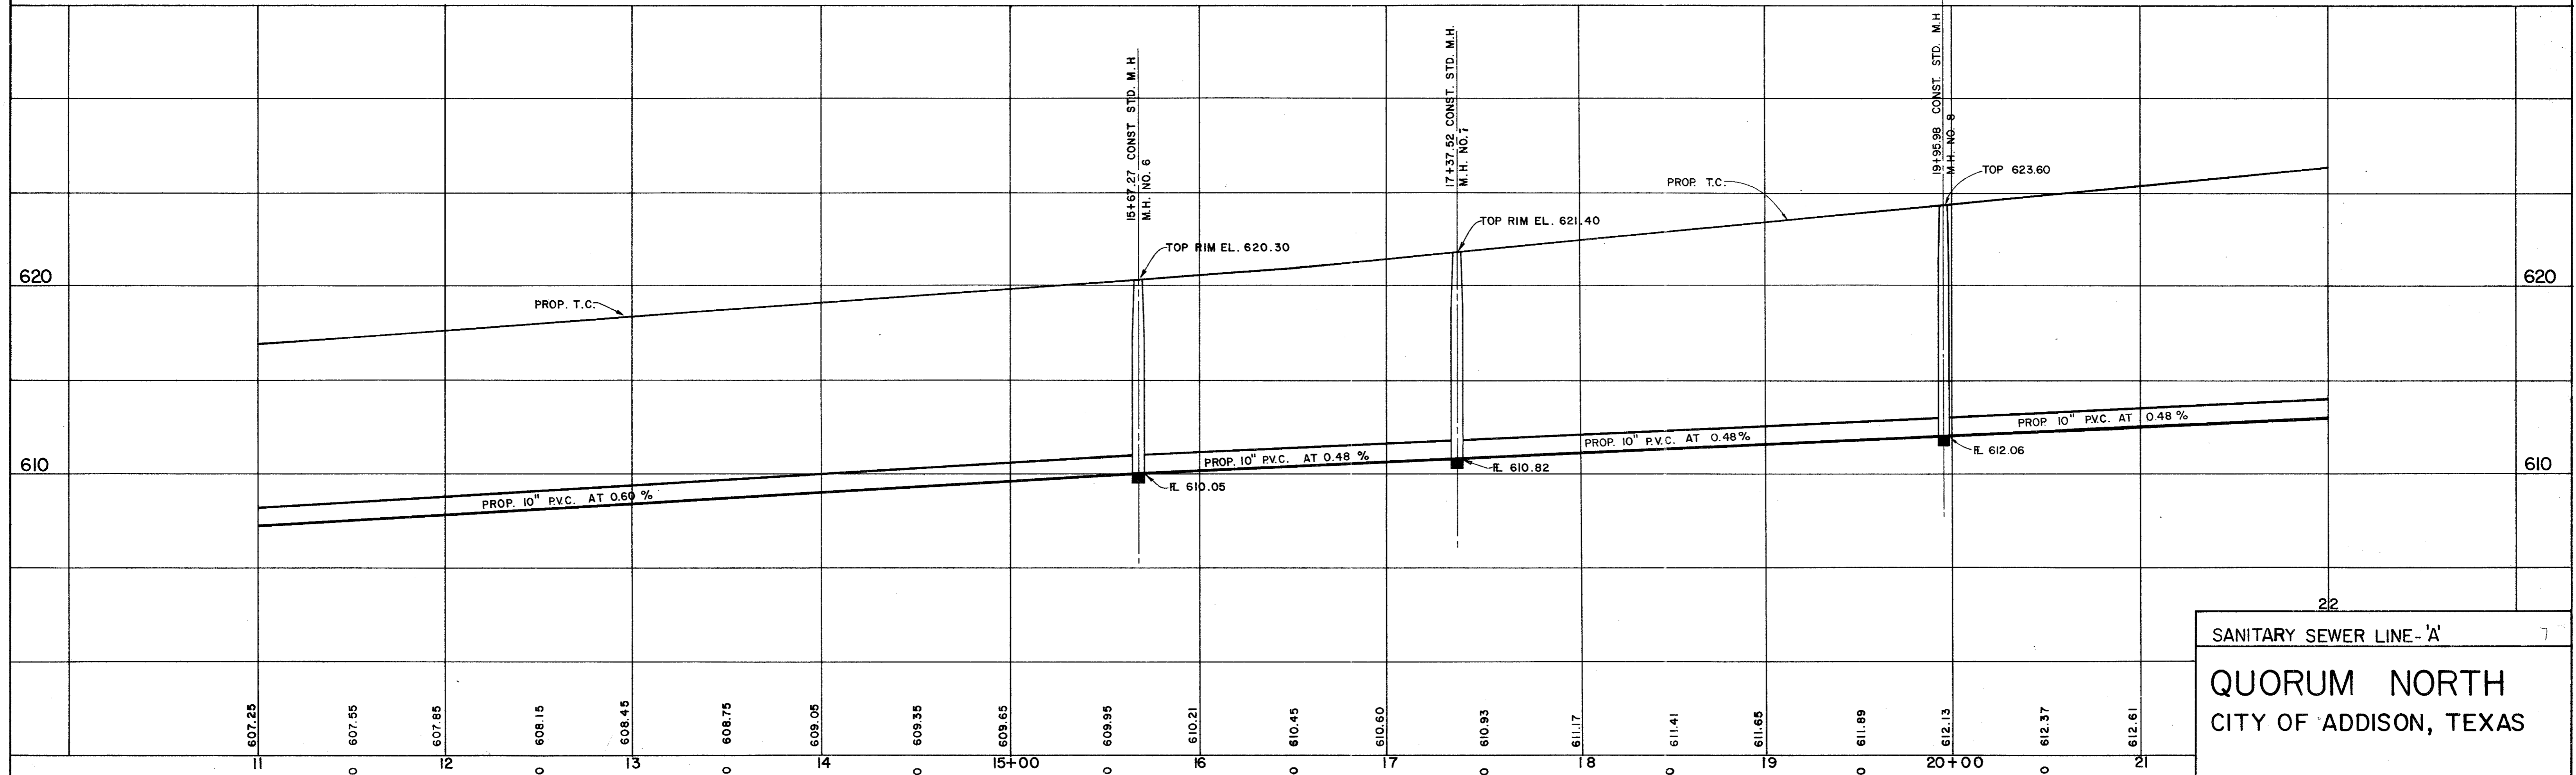

607.25 607.55 607.85 608.15 608.45 608.75 609.05 609.35 609.65 609.95 610.21 610.45 610.60 610.93 611.17 611.41 611.65 611.89 612.13 612.37 612.61

22
 SANITARY SEWER LINE - 'A'
 QUORUM NORTH
 CITY OF ADDISON, TEXAS

REVISED TO CONFORM TO CONSTRUCTION RECORDS:
 BY _____ DATE _____
 REVISED TO CONFORM TO CONSTRUCTION RECORDS:
 BY K.A.B. DATE 6-25-80

G **Graham Associates, Inc.**
 CONSULTING ENGINEERS & PLANNERS

Date 9-79
 File 314-1441