


22 615.09 150 23 615.57 150 24 614.05 150 25+00 614.48 150 26 614.68 150 27 615.28 150 28 615.68 150 29 616.08 150 30+00 616.47 150 31 616.62 150 32 617.07 150 33 617.22 150 34 617.67 150

BENCHMARKS:
 " □ " ON NOSE ISLAND SOUTH SIDE BELT LINE AT DALLAS PARKWAY ELEVATION 630.77
 WATER DEPARTMENT BENCHMARK ON INLET ON NORTH-WEST CORNER OF DALLAS PARKWAY & BELT LINE ROAD ELEVATION 632.10

SCALE: HORIZ. 1" = 40'
 VERT. 1" = 4'

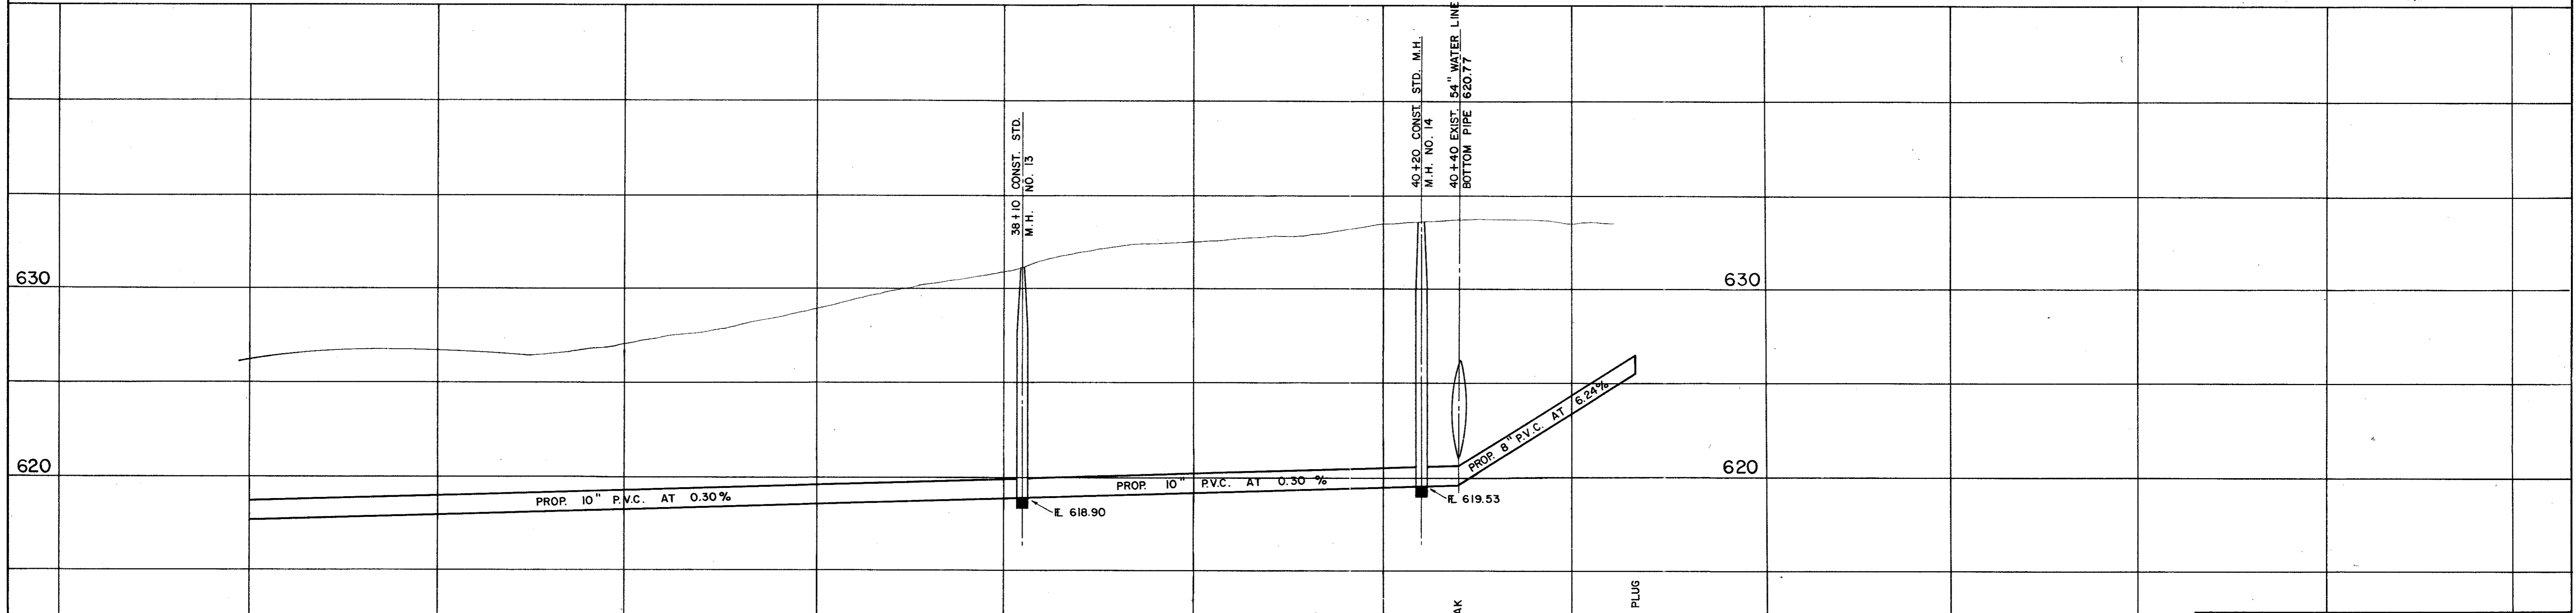

34 617.67 150 35 617.82 150 36 618.12 150 37 618.27 150 38 618.42 150 39 618.57 150 40 618.72 150 41 618.87 150 42 619.02 150 43 619.17 150 44 619.32 150 45 619.47 150 46 619.59 150 47 620.77 150 48 623.33 150 49 625.40 150

40+40 EXIST. 54" WATER LINE BOTTOM PIPE 620.77

REVISED TO CONFORM TO CONSTRUCTION RECORDS"
 BY K.A.B.
 DATE 6-25-80
 REVISED TO CONFORM TO CONSTRUCTION RECORDS:
 BY _____
 DATE _____
 Grade revision from 29+90.82 to end: 1-25-80

SANITARY SEWER LINE 'A'
QUORUM NORTH
CITY OF ADDISON, TEXAS

Graham Associates, Inc.
 CONSULTING ENGINEERS & PLANNERS

Date 9-79
 File 314-1441
 Drawn By: G.A.I. Sheet 12 Of 19