


SCALE: HORIZ. 1" = 40'
VERT. 1" = 4'

BENCHMARKS:
" \square " ON NOSE ISLAND SOUTH SIDE BELT LINE AT DALLAS PARKWAY ELEVATION 630.77
WATER DEPARTMENT BENCHMARK ON INLET ON NORTH-WEST CORNER OF DALLAS PARKWAY & BELT LINE ROAD ELEVATION 632.10

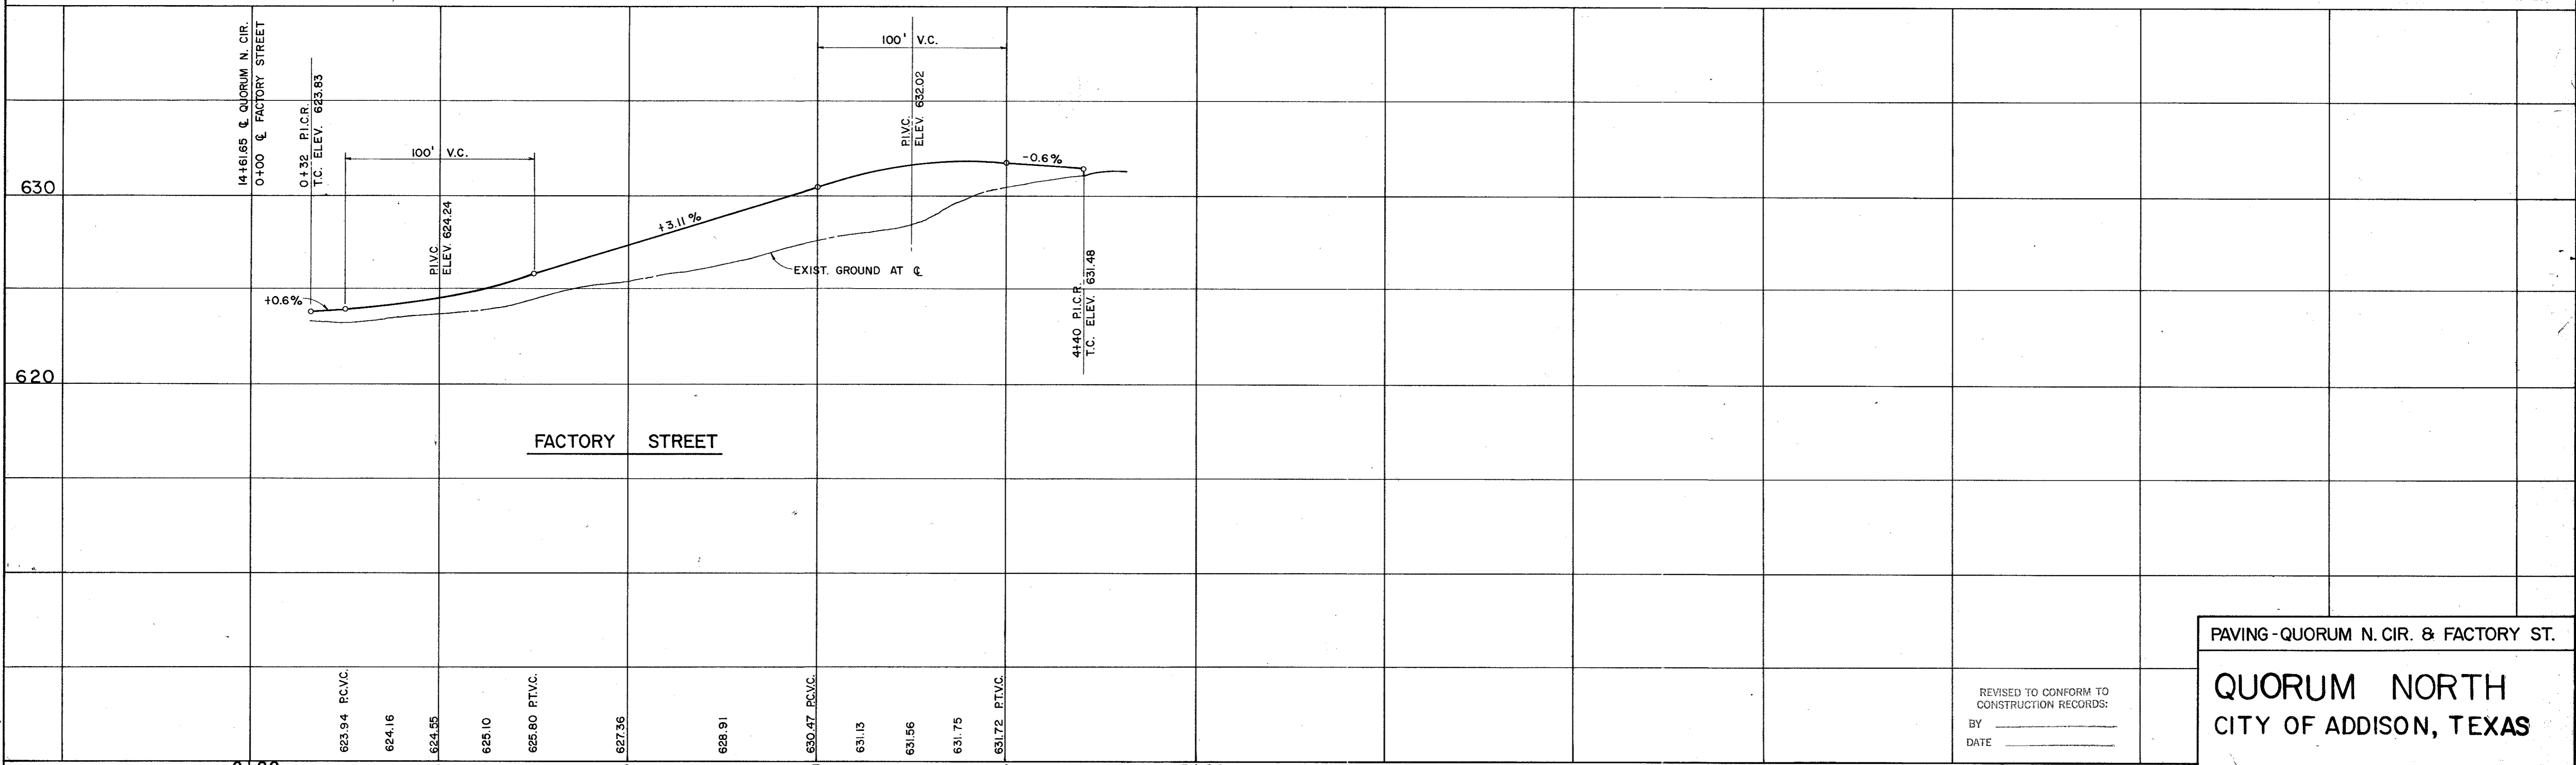

REVISED TO CONFORM TO CONSTRUCTION RECORDS:
BY _____
DATE _____

PAVING - QUORUM N. CIR. & FACTORY ST.

QUORUM NORTH
CITY OF ADDISON, TEXAS

REVISED TO CONFORM TO CONSTRUCTION RECORDS:
BY K.A.B.
DATE 6-25-80

G **Graham Associates, Inc.**
CONSULTING ENGINEERS & PLANNERS

Date 9-79
File 314-1441
Drawn By: G.A.I. Sheet 7 Of 19