


SCALE: HORIZ. 1" = 40'
VERT. 1" = 4'


BENCHMARKS:
 " □ " ON NOSE ISLAND SOUTH SIDE BELT LINE
 AT DALLAS PARKWAY ELEVATION 630.77
 WATER DEPARTMENT BENCHMARK ON INLET ON NORTH-
 WEST CORNER OF DALLAS PARKWAY & BELT LINE ROAD
 ELEVATION 632.10

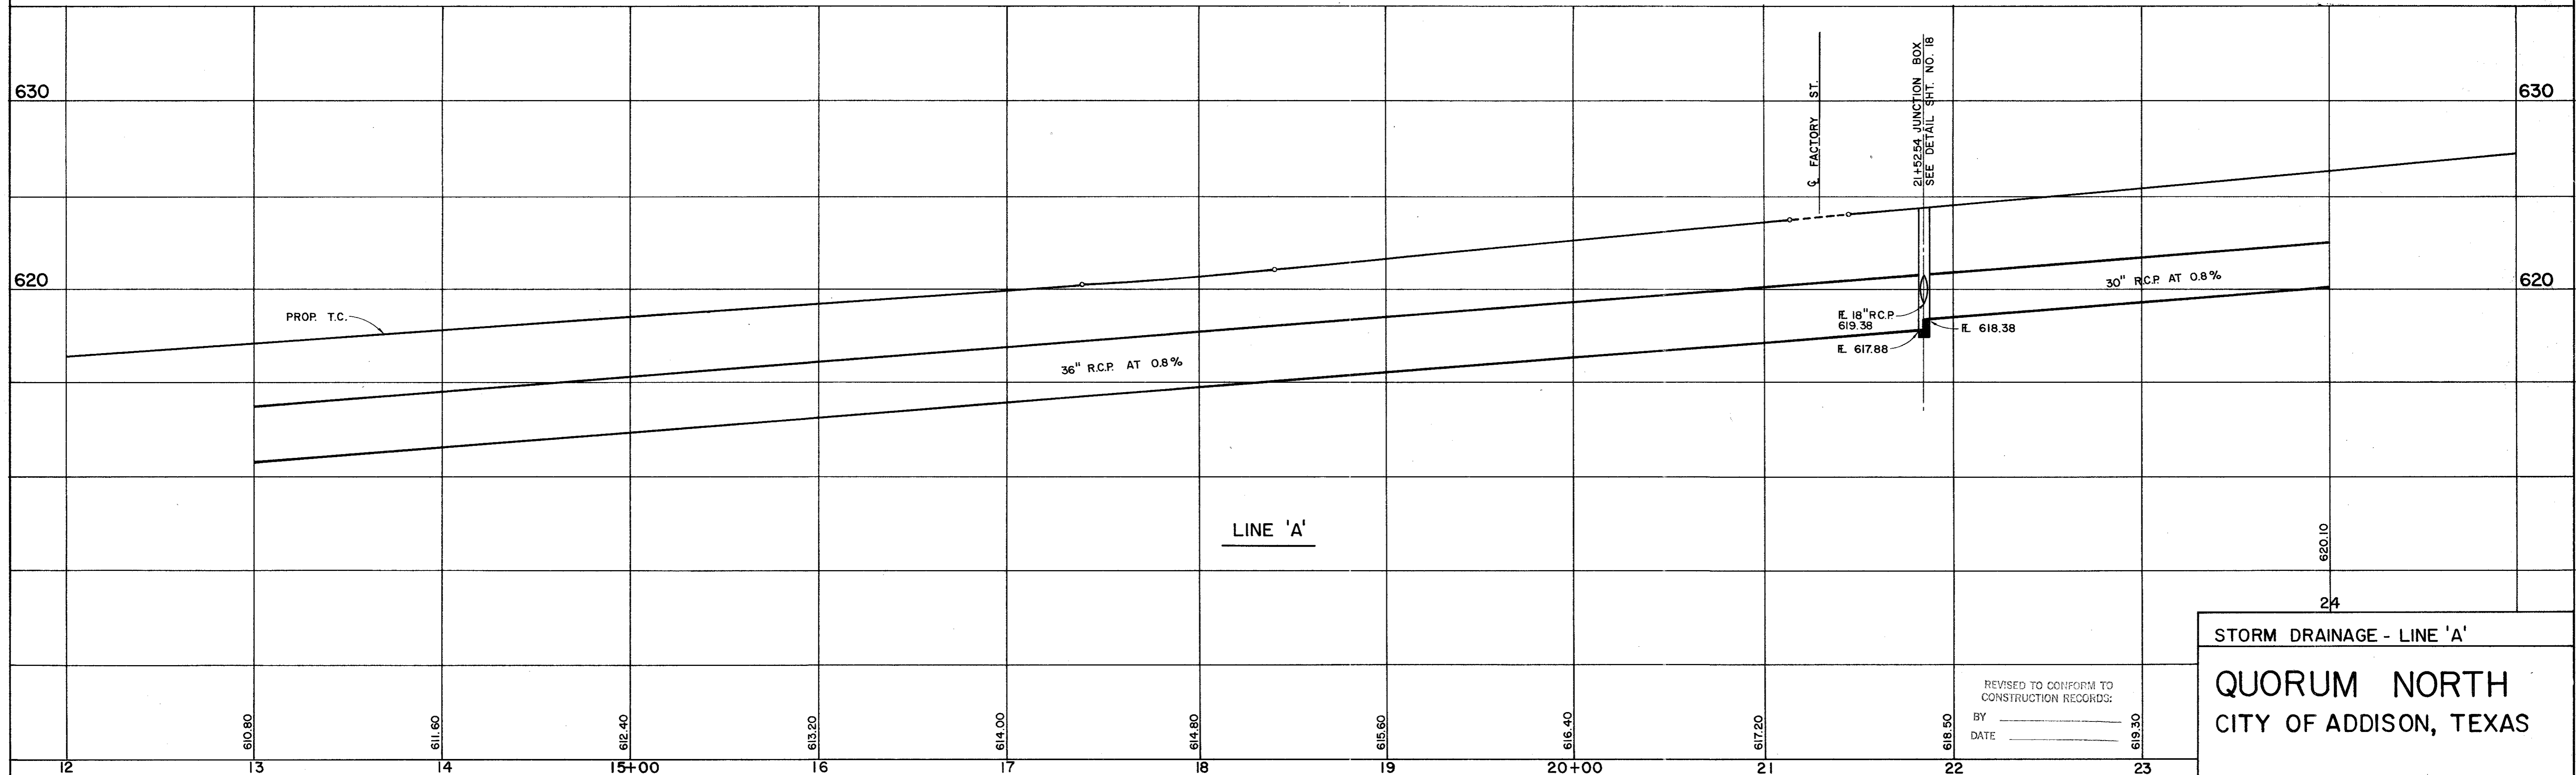

REVISED TO CONFORM TO
CONSTRUCTION RECORDS:
 BY _____
 DATE _____

STORM DRAINAGE - LINE 'A'
 QUORUM NORTH
 CITY OF ADDISON, TEXAS

REVISED TO CONFORM TO
CONSTRUCTION RECORDS:
 BY K. A. B.
 DATE 6-25-80


Graham Associates, Inc.
 CONSULTING ENGINEERS & PLANNERS
 Drawn By: G.A.I.

Date
9-79
File
314-1441