


24 25+00 26

SCALE: HORIZ. 1" = 40'
VERT. 1" = 4'

BENCHMARKS:
" □ " ON NOSE ISLAND SOUTH SIDE BELT LINE
AT DALLAS PARKWAY ELEVATION 630.77
WATER DEPARTMENT BENCHMARK ON INLET ON NORTH-
WEST CORNER OF DALLAS PARKWAY & BELT LINE ROAD
ELEVATION 632.10

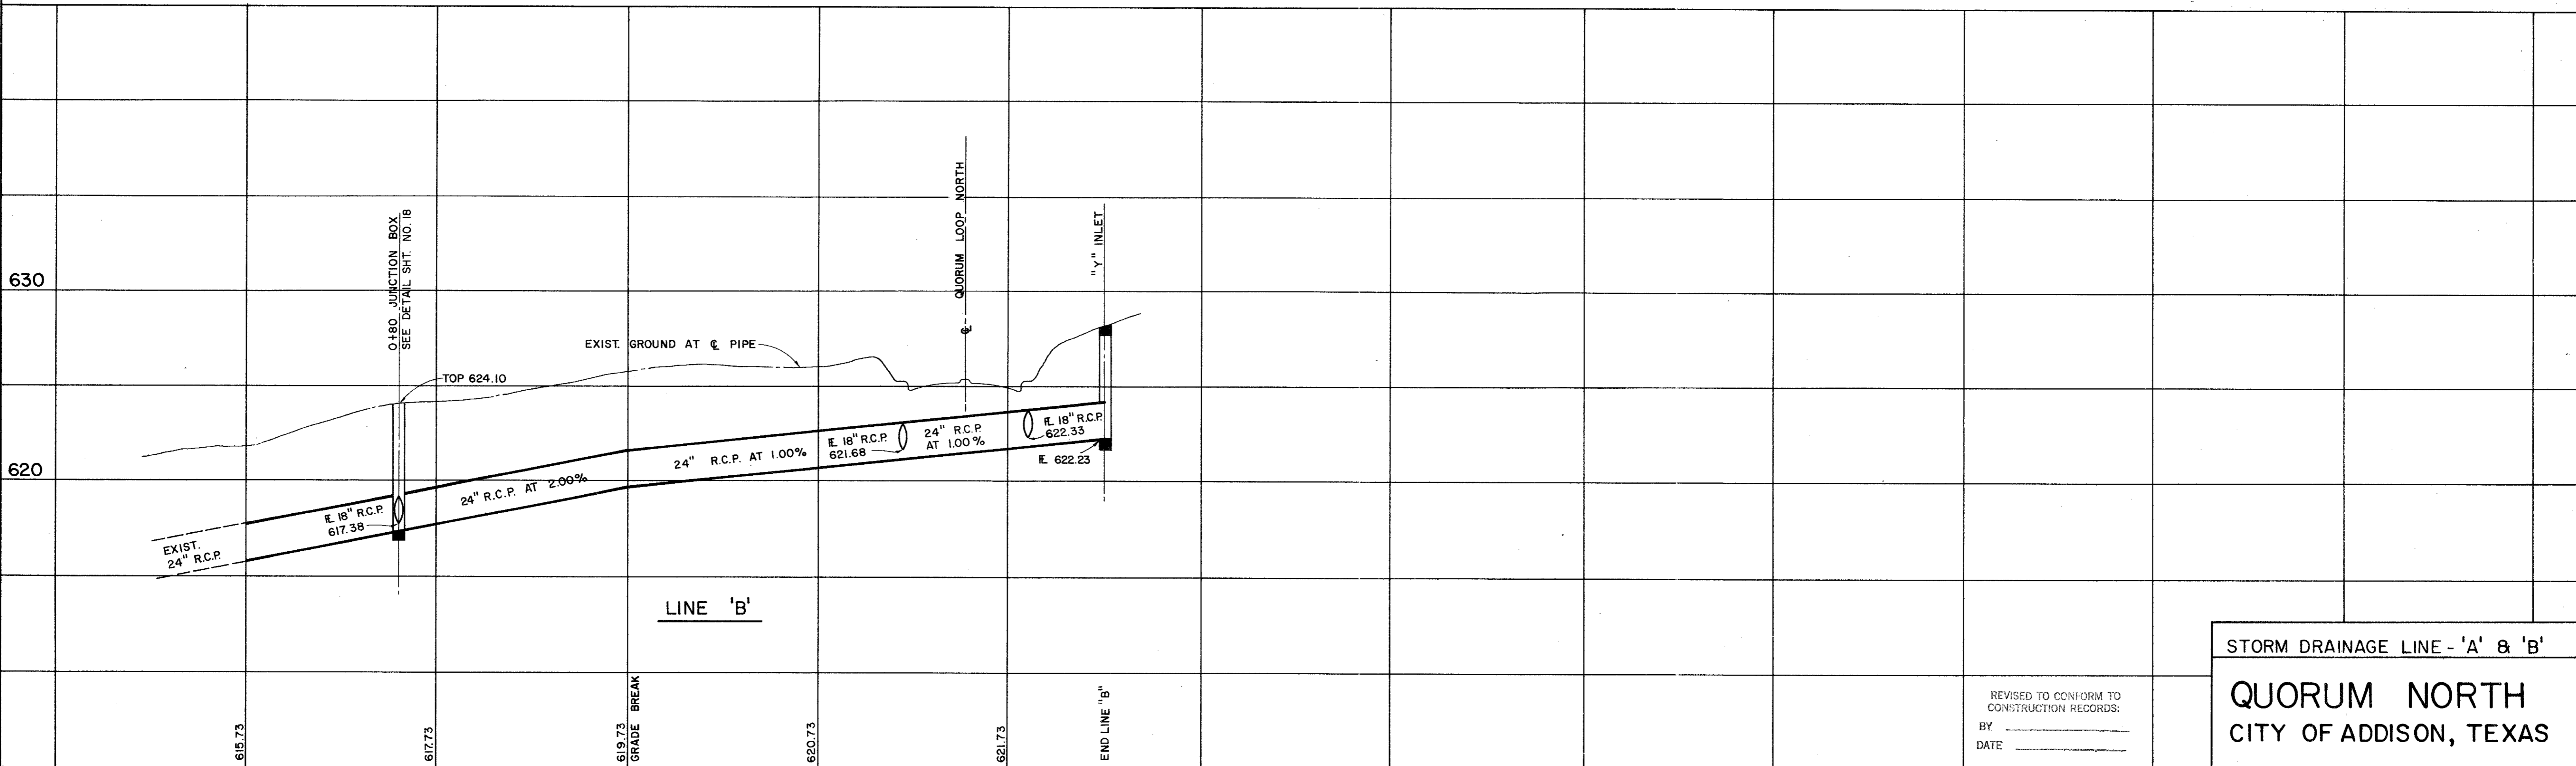

0+00 1 2 3 4 5+00 6 7 8

REVISED TO CONFORM TO
CONSTRUCTION RECORDS:
BY _____
DATE _____

STORM DRAINAGE LINE - 'A' & 'B'
QUORUM NORTH
CITY OF ADDISON, TEXAS

REVISED TO CONFORM TO
CONSTRUCTION RECORDS:
BY K.A.O.
DATE 6-25-80

Graham Associates, Inc.
CONSULTING ENGINEERS & PLANNERS

Drawn By: G.A.I. Sheet 9 Of 19

Date 9-79
File 314-1441