


B5-14

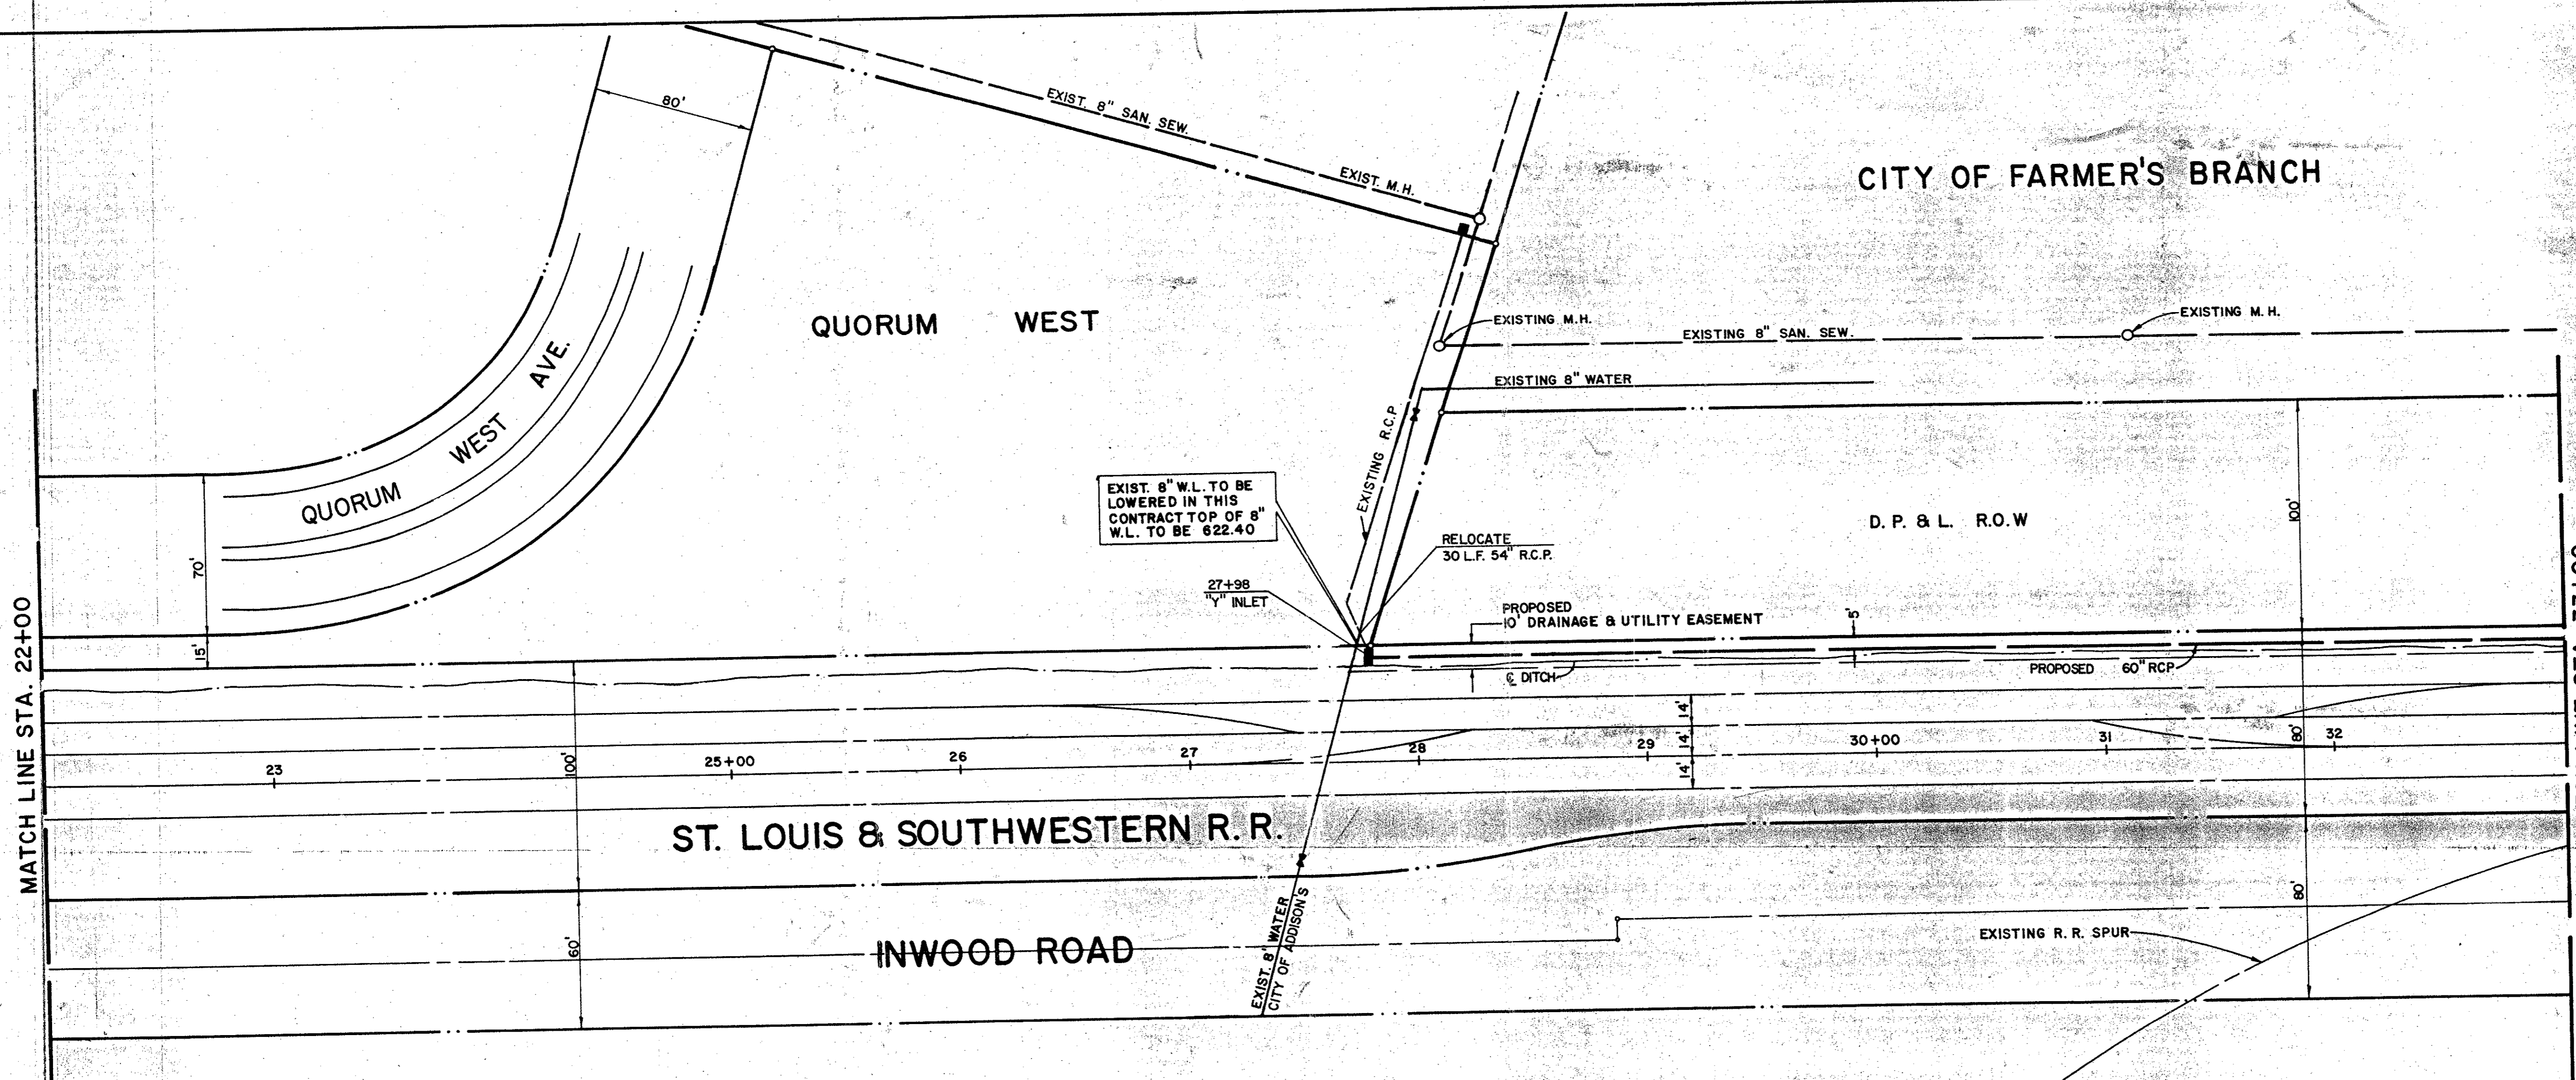


MATCH LINE STA. 33+00

MATCH LINE STA. 22+00

**AS BUILT PLAN**

SCALE: 1" = 40' HORZ.  
1" = 4' VERT.

BENCH MARK (648.97)  
ELEV. 650.69  
R.R. SPIKE IN POWER POLE IN THE SOUTH R.O.W.  
BELT LINE ROAD, 1,171.3' WEST OF Q. DALLAS PKWY.

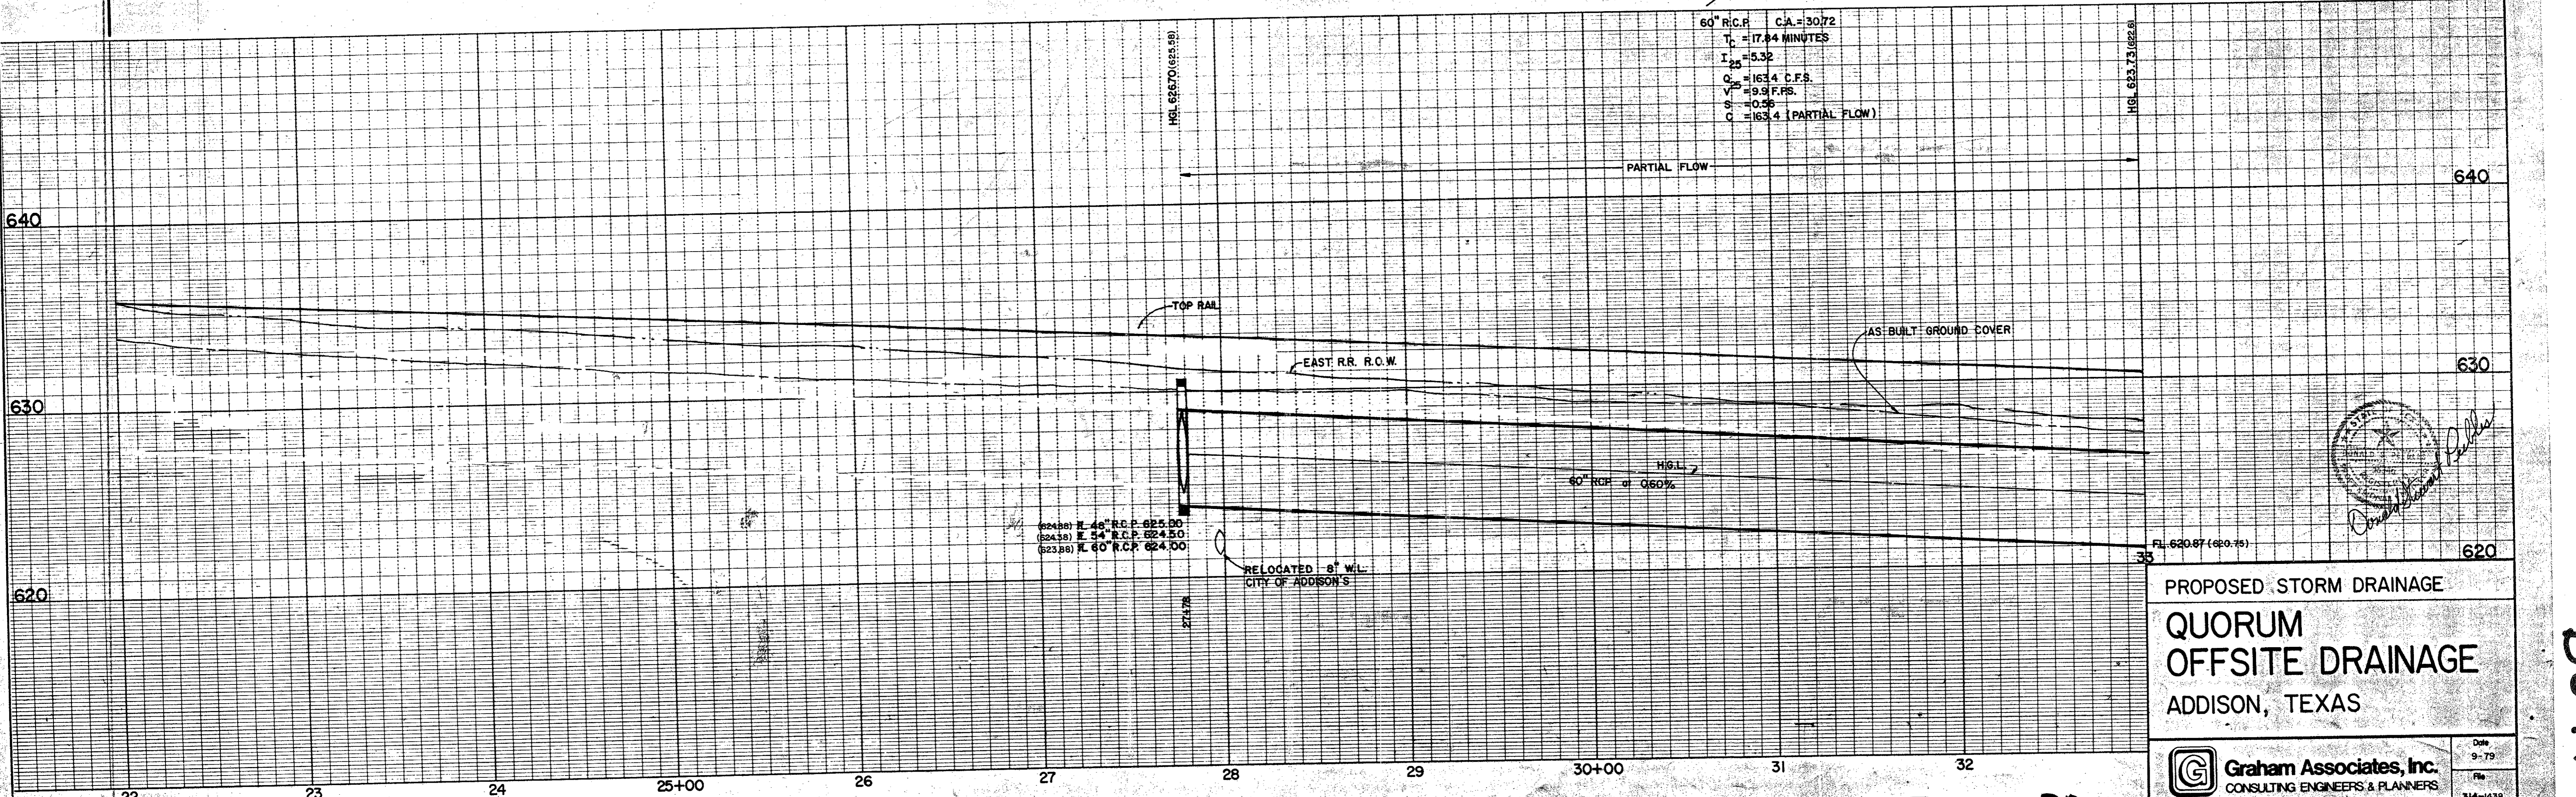

PROPOSED STORM DRAINAGE  
**QUORUM**  
**OFFSITE DRAINAGE**  
 ADDISON, TEXAS

**Graham Associates, Inc.**  
 CONSULTING ENGINEERS & PLANNERS

Date: 9-79  
 File: 314-1438  
 Drawn By: G.A.I. Sheet 1 Of 4

F-299-PD

B5-14