

H:\PROJ\01340801\ADDISON\340801\340801.DWG
 The Job is 09.25.07 2009
 H:\PROJ\01340801\ADDISON\340801\340801.DWG

P:\PROJ\01340801\ADDISON\340801\340801.DWG
 The Job is 09.25.07 2009
 H:\PROJ\01340801\ADDISON\340801\340801.DWG

P:\PROJ\01340801\ADDISON\340801\340801.DWG
 The Job is 09.25.07 2009
 H:\PROJ\01340801\ADDISON\340801\340801.DWG

P:\PROJ\01340801\ADDISON\340801\340801.DWG
 The Job is 09.25.07 2009
 H:\PROJ\01340801\ADDISON\340801\340801.DWG


P:\PROJ\01340801\ADDISON\340801\340801.DWG
 The Job is 09.25.07 2009
 H:\PROJ\01340801\ADDISON\340801\340801.DWG

City Homes

- BENCHMARKS:**
- BM*5
"□" CUT ON 8" INLET ON NORTH CURB LINE OF GOODMAN AVE. +75' EAST OF PASCHAL PLACE. ELEV. 629.98
 - BM*6
"□" CUT AT C OF 8" INLET AT THE SOUTHWEST CORNER OF MORRIS AVE. AND WITT PLACE. ELEV. 627.29
 - BM*7
"□" CUT AT WEST CORNER OF ADDISON THEATRE CENTRE PARKING LOT, SECOND ENTRANCE NORTH OF ADDISON RD. ELEV. 637.66

STREET NAME SIGNS		
SIGN NO./LOCATION	STREET NAME	MOUNTING
1	MARCUS AVENUE QUORUM DRIVE	NEW SIGN POLE

NOTE:
EXACT SIGNAGE PLACEMENT TO BE DETERMINED IN THE FIELD BASED ON VISIBILITY CONCERNS.

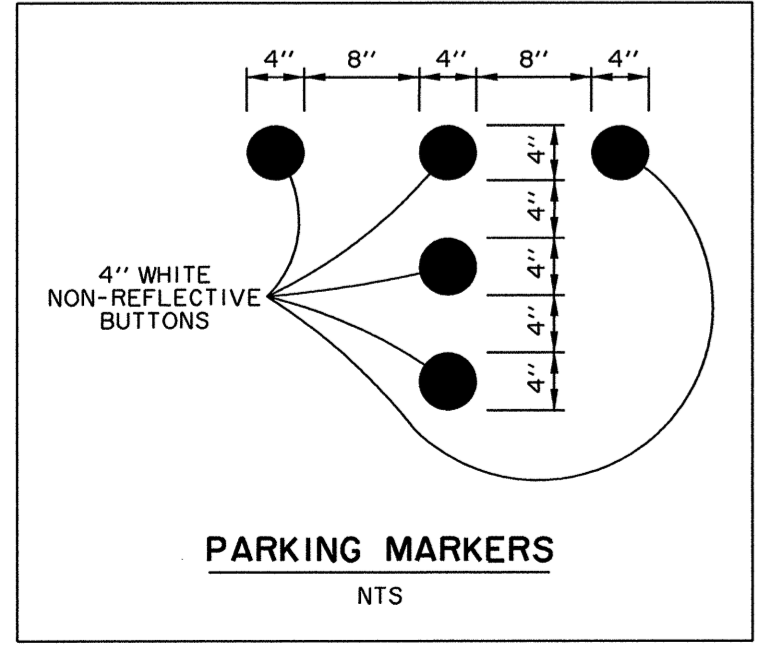

RECORD DRAWING

THIS DRAWING HAS BEEN MODIFIED FROM THE ORIGINAL TO SHOW ONLY THE FIELD CHANGES AND ADJUSTMENTS MADE DURING CONSTRUCTION BY THE CONTRACTOR WHICH WERE DOCUMENTED AND FURNISHED TO THE ENGINEER FOR THE PURPOSE OF PREPARING THESE RECORD DRAWINGS. FIELD INSPECTION OF CONSTRUCTION WAS PERFORMED BY OTHERS. TO THE BEST OF OUR KNOWLEDGE AND UNDERSTANDING THESE RECORD DRAWINGS REPRESENT THE "AS-BUILT" CONDITIONS.

SIGNAGE AND STRIPING PLAN							
QUORUM DRIVE							
TOWN OF ADDISON, TEXAS							
<small>Huff - Zolters, Inc. 3131 McKinney Ave., Suite 500, Dallas, TX 75204 Phone (214) 871-3311/Fax (214) 871-0757</small>							
DESIGN	CHECKED	APPR.	SCALE	DATE	PROJECT NO.	NO.	
HZ1	HZ1		1"=20'	01/15/09		C4	