


REVISED TO CONFORM TO
CONSTRUCTION RECORDS:
BY *KA*
DATE *8/1/80*

SCALE:
HORIZ. : 1" = 40'
VERT. : 1" = 4'




SECTION A-A
MODIFIED "Y" INLET
SCALE: 1/2" = 1'
SEE SHEET II LINE "D"

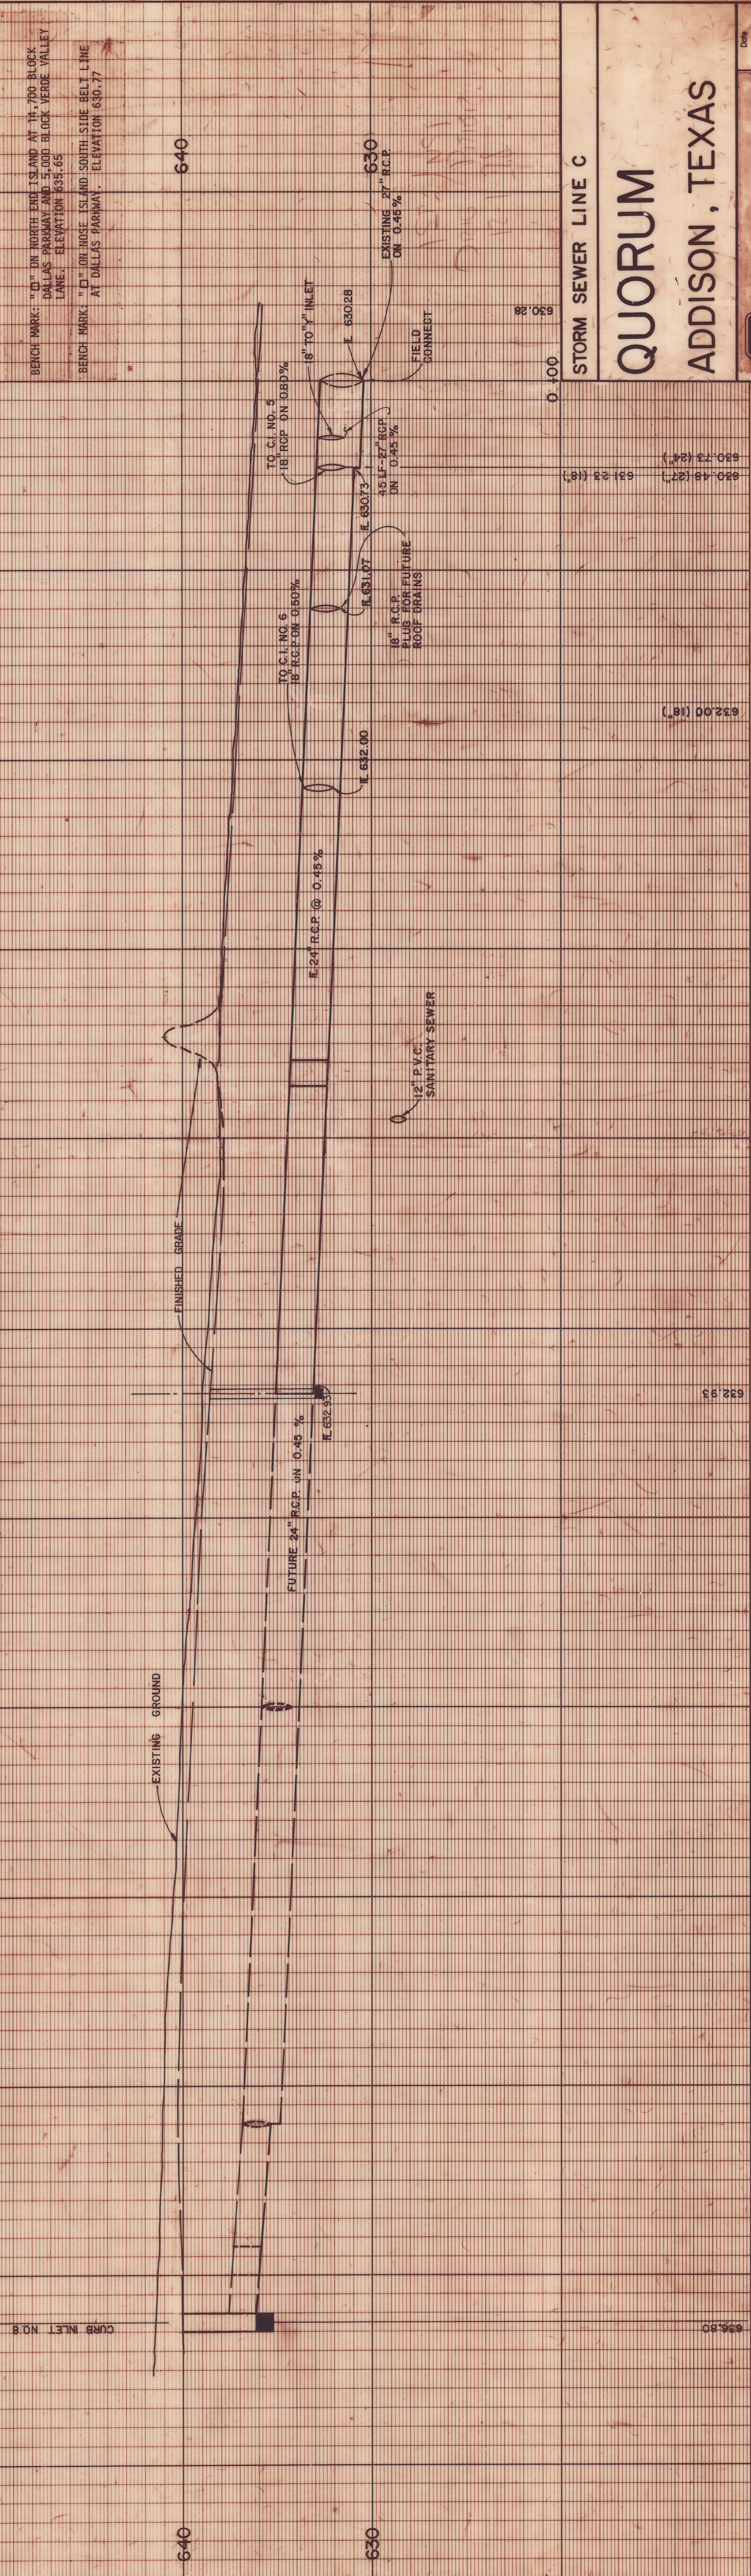

BENCH MARK: "D" ON NORTH END ISLAND AT 14,700 BLOCK
DALLAS PARKWAY AND 5,000 BLOCK VERDE VALLEY
LANE. ELEVATION 835.65
BENCH MARK: "D1" ON HOPE ISLAND SOUTH SIDE BELT LINE
AT DALLAS PARKWAY. ELEVATION 830.77

STORM SEWER LINE C

QUORUM
ADDISON, TEXAS

Drawn By: G.A.C. Staff 10 of 11

Graham Associates, Inc.
 CONSULTING ENGINEERS & PLANNERS
 Date: 3-1-79
 Pk: 74
 314-1437