



LINE - "B" - PROFILE

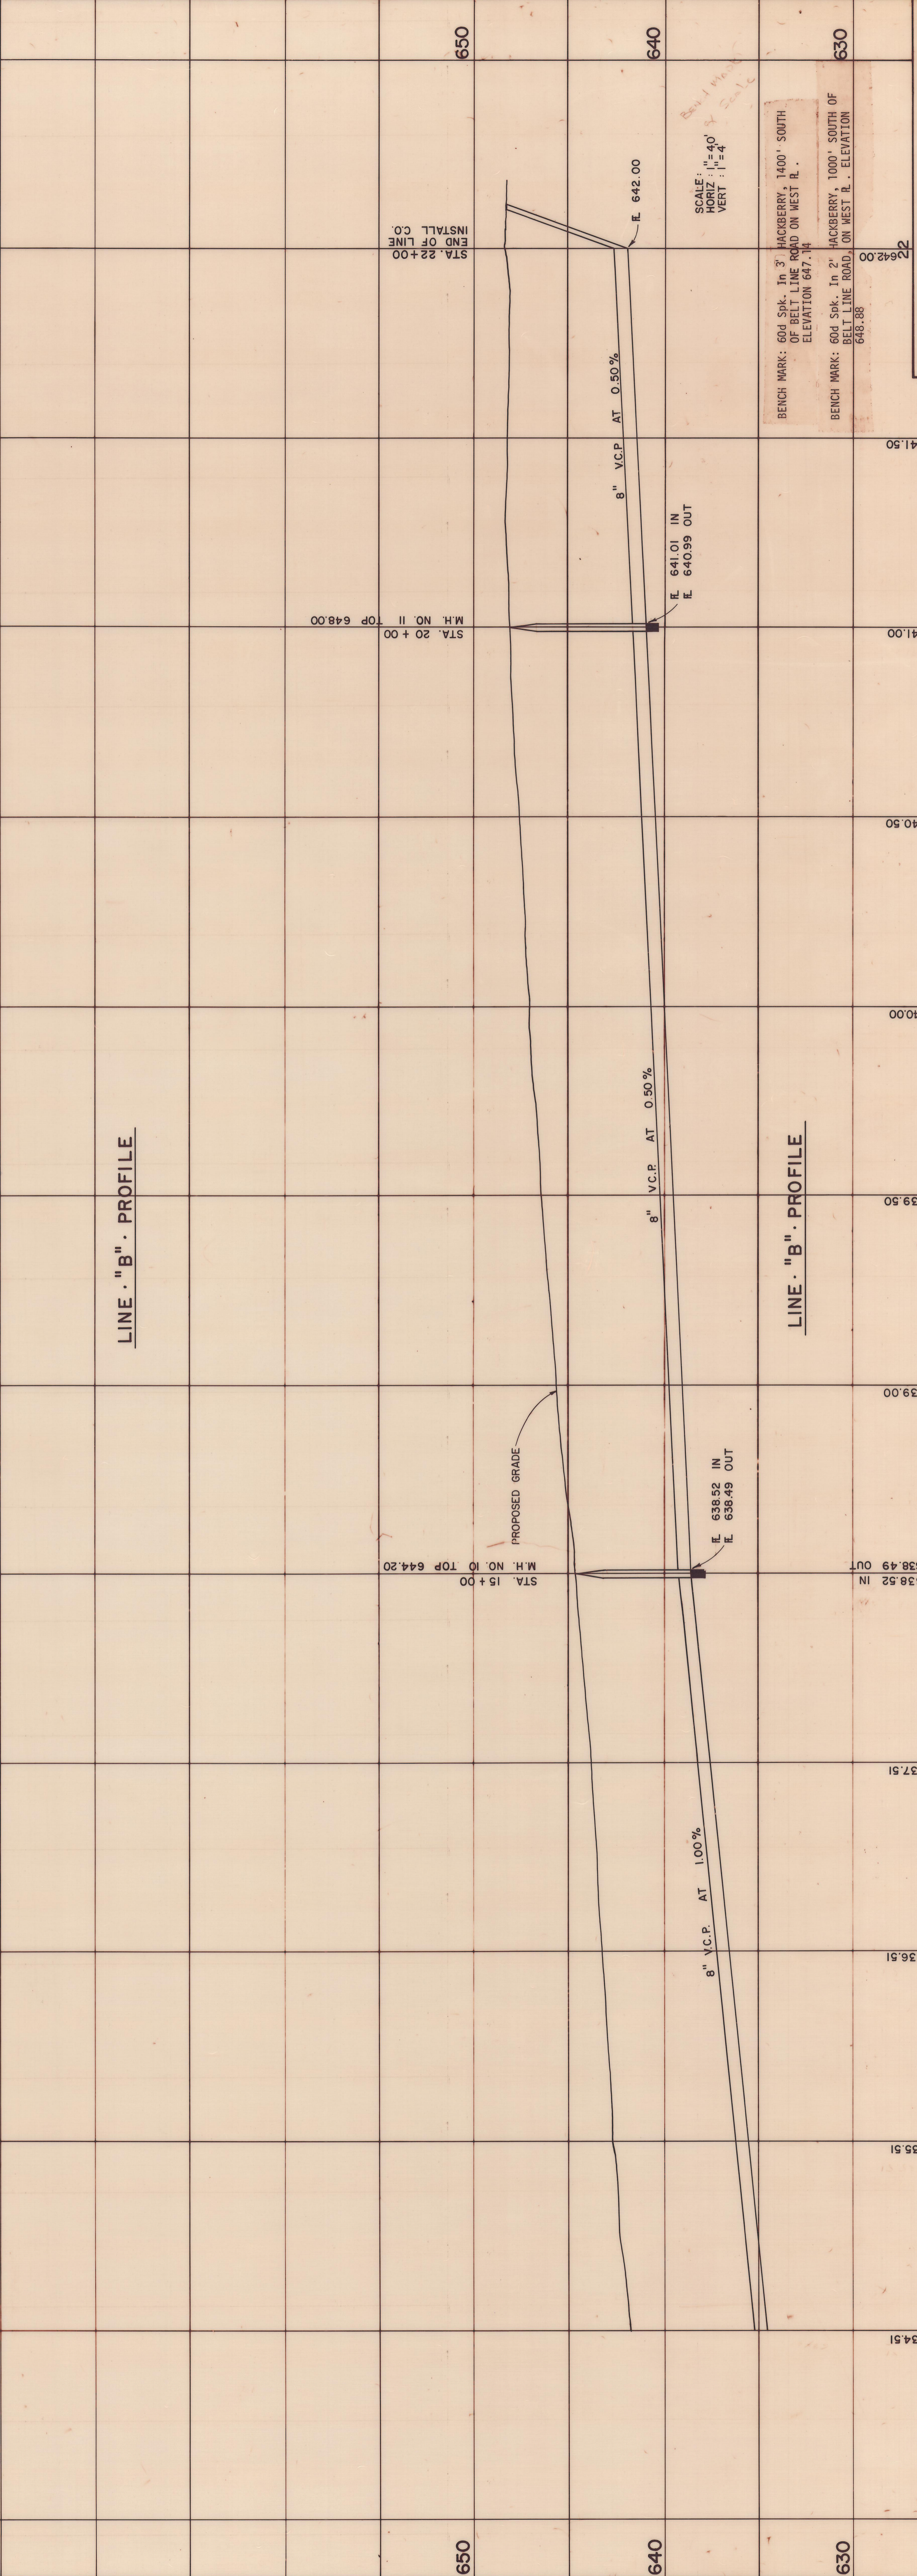

LINE - "B" - PROFILE

SANITARY SEWER - LINE "B"  
**QUORUM**  
 ADDISON, TEXAS


**Graham Associates, Inc.**  
 CONSULTING ENGINEERS & PLANNERS  
 Date: 3-1-79  
 File: 314-1437  
 Sheet: 13 of 22

REVISOR TO CONFORM TO  
 CONSTRUCTION RECORDS:  
 BY: *RH*  
 DATE: 8/6/80

SCALE:  $\frac{1"}{40'}$   
 HORIZ.  $\frac{1"}{40'}$   
 VERT.  $\frac{1"}{4'}$

BENCH MARK: 604 Spk. In 3' HACKBERRY, 1400' SOUTH  
 OF BELT LINE ROAD ON WEST R.L.  
 ELEVATION 647.14

BENCH MARK: 604 Spk. In 2' HACKBERRY, 1000' SOUTH OF  
 BELT LINE ROAD ON WEST R.L. ELEVATION  
 648.88

STA. 22+00  
 END OF LINE  
 INSTALL C.O.

STA. 20+00  
 M.H. NO. 11  
 TOP 648.00

STA. 15+00  
 M.H. NO. 10  
 TOP 644.20

STA. 10+00  
 M.H. NO. 9  
 TOP 639.70

STA. 5+00  
 M.H. NO. 8  
 TOP 634.50

STA. 21+00  
 M.H. NO. 12  
 TOP 642.00

STA. 20+00  
 M.H. NO. 11  
 TOP 648.00

STA. 15+00  
 M.H. NO. 10  
 TOP 644.20

STA. 0+00  
 M.H. NO. 1