




TYPICAL THRUST BLOCK DETAILS

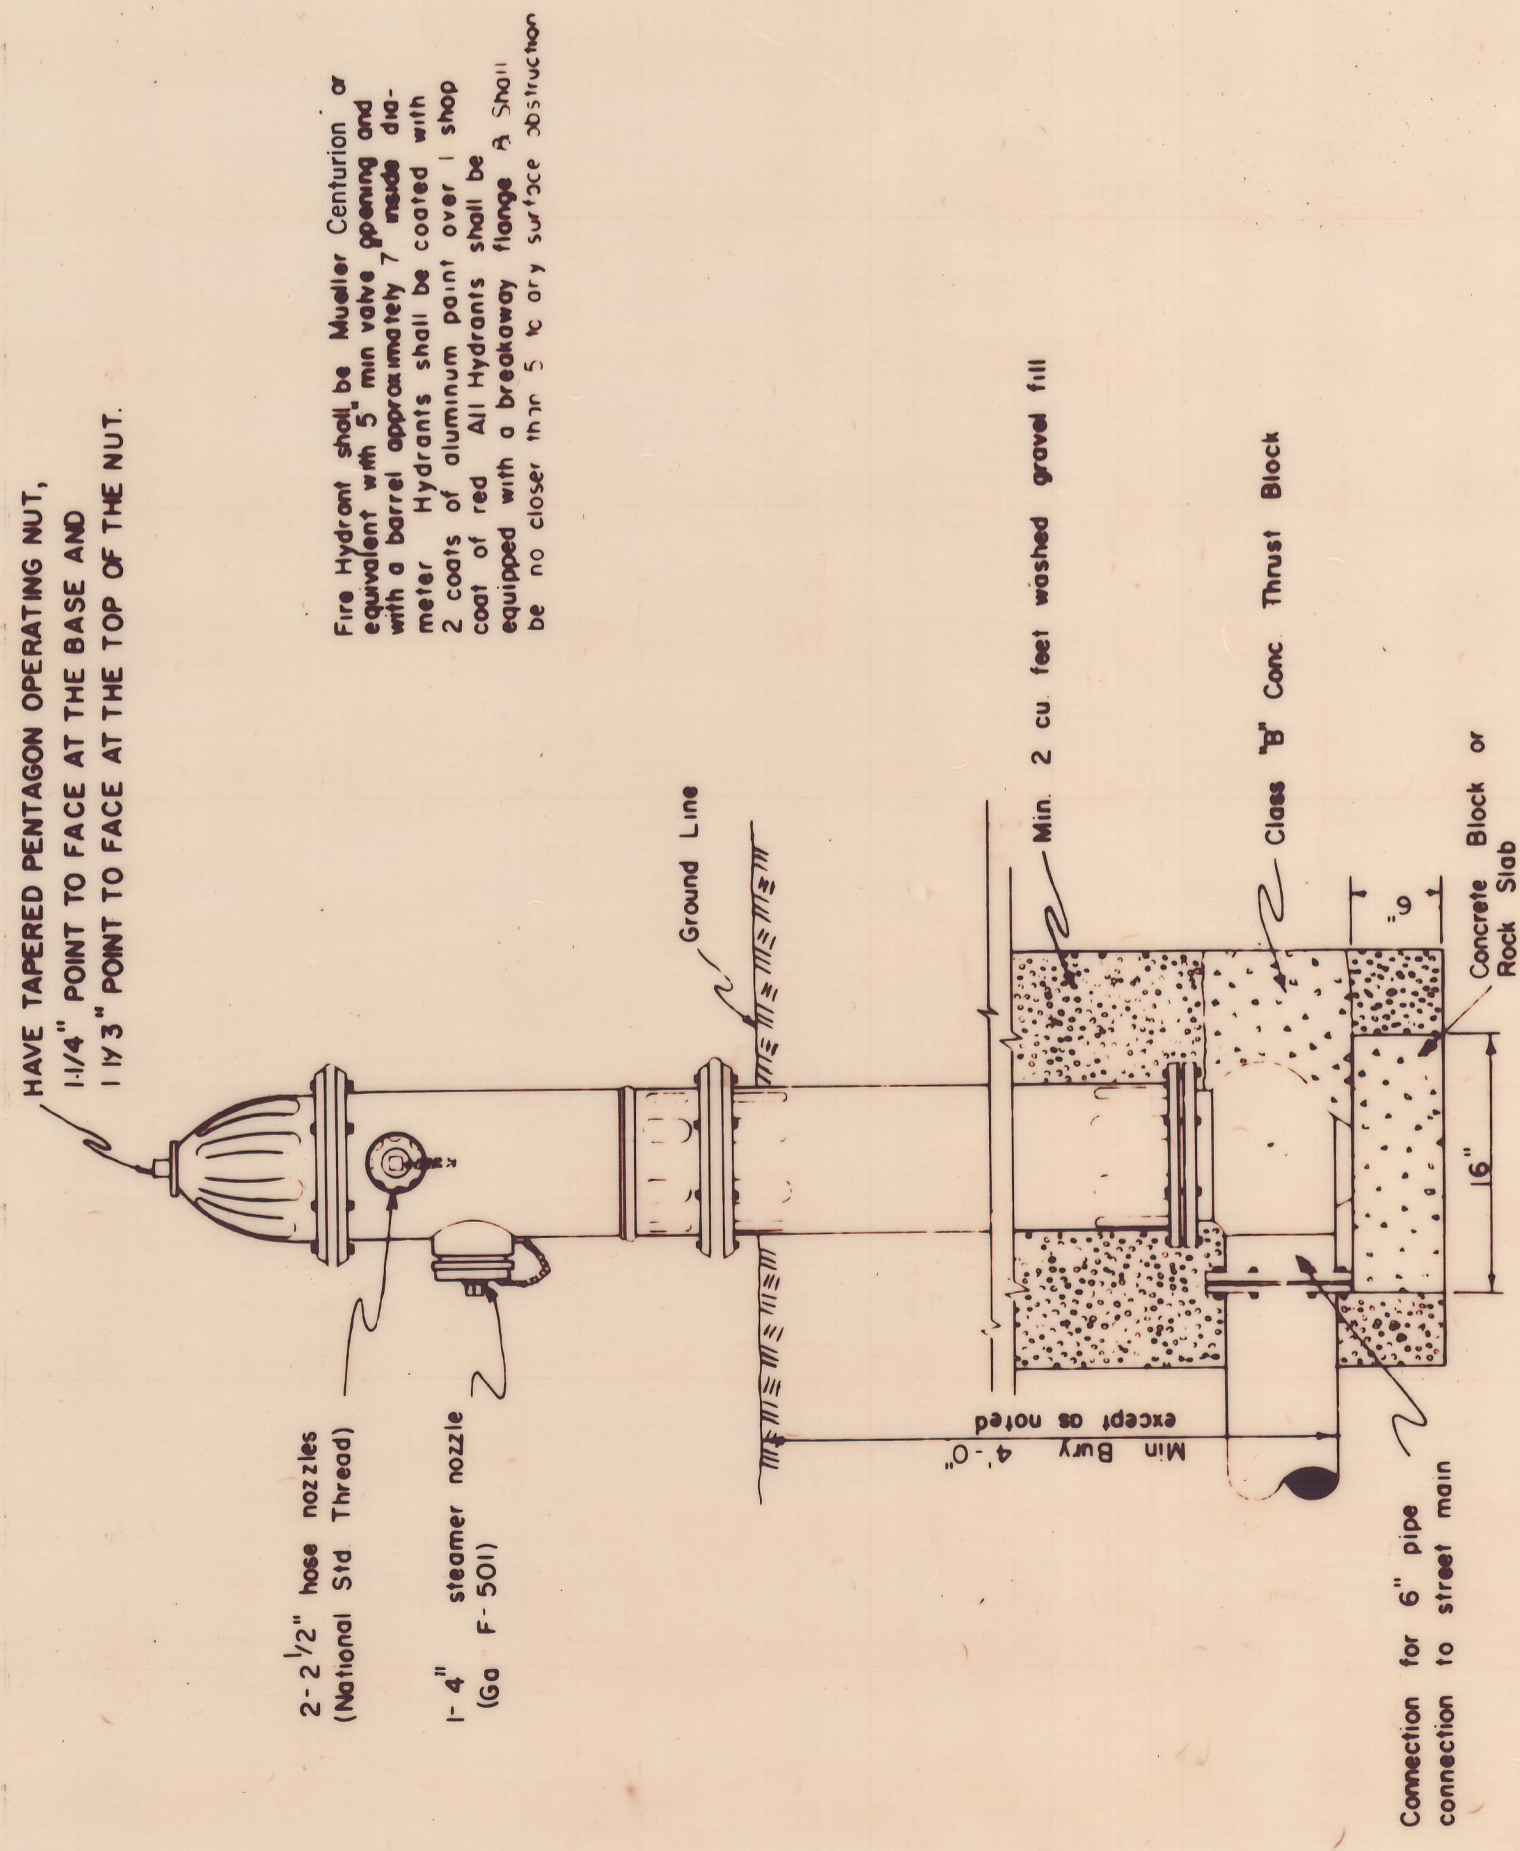

TYPICAL FIRE HYDRANT INSTALLATION

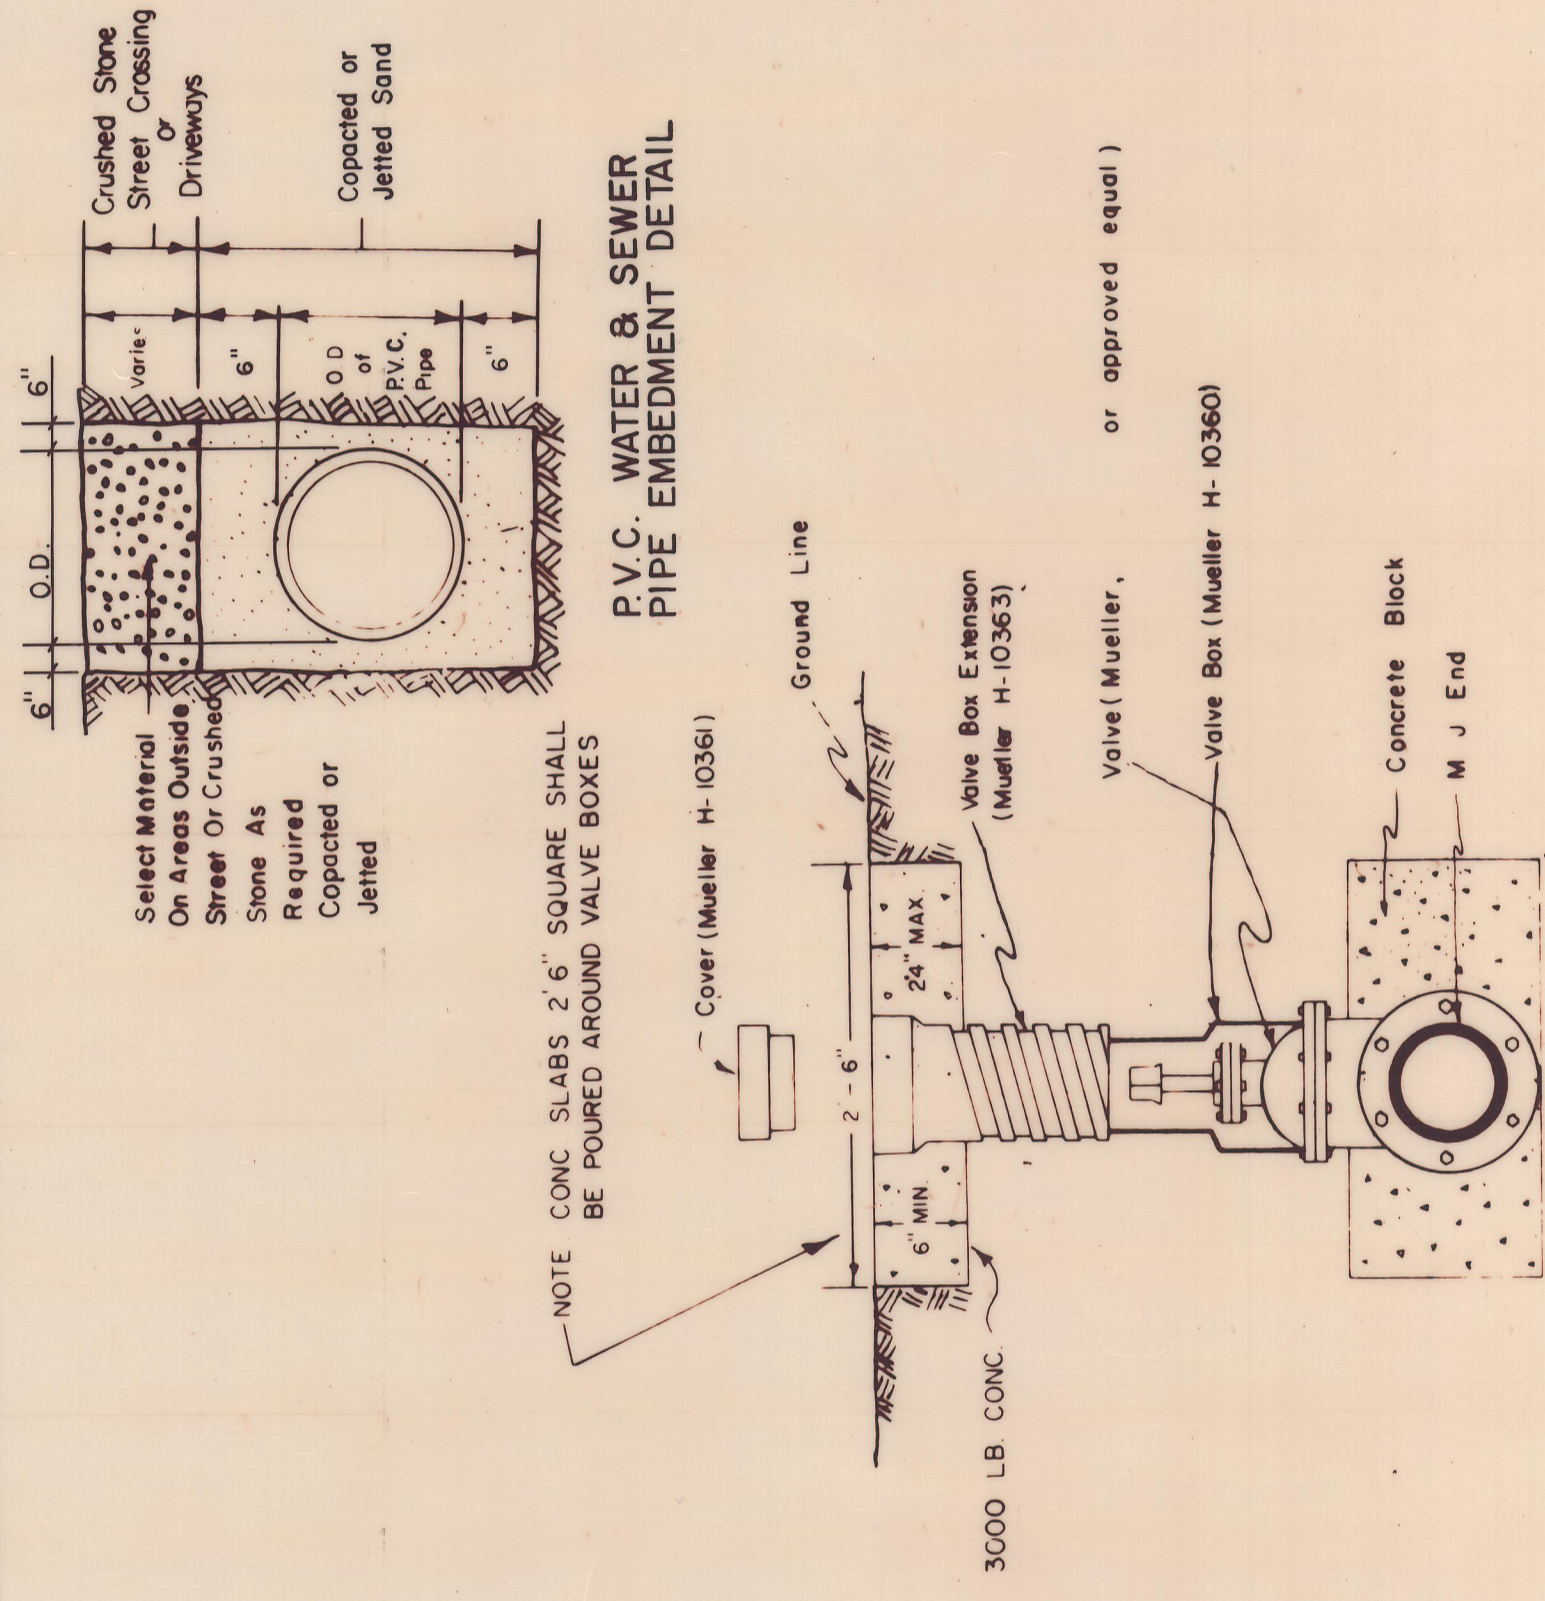

TYPICAL VALVE SETTING & VALVE BOX

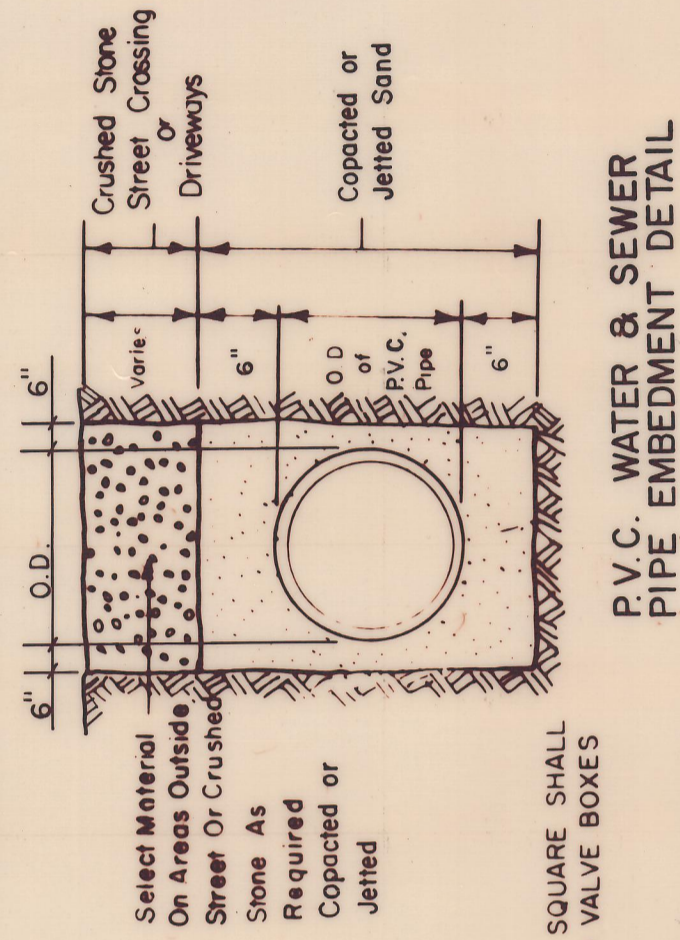

PVC WATER & SEWER PIPE EMBEDMENT DETAIL

REMOVED TO CONFORM TO CONSTRUCTION RECORDS  
 BY RA  
 DATE 8/1/80

WATER MAIN APPURTENANCES  
 DETAIL OF WATER MAIN INSTALLATIONS



Graham Associates, Inc.  
 CONSULTING ENGINEERS & PLANNERS

DESIGN	DRAWN	CHECK	DATE	SCALE	SHEET NO.
J. D. H.	B. J. M.	D. P.	3-1-79	NONE	17 OF 22