


REVISED TO CONFORM TO
CONSTRUCTION RECORDS:
BY *RH* DATE *9/6/80*


SCALE
HOR. 1" = 40'
VER. 1" = 4'

LINE-A-PLAN

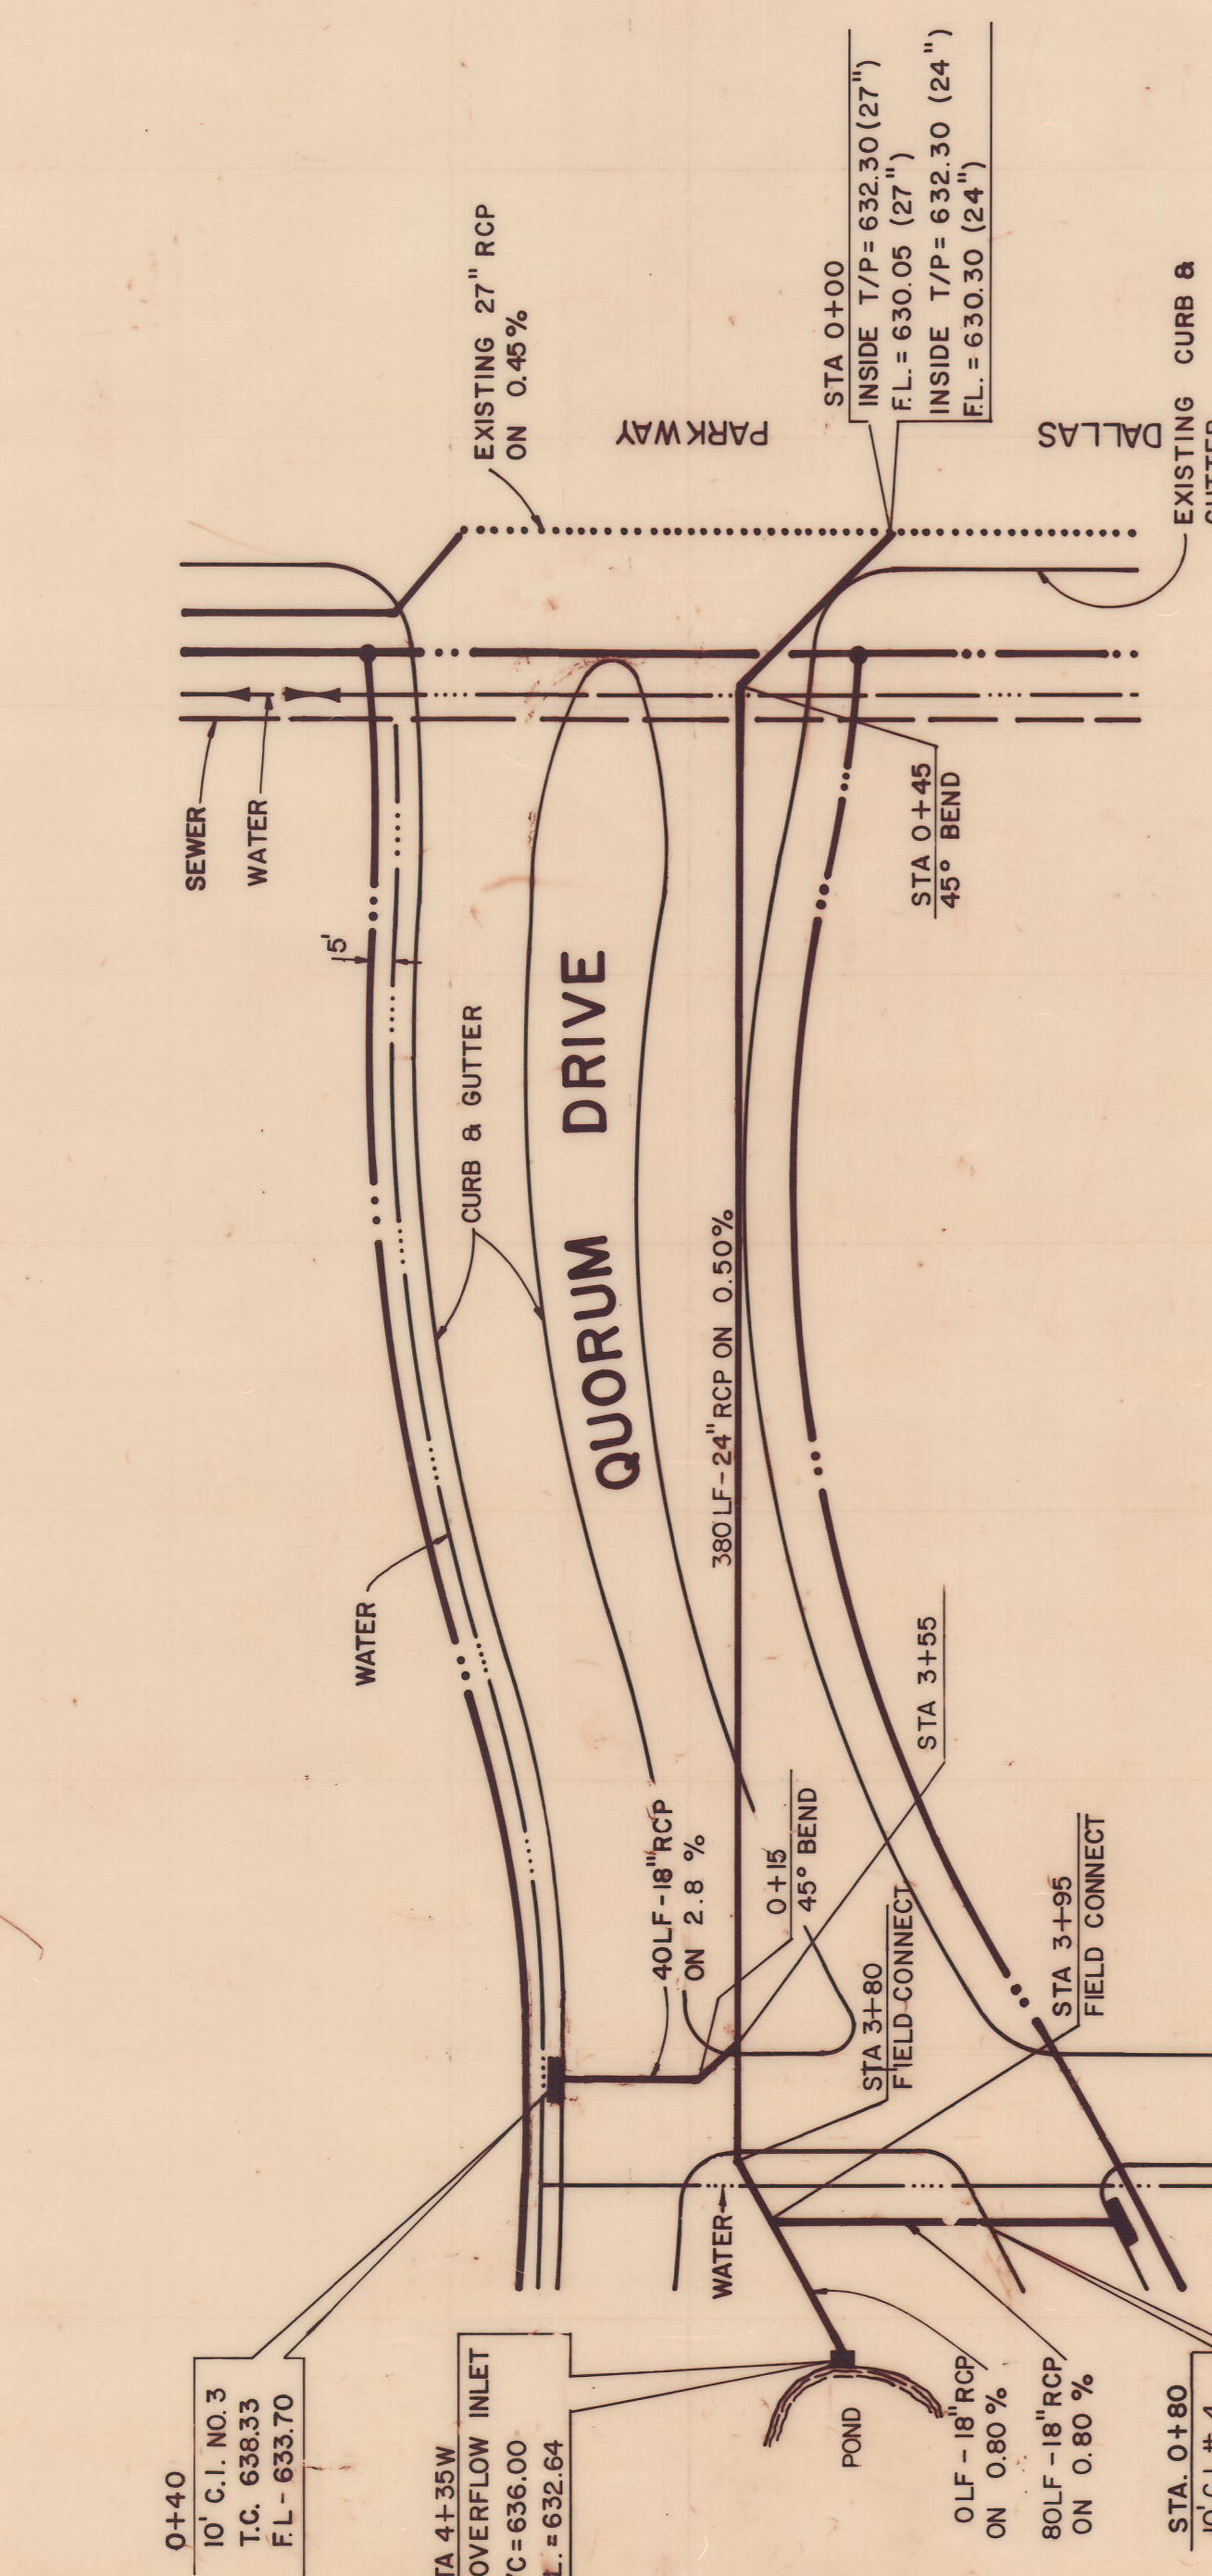

LINE-B-PLAN

NOTE:
ALL R.C.P. PIPE SHALL BE CLASS III ASTM C-76
ALL R.C.P. PIPE SHALL BE SET IN CONCRETE
CRADLE BEDDING PER CITY OF DALLAS
STANDARD DETAILS.

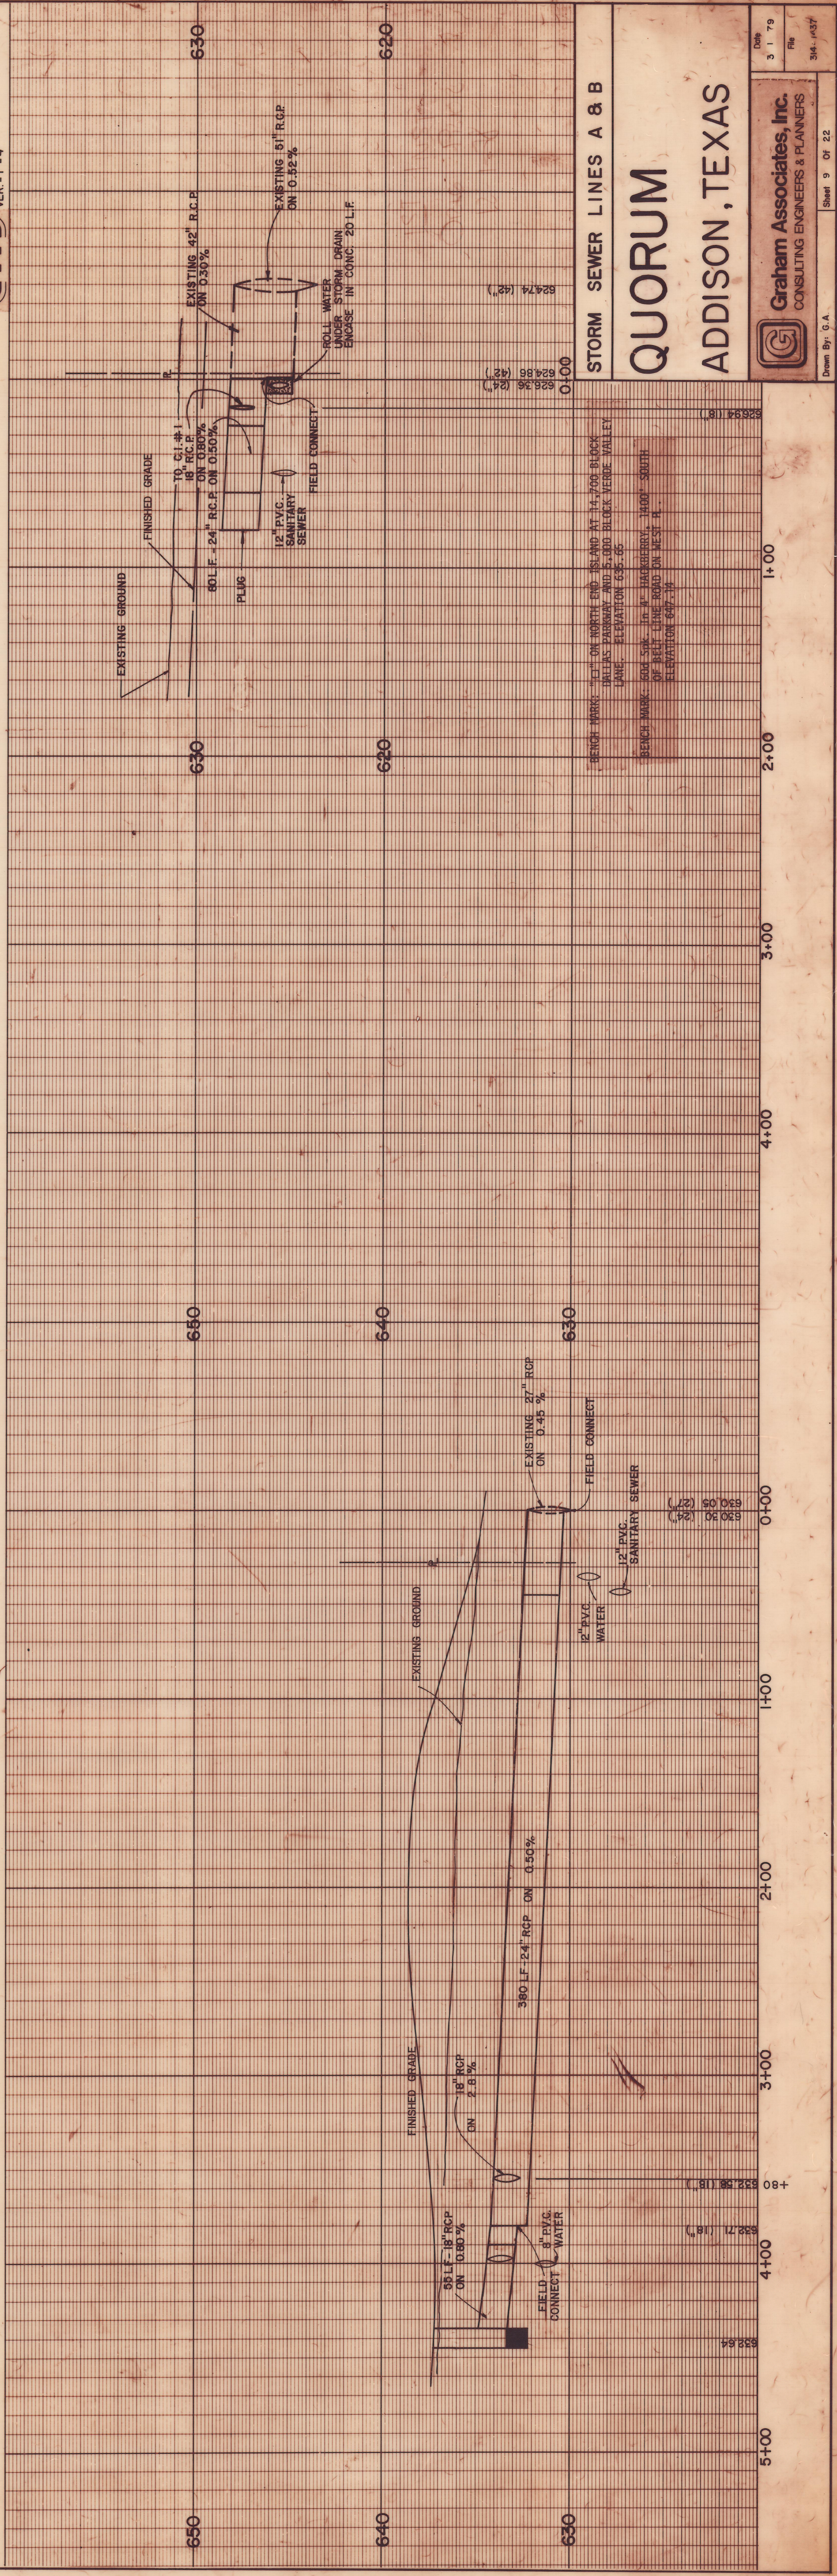

STORM SEWER LINES A & B

QUORUM

ADDISON, TEXAS

Drawn By: G.A. Sheet 9 of 22

3 1 79

344-1437

Graham Associates, Inc.
CONSULTING ENGINEERS & PLANNERS