


LINE "A" PROFILE

SCALE:
HORIZ. - 1" = 40'
VERT. - 1" = 4'

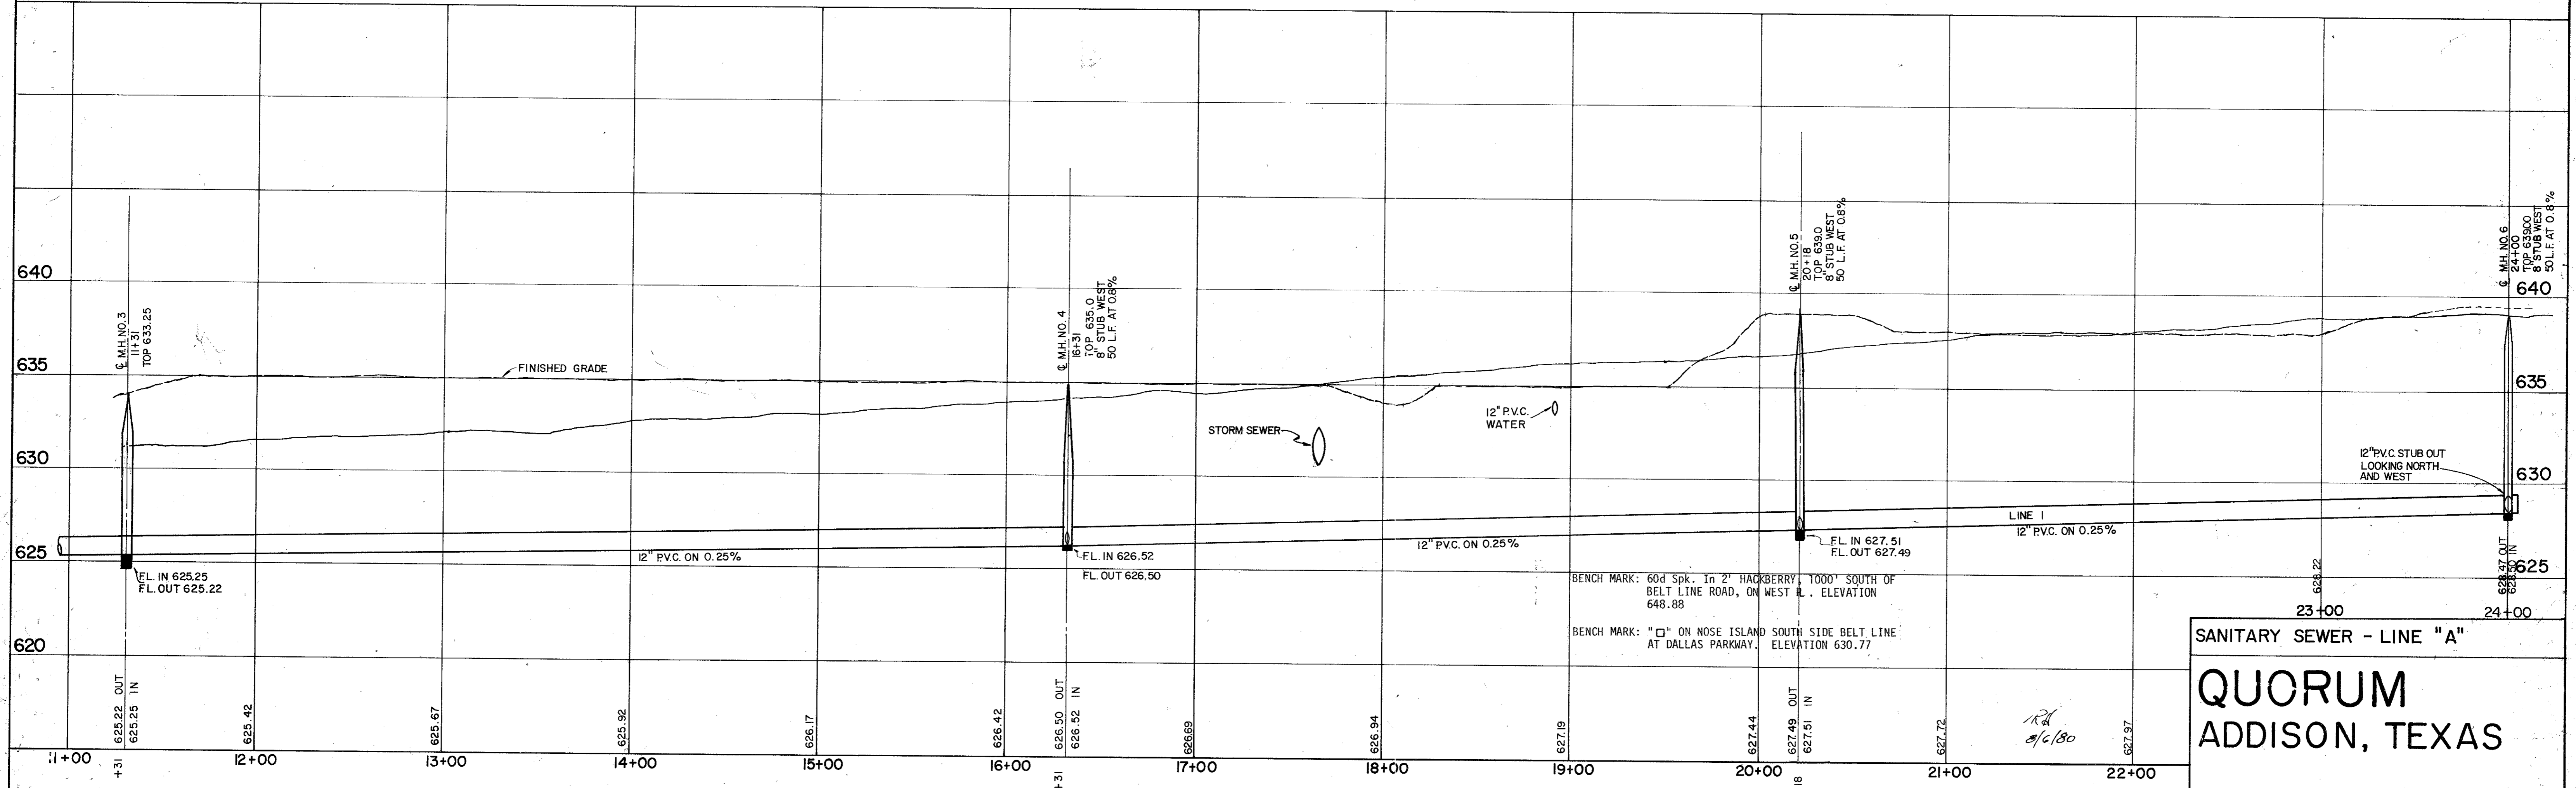

LINE "A" PROFILE

BENCH MARK: 60d Spk. In 2' HACKBERRY, 1000' SOUTH OF BELT LINE ROAD, ON WEST L. ELEVATION 648.88

BENCH MARK: "□" ON NOSE ISLAND SOUTH SIDE BELT LINE AT DALLAS PARKWAY. ELEVATION 630.77

SANITARY SEWER - LINE "A"

QUORUM ADDISON, TEXAS

<p>Graham Associates, Inc. CONSULTING ENGINEERS & PLANNERS</p>	Date	3-1-79
	File	514 1437
Drawn By: G.A.I.		Sheet 12 Of 22