


LINE "B" PROFILE

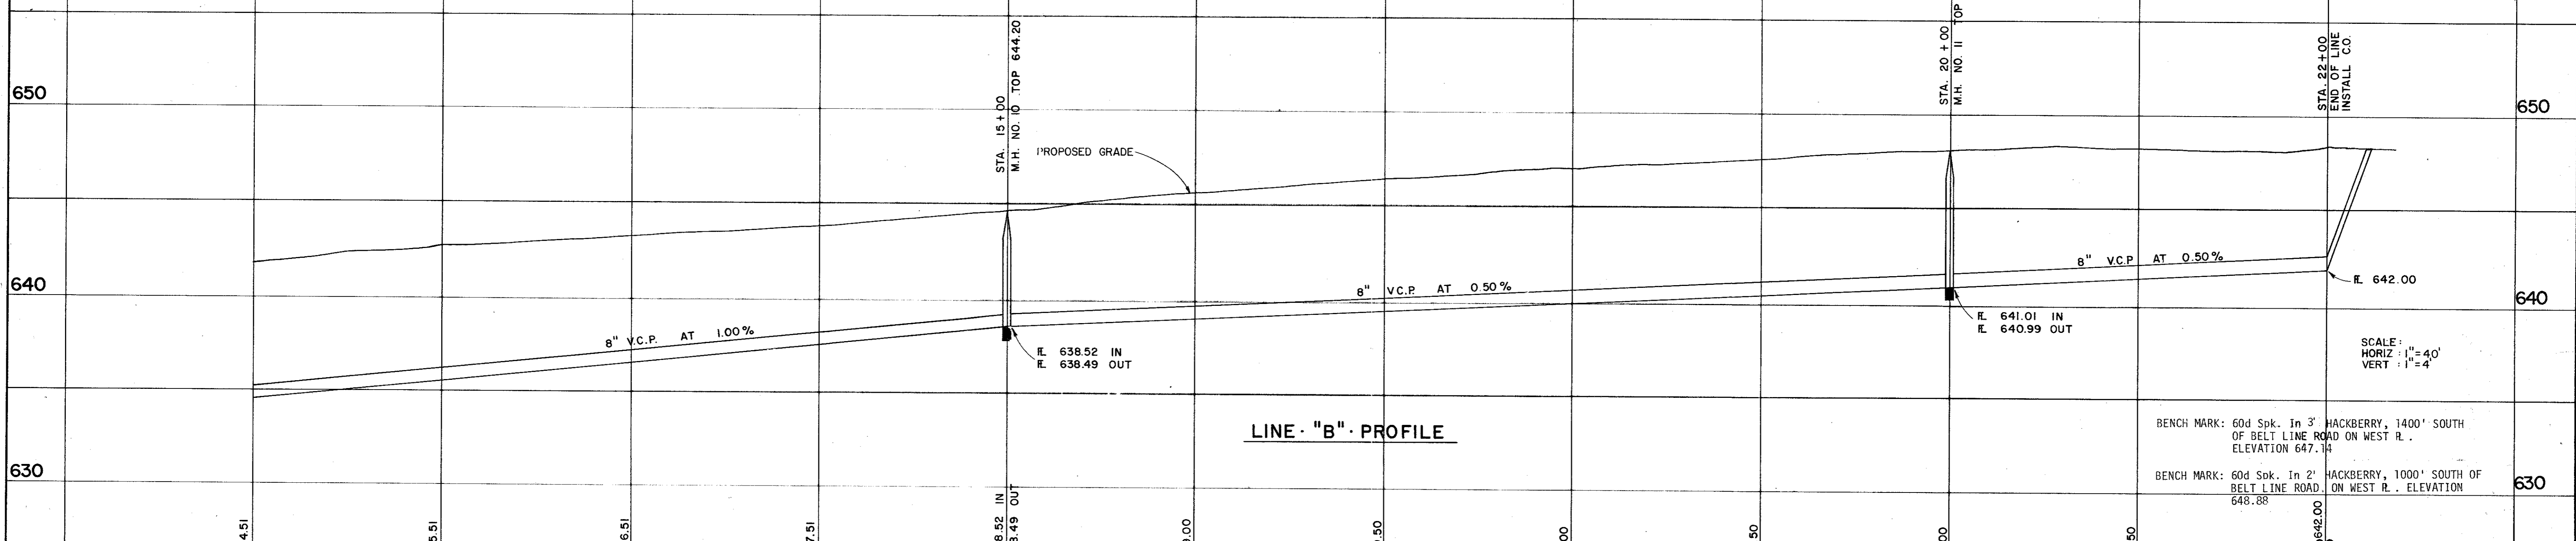

LINE "B" PROFILE

BENCH MARK: 60d Spk. In 3" HACKBERRY, 1400' SOUTH OF BELT LINE ROAD ON WEST R. ELEVATION 647.14
 BENCH MARK: 60d Spk. In 2" HACKBERRY, 1000' SOUTH OF BELT LINE ROAD, ON WEST R. ELEVATION 648.88

SCALE: HORIZ: 1"=40' VERT: 1"=4'

SANITARY SEWER - LINE "B"
QUORUM
 ADDISON, TEXAS

Graham Associates, Inc.
 CONSULTING ENGINEERS & PLANNERS

Drawn By: G. A. I. Sheet 13 of 22

Date: 3-1-79
 File: 314-1437

RA
 8/6/80