



TYPICAL THRUST BLOCK DETAILS

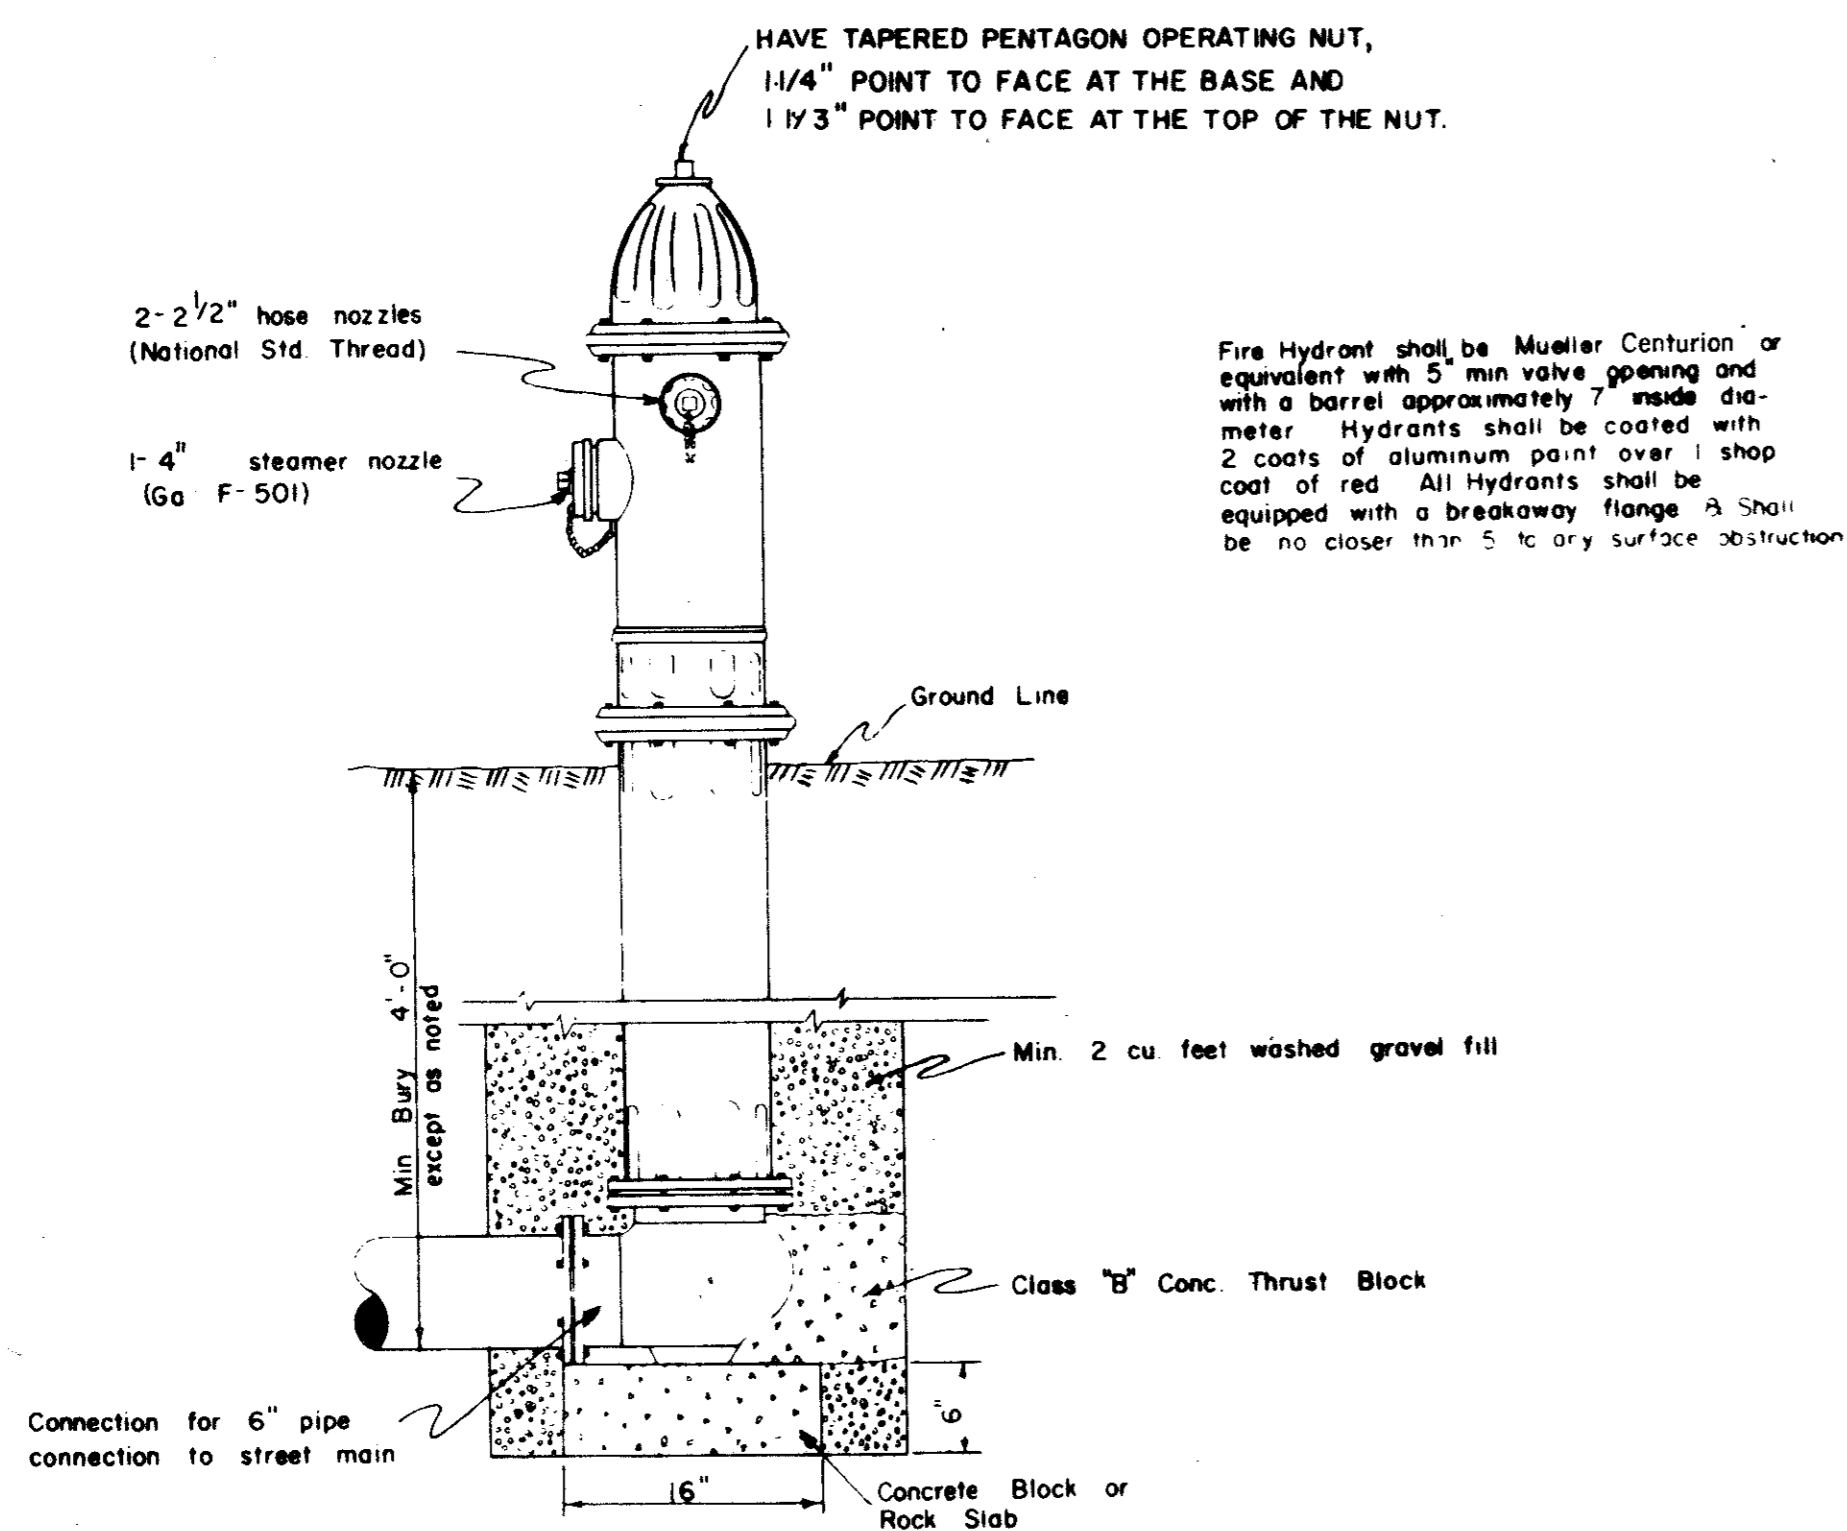

TYPICAL FIRE HYDRANT INSTALLATION

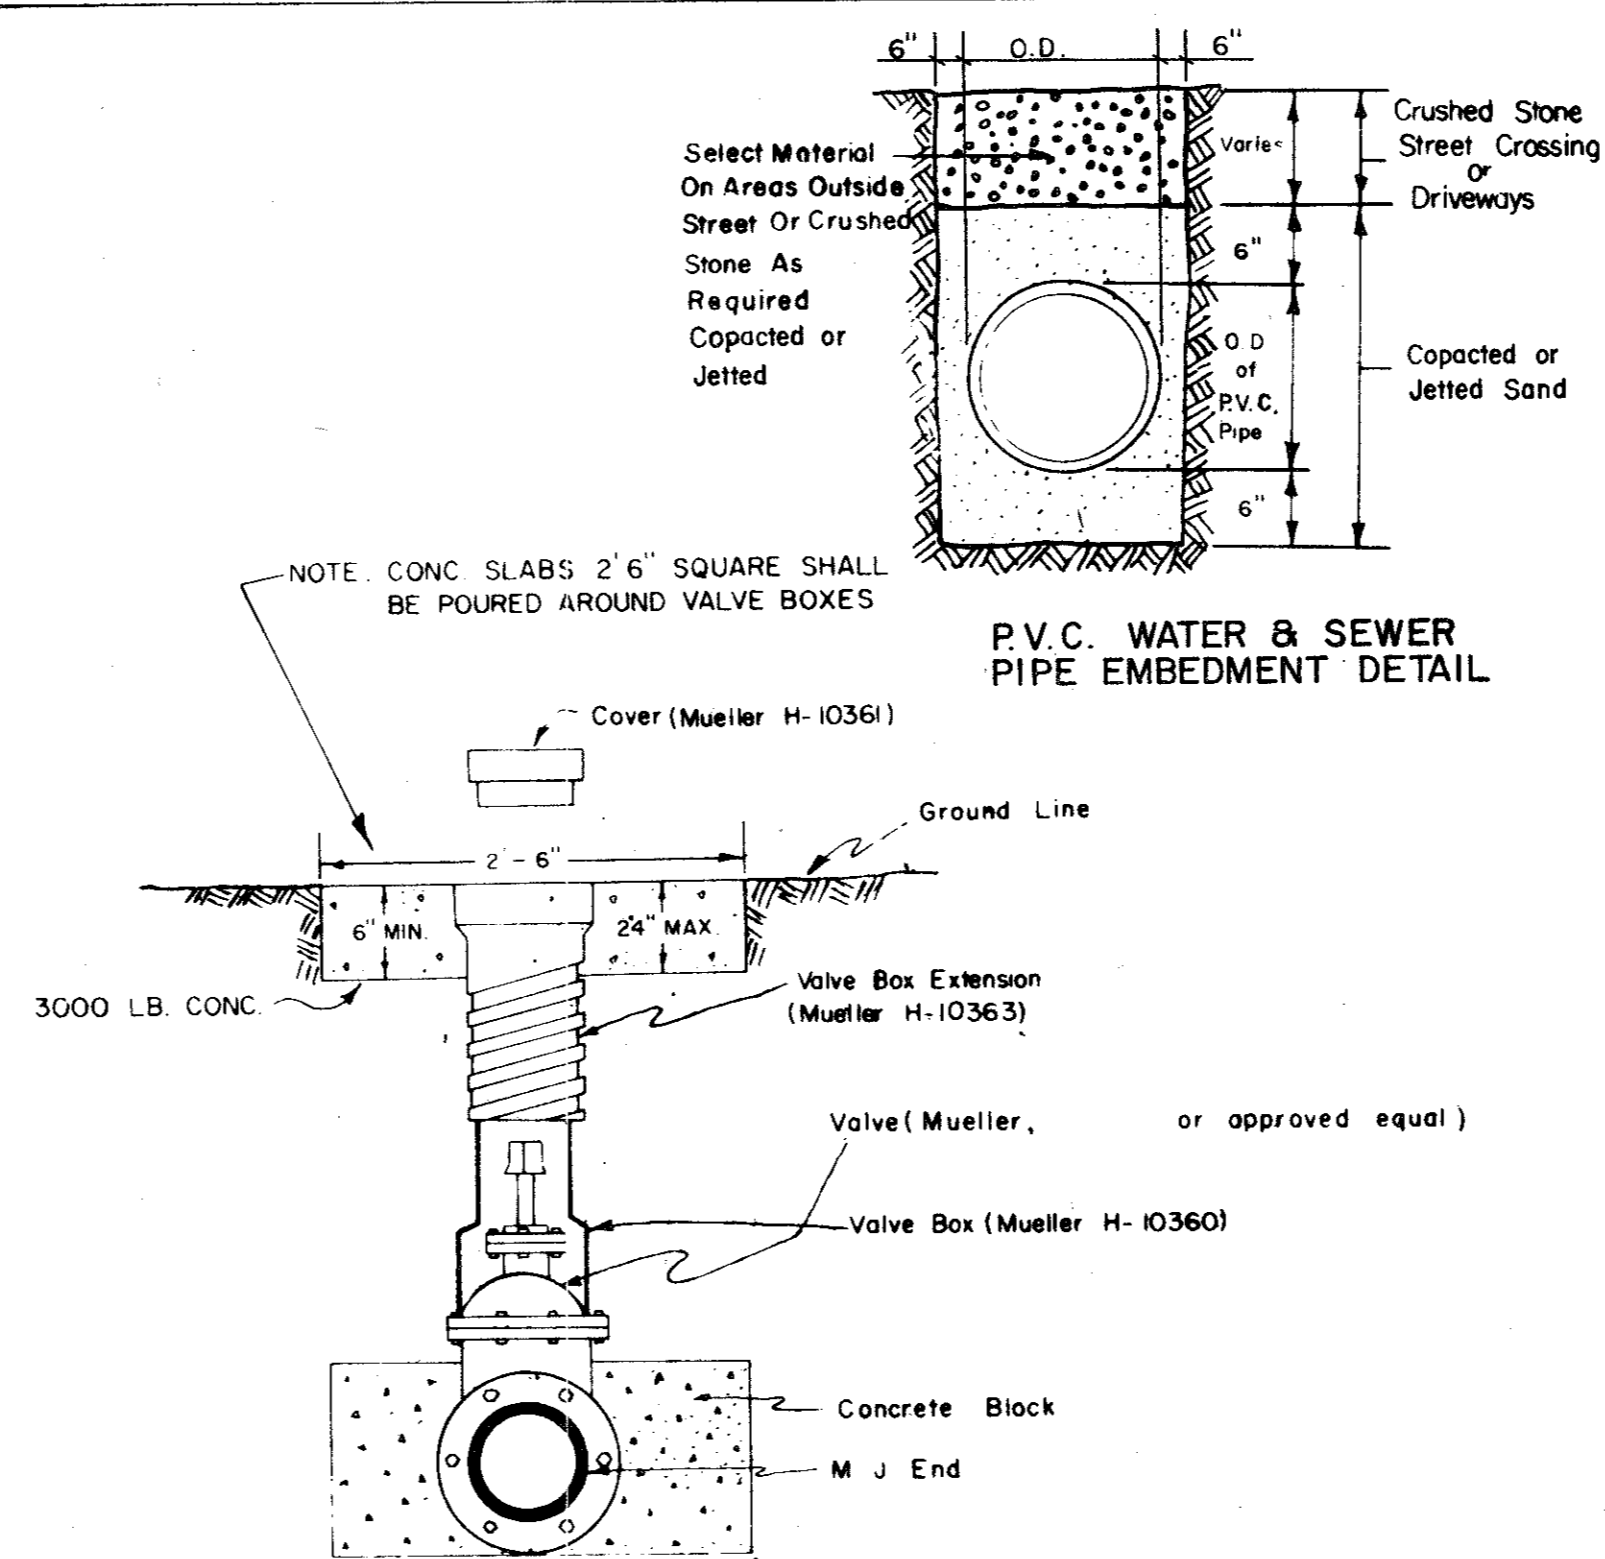

TYPICAL VALVE SETTING & VALVE BOX

WATER MAIN APPURTENANCES

DETAIL OF WATER MAIN INSTALLATIONS

G Graham Associates, Inc.
CONSULTING ENGINEERS & PLANNERS

DESIGN	DRAWN	CHECK	DATE	SCALE	SHEET
J. D. H.	B. J. M.	D. P.	3-1-79	NONE	17 OF 22

RH
8/6/80