


LINE "B" PROFILE

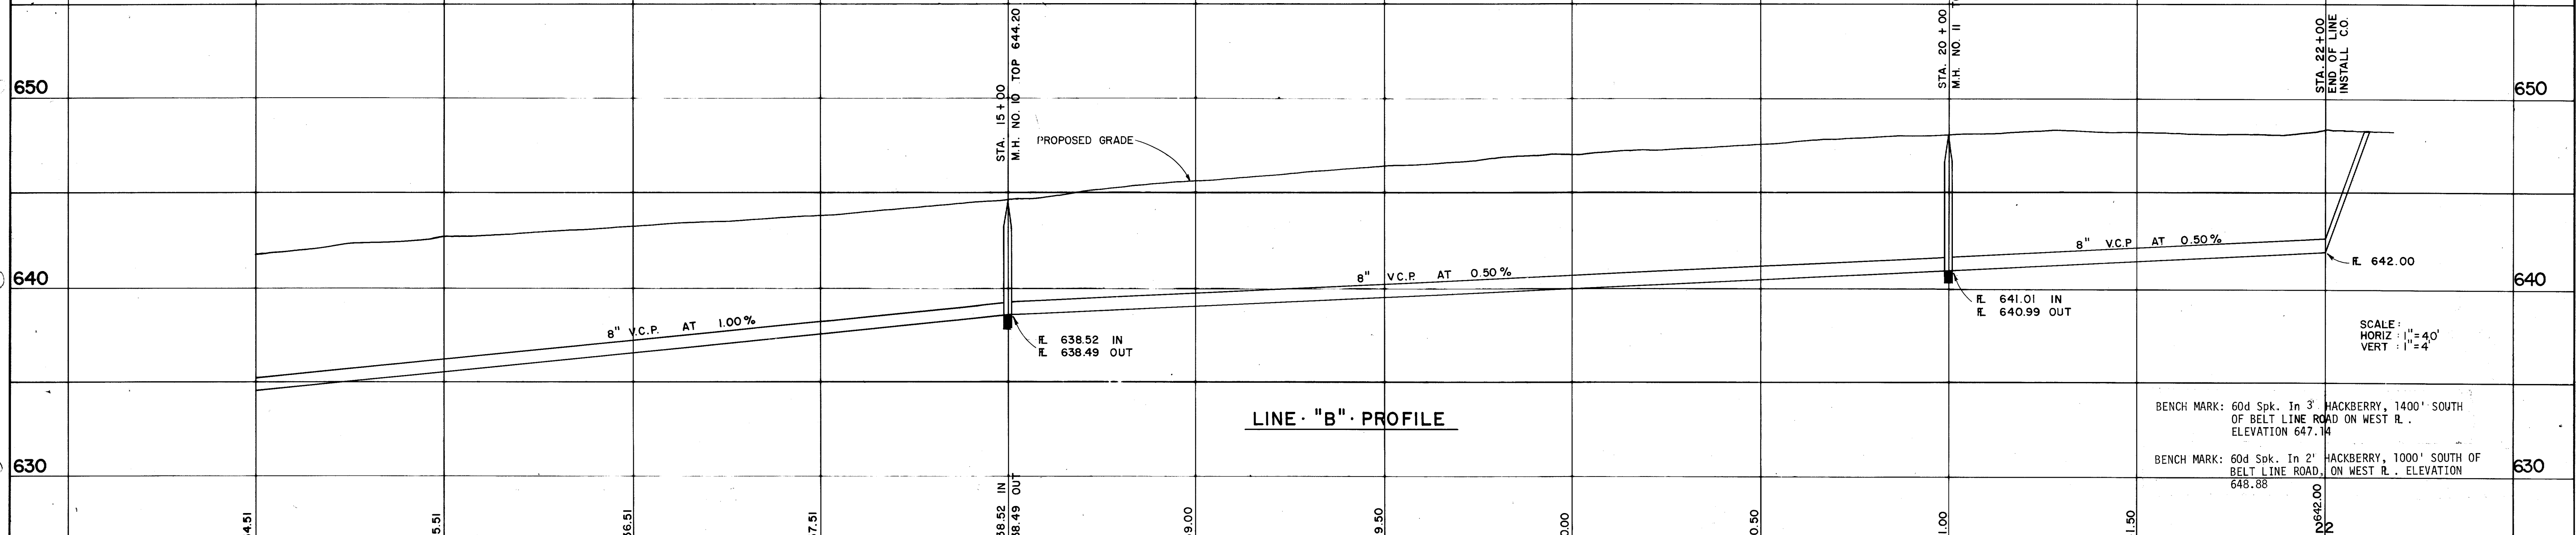


LINE "B" PROFILE

BENCH MARK: 60d Spk. In 3' HACKBERRY, 1400' SOUTH OF BELT LINE ROAD ON WEST R. ELEVATION 647.14  
 BENCH MARK: 60d Spk. In 2' HACKBERRY, 1000' SOUTH OF BELT LINE ROAD, ON WEST R. ELEVATION 648.88

SCALE:  
 HORIZ : 1" = 40'  
 VERT : 1" = 4'

SANITARY SEWER - LINE "B"  
**QUORUM**  
 ADDISON, TEXAS


**Graham Associates, Inc.**  
 CONSULTING ENGINEERS & PLANNERS  
 Date: 3-1-79  
 File: 314-1437  
 Drawn By: G. A. I. Sheet 13 OF 22

REVIEWED TO CONFORM TO  
 PROJECT RECORDS:  
 BY: *RH*  
 DATE: 8/6/80