


SUMMARY OF ESTIMATED QUANTITIES

INDEX TO DRAWINGS

ITEM NO.	DESCRIPTION	UNIT	PAVING SHEETS										DRAINAGE SHEETS										MISC.	TOTAL
100.1	Prepare right-of-way	Sta.																						8.5
104.1	Sawed break-out groove	LF'																						472
110.1	Roadway excavation	CY																						970
260.1	6" Lime treatment	SY																						3139
264.1	Hydrated lime (type A) #27/sy	Ton																						42
340.1	HMACP (Type "D" Cl. A) Surf. coarse #110/in./sy	Ton																						26
340.2	HMACP (Type "B" Cl. A) Base coarse #110/in./sy	Ton																						41
360.1	8" Reinf. concrete pavement (3000 psi)	SY																						2614
360.2	6" Integral conc. curb (3000psi)	LF																						832
465.1	18" RCP, Class III	LF																						26
465.2	21" RCP, Class III	LF																						245
465.3	24" RCP, Class III	LF																						106
465.4	30" RCP, Class III	LF																						155
465.41	30" RCP 30° bend, Class III	Ea																						1
470.1	10' Recessed curb inlet	Ea																						3
470.2	10' Modified recessed curb inlet	Ea																						1
475.1	Adjust exist. grate inlet	Ea																						3
479.1	Adjust sanitary sewer manhole	Ea																						1
479.2	Adjust sanitary sewer cleanout	Ea																						1
530.1	6" Reinf. conc. driveway pavement (3000 psi)	SY																						726
582.1	Adjust water valve	Ea																						1
582.2	Adjust water valve & fire hydrant	Ea																						2
582.3	Lower water line	LF																						90
670.1	4" Fire lane striping	LF																						801
674.1	4" Bi-Directional reflective yellow marker (P-117Y)	Ea																						102
591	Irrigation system replacement	LS																						1

SHEET NO.	DESCRIPTION
1	Cover Sheet
2	Summary of Quantities
3	Construction Sequence & Property Ownerships
4	Paving Plan & Profile Sta. 0+00.00 to Sta. 5+00
5	Paving Plan & Profile Sta. 5+00 to Sta. 8+46.5
6	Drainage Area Map
7	Drainage Plan & Profile
8	Paving Details
9	Storm Sewer & Driveway Details
10	Curb Inlet Details
11	Water Details
12	Sanitary Sewer Details

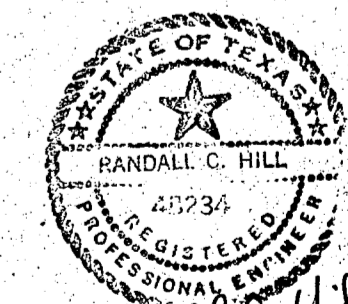

Randall C. Hill
4-14-87

RECORD DRWG.

No.	Revision	By	Date
TOWN OF ADDISON DALLAS COUNTY, TEXAS			
RATLIFF LANE IMPROVEMENTS			
SHEET INDEX & SUMMARY OF QUANTITIES			
GINN, INC.			
Consulting Engineers Dallas, Texas			
Designed - R.L.D.	Drawn - R.L.D.	Date - OCT. 86	Job No. 293
Approved - HWG	Checked - R.C.H.	Scale - N/A	Sheet 2 of 12