


John P. Wilson

W. M. W. J. V.

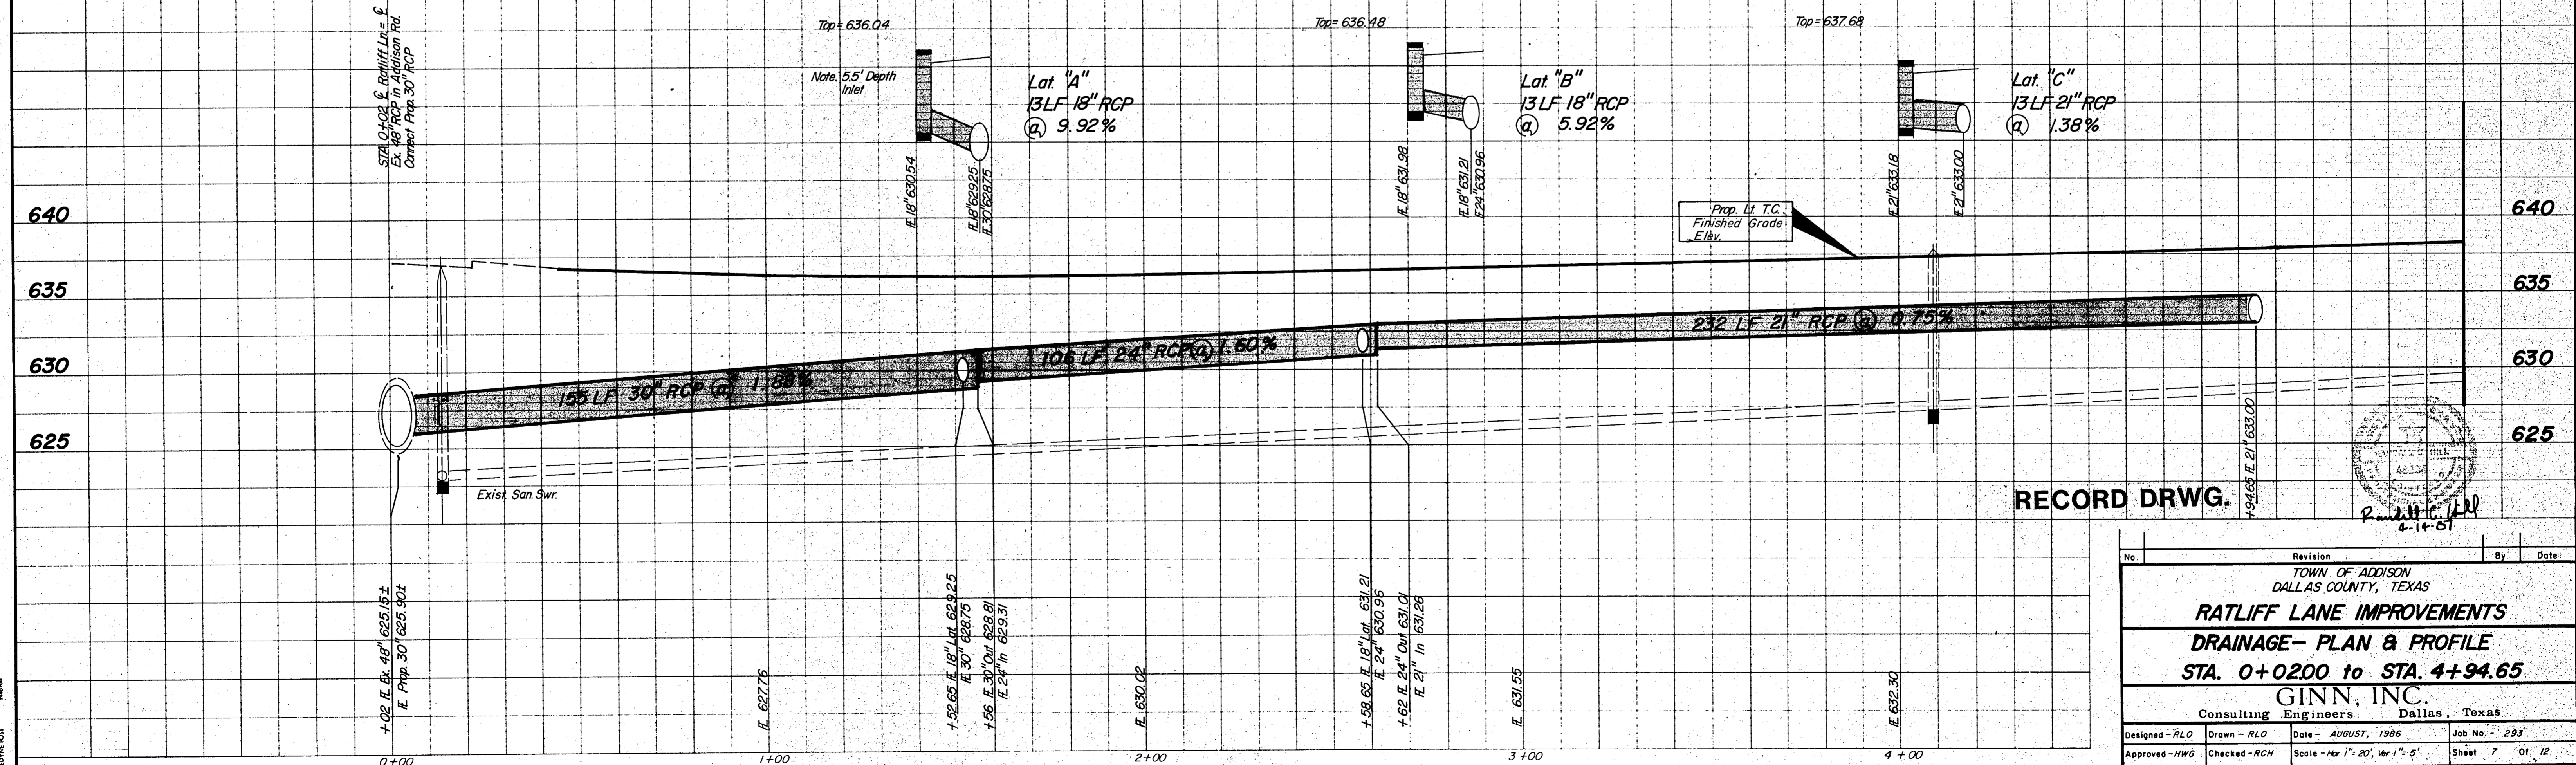

RECORD DRWG.

No.	Revision	By	Date
TOWN OF ADDISON DALLAS COUNTY, TEXAS			
RATLIFF LANE IMPROVEMENTS			
DRAINAGE- PLAN & PROFILE			
STA. 0+0200 to STA. 4+94.65			
GINN, INC.			
Consulting Engineers Dallas, Texas			
Designed - RLO	Drawn - RLO	Date - AUGUST, 1986	Job No. - 293
Approved - HWG	Checked - RCH	Scale - Hor 1" = 20', Ver 1" = 5'	Sheet 7 of 12