


TOWN OF ADDISON DALLAS COUNTY, TEXAS

CONSTRUCTION PLANS FOR: RAWHIDE CREEK LIFT STATION AND FORCE MAIN

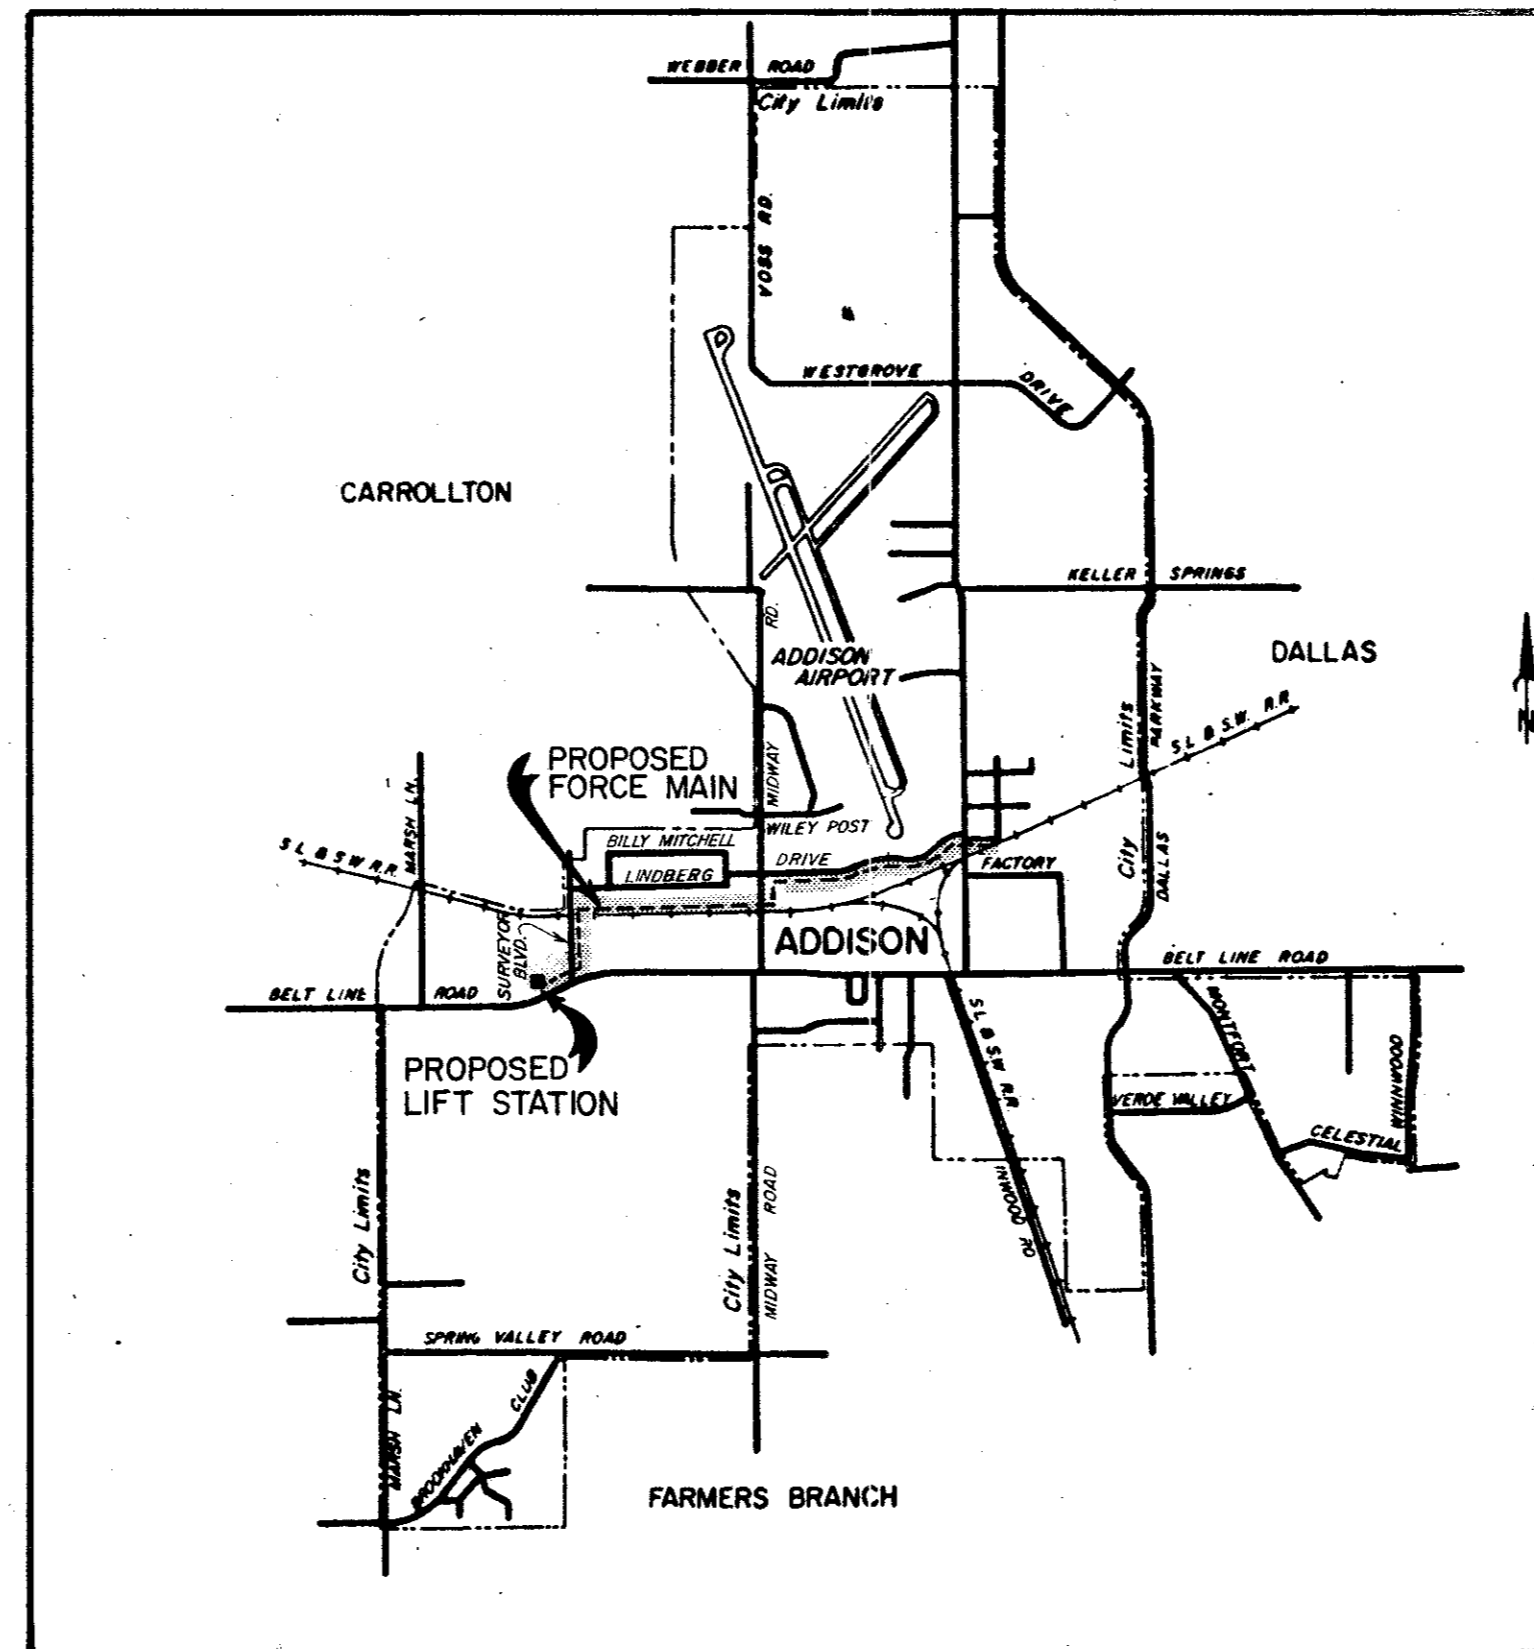

LOCATION MAP

AUGUST, 1992

MAYOR:
LYNN SPRUILL

CITY COUNCIL:
RICH BECKERT
MARY DOLAN
SUSAN HALPERN
STEVEN V. MINSHEW
DICK WILKE

CITY ENGINEER:
JOHN BAUMGARTNER


DIRECTOR OF UTILITIES:
DON PREECE

SHEET INDEX

SHT. NO.	DESCRIPTION	STATIONING
1.	GENERAL NOTES	
2.	PLAN & PROFILE	STA. 1+10.00 TO STA. 10+10.00
3.	PLAN & PROFILE	STA. 10+10.00 TO STA. 20+30.00
4.	PLAN & PROFILE	STA. 20+30.00 TO STA. 30+35.00
5.	PLAN & PROFILE	STA. 30+35.00 TO STA. 39+40.00
6.	PLAN & PROFILE	STA. 39+40.00 TO STA. 48+50.00
7.	PLAN & PROFILE	STA. 48+50.00 TO STA. 60+00.00
8.	PLAN & PROFILE	STA. 60+00.00 TO STA. 70+40.00
9.	PLAN & PROFILE	STA. 70+40.00 TO STA. 79+19.50
10.	LIFT STATION DETAILS	
11.	SANITARY SEWER DETAILS	
12.	THRUST BLOCKING DETAILS	
13.	MISCELLANEOUS DETAILS	

AS BUILT

CARTER & BURGESS, INC.
ENGINEERS • PLANNERS • SURVEYORS
7950 ELMBROOK DRIVE / SUITE 250 / DALLAS, TEXAS 75247
(214) 638-0145 METRO (214) 263-2019

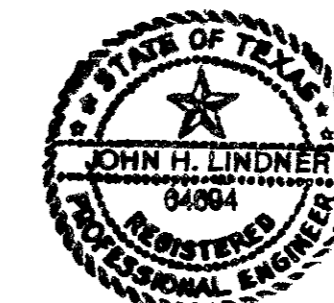

TOWN OF ADDISON

APPROVED BY: _____

DATE: _____