



PLAN  
SCALE: NONE


PANEL 'A' SCHEDULE		VOLTS		3 PHASE		4 WIRE		14,000 A/C	
NO.	DESCRIPTION	BRK	A	B	C	BRK	MOUNTING SURFACE OR RECESSED	NO.	DESCRIPTION
4	PUMP 1	300	200	200	200	100			PUMP 2
5									
6									
7	RECEPTACLE	20	100	100	100	2			PUMP CONTROL XFMR
8									
9									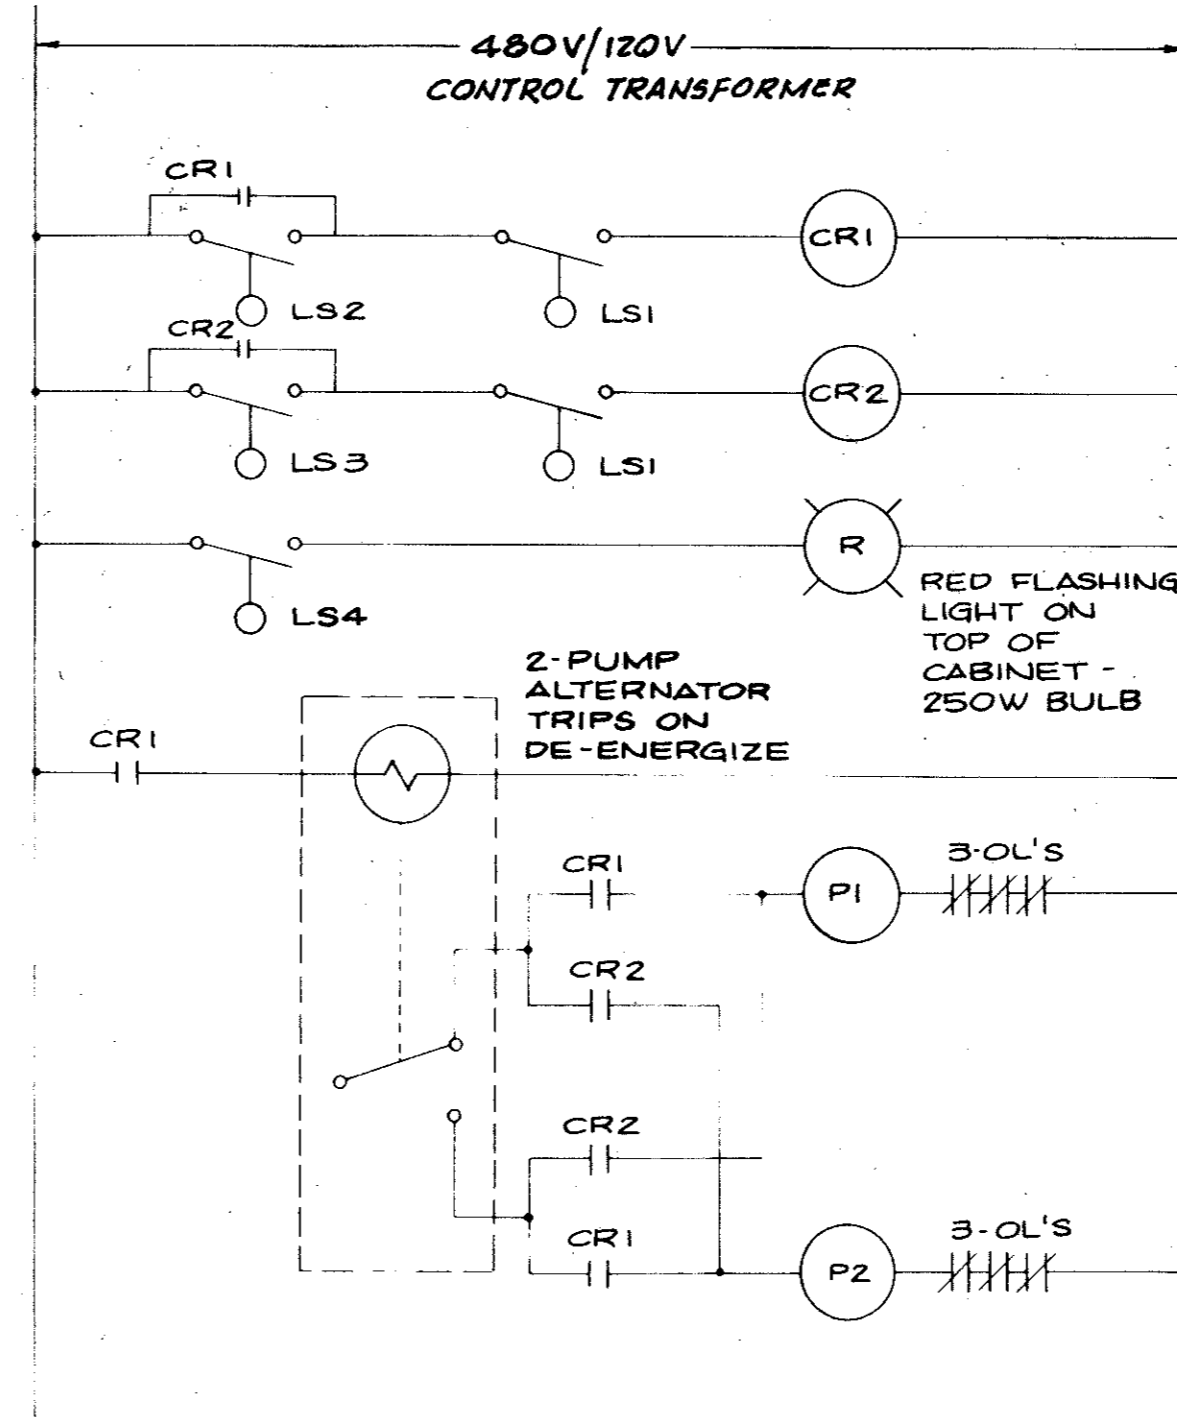
CONTROL SCHEMATIC  
N.T.S.

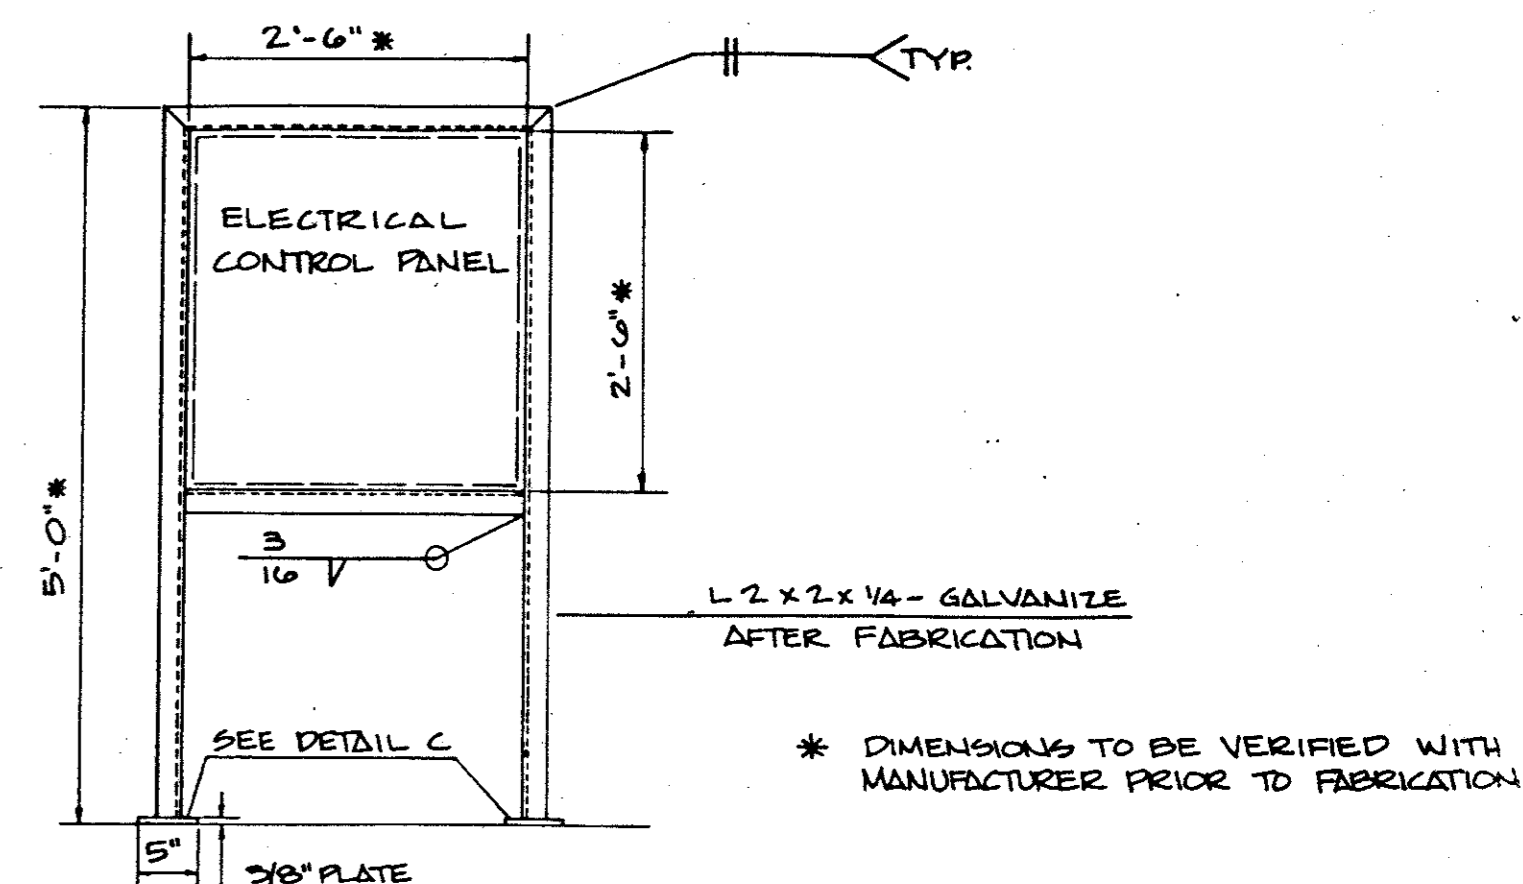

CONTROL PANEL BRACKET  
N.T.S.

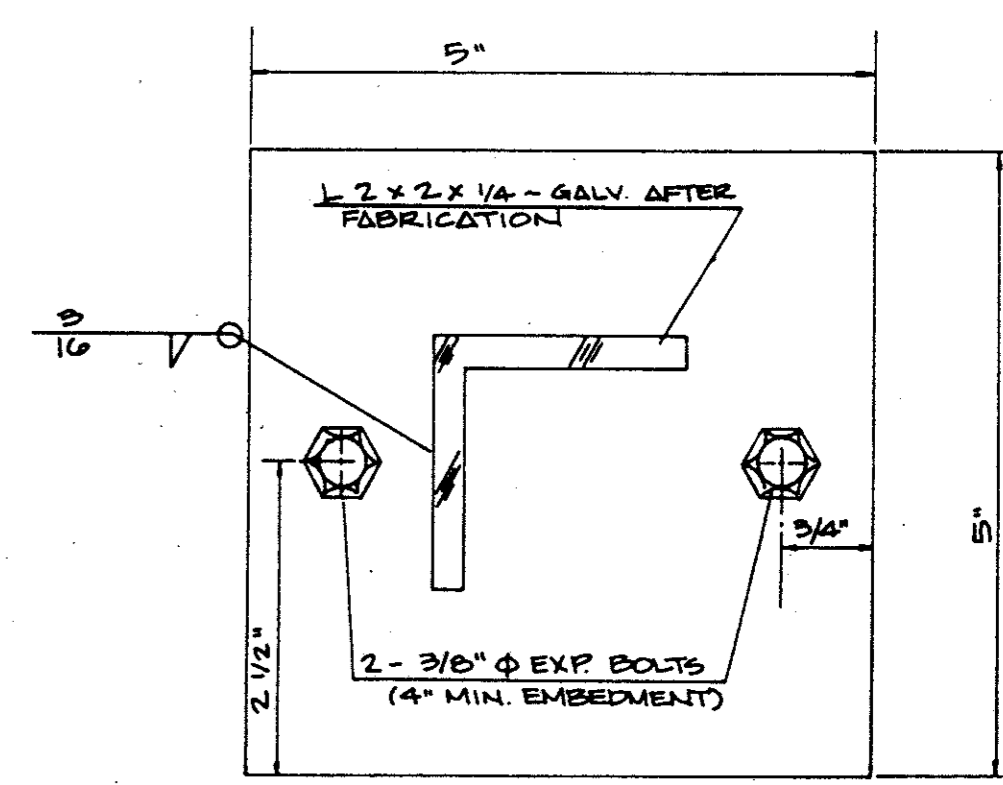


CONTROL PANEL BASE PLATE  
N.T.S.

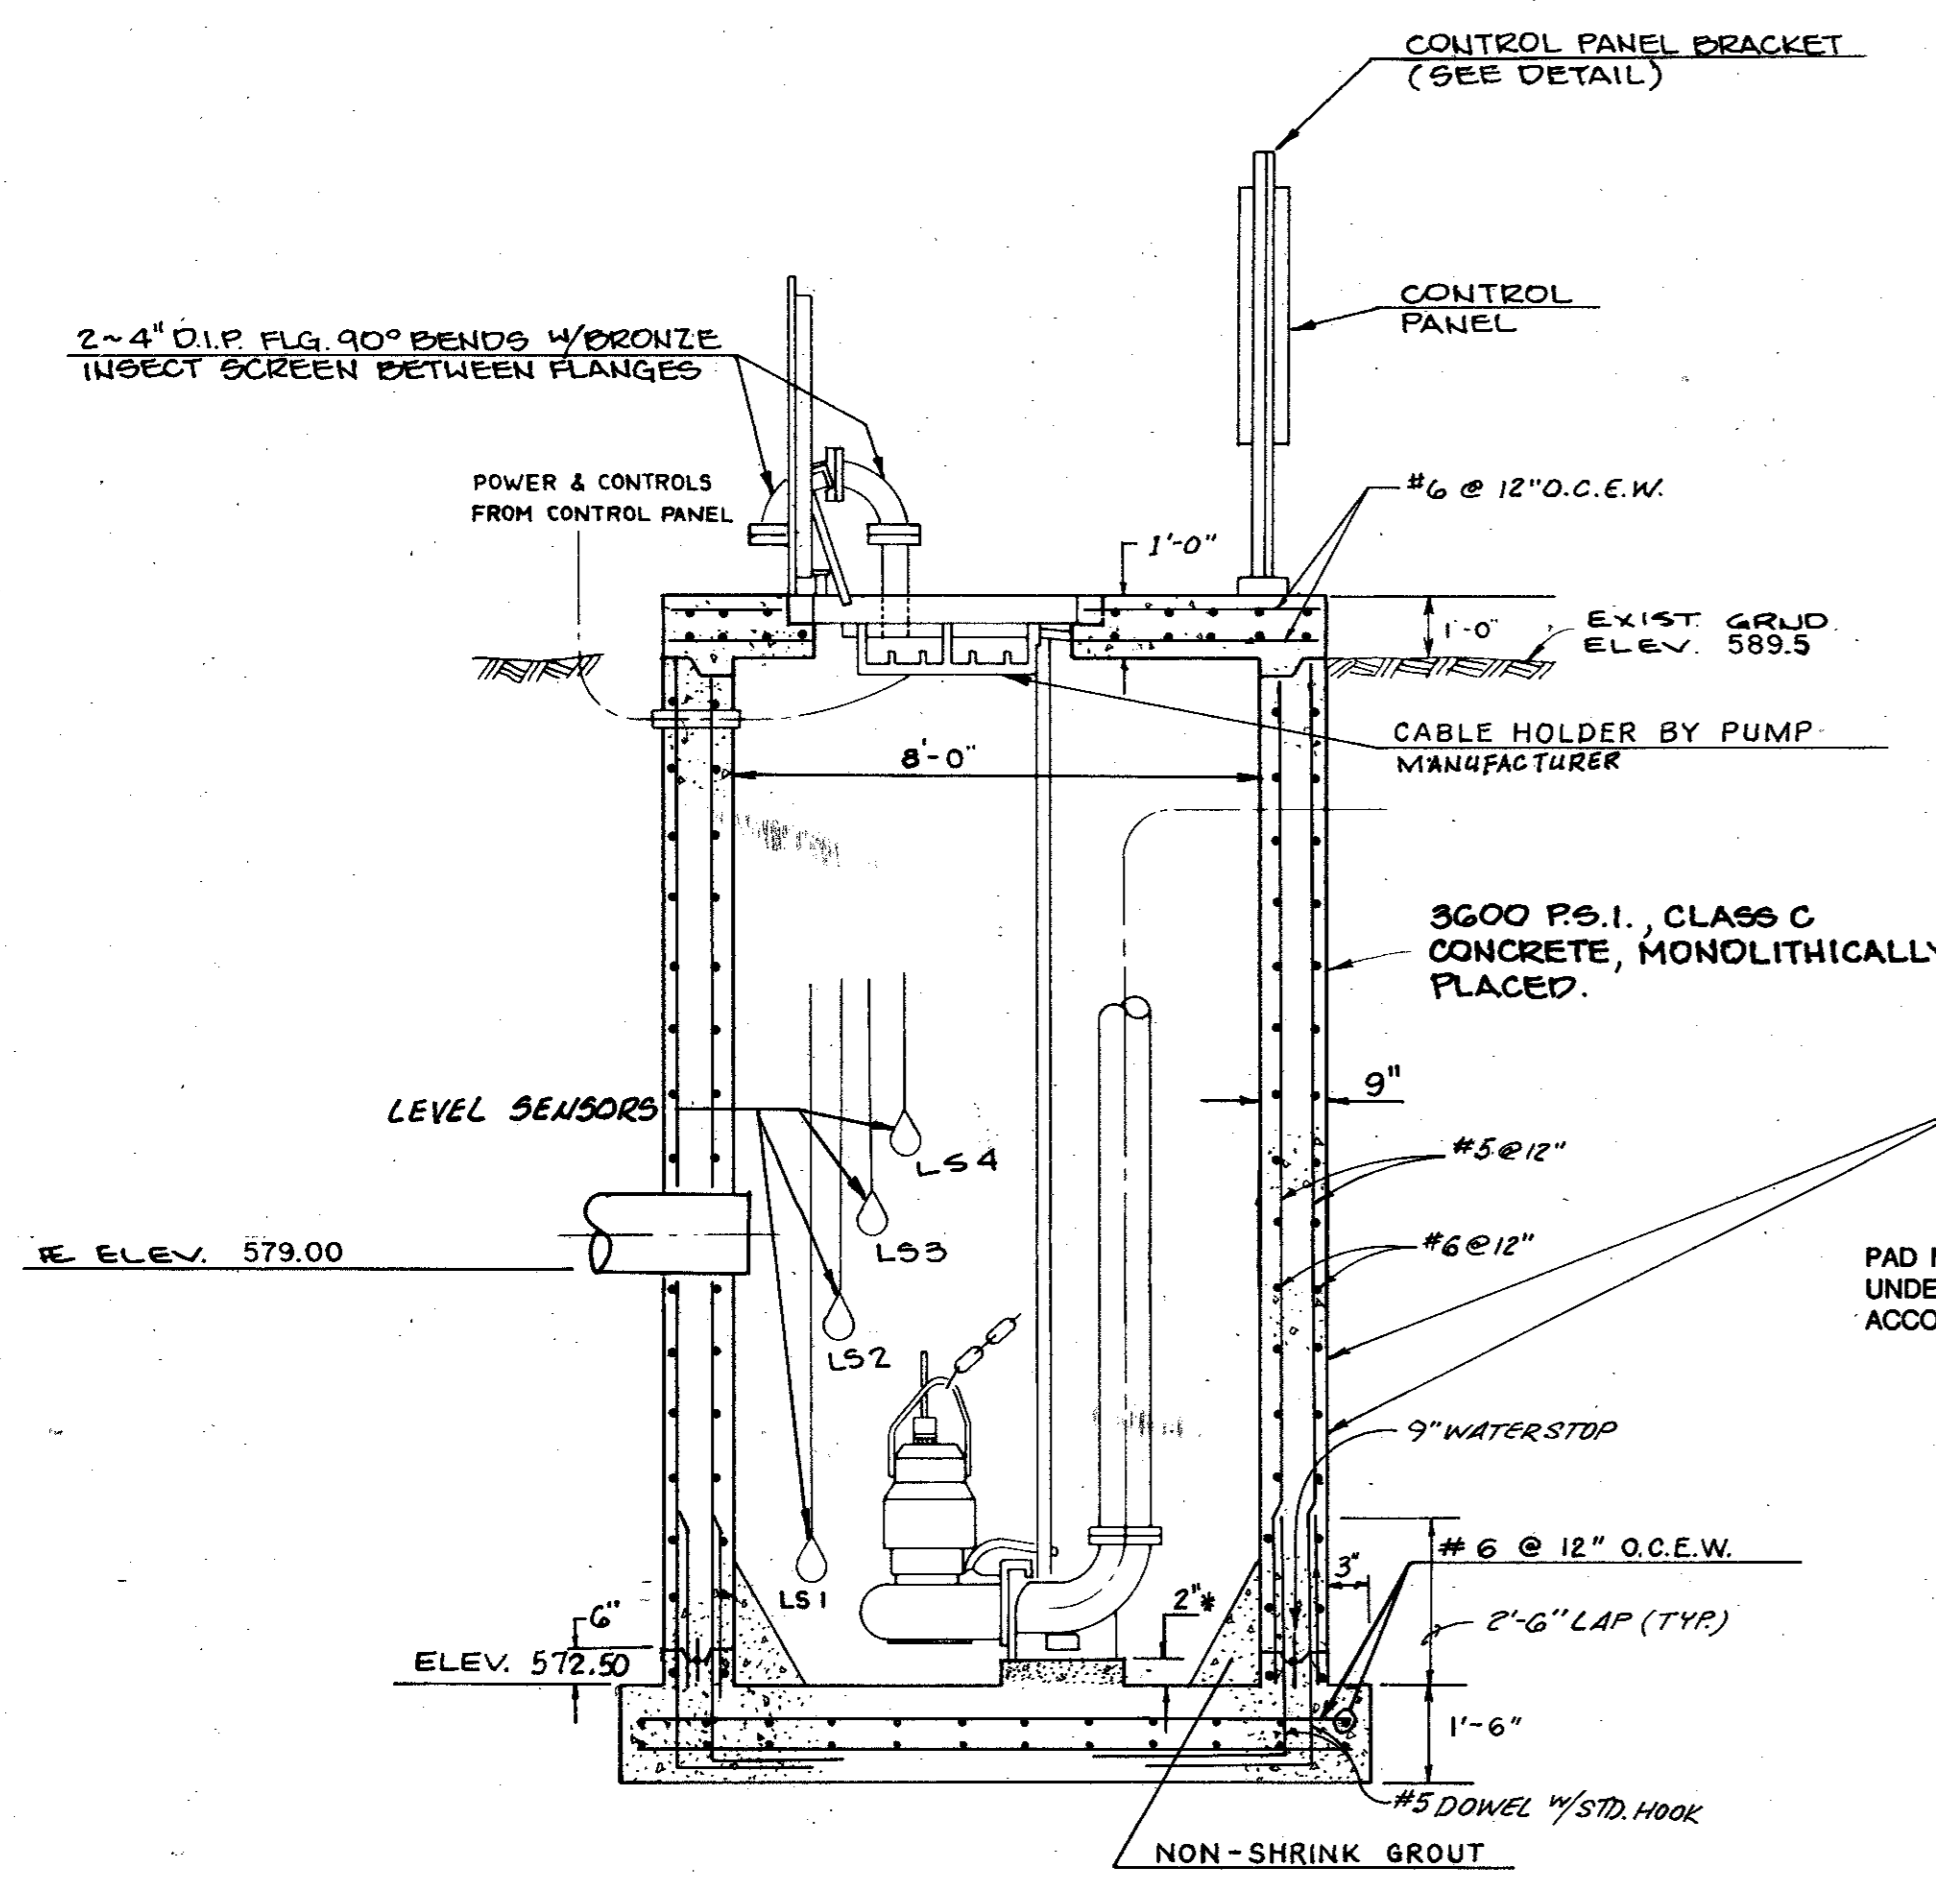

SECTION A  
SCALE: NONE


SENSOR	ELEV.	ACTION
LS1	574.00	ALL PUMPS OFF - ALTERNATE LEAD/LAG SEQUENCE
LS2	579.00	LEAD PUMP ON
LS3	580.00	LAG PUMP ON
LS4	581.00	ALARM SIGNAL ON

BACKFILL FOR LIFT STATION SHALL BE SANDY SELECT MATERIAL AS DEFINED IN THE GEOTECHNICAL REPORT INCLUDED IN THE SPECIFICATIONS. THE MATERIAL SHALL BE COMPACTED TO 95% OF STANDARD PROCTOR DRY DENSITY AND IN ACCORDANCE WITH THE GEOTECHNICAL REPORT.

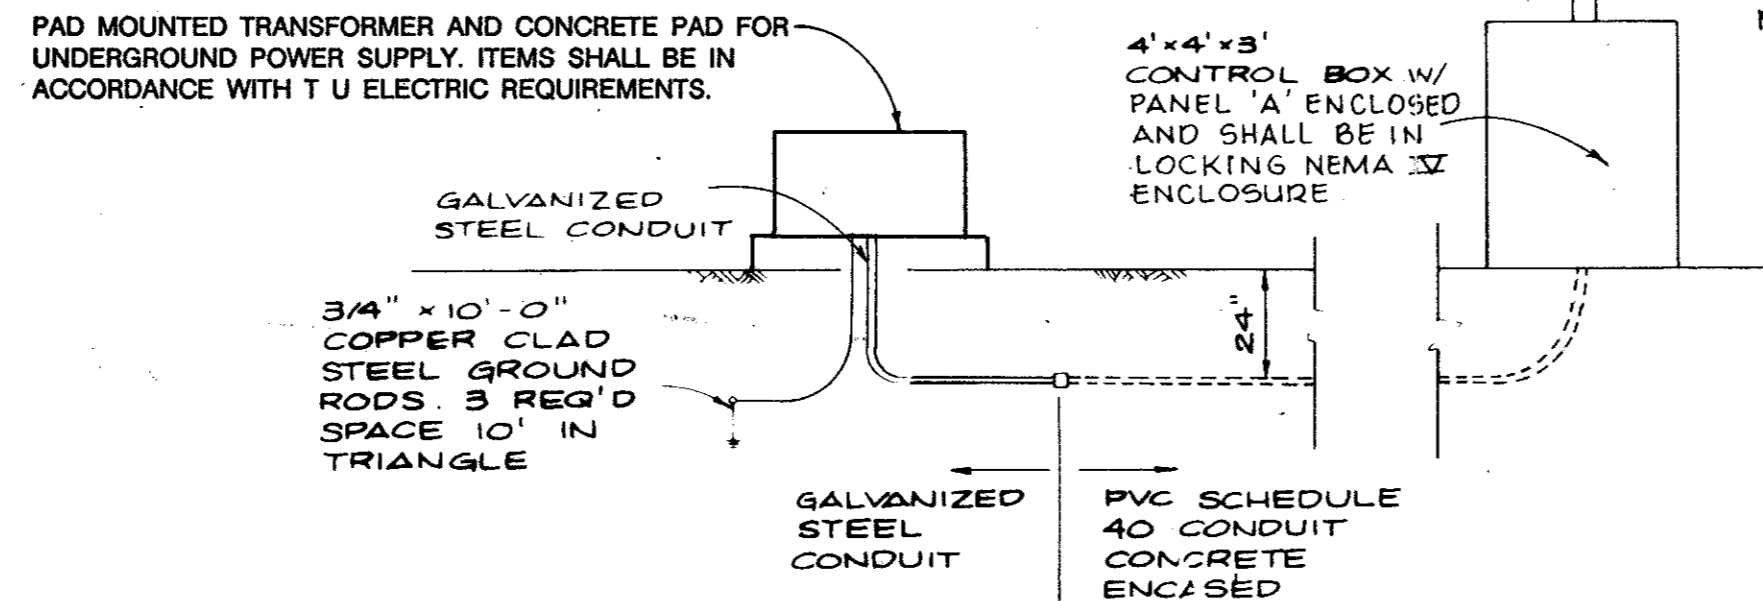

SECTION INCOMING POWER

CONTRACTOR SHALL BE RESPONSIBLE FOR COORDINATION WITH T U ELECTRIC AND ALL CHARGES ASSOCIATED WITH PROVIDING POWER SUPPLY, TRANSFORMER, METER, AND OTHER ASSOCIATED ITEMS.

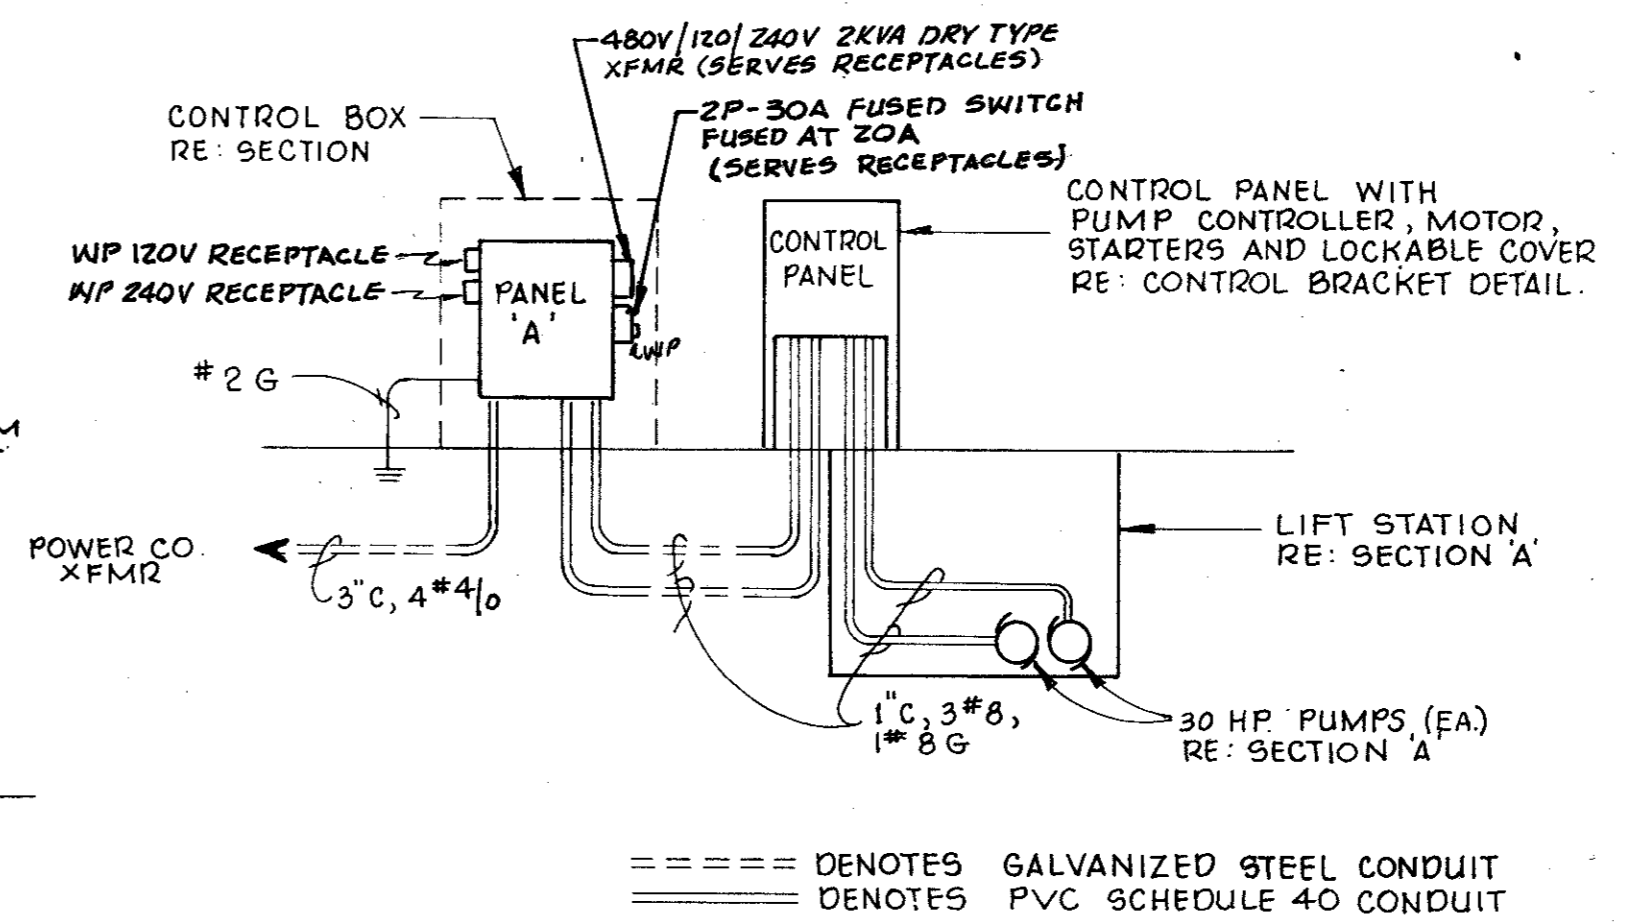

ONE LINE DIAGRAM  
N.T.S.

NOTE: THE PUMPS SHALL BE SUBMERSIBLE SEWAGE PUMPS WITH THE FOLLOWING PERFORMANCE REQUIREMENTS FOR EACH PUMP:  
CAPACITY 500 G.P.M. EA.  
DESIGN T.D.H. 94 FT.  
MAXIMUM SPEED 1750 R.P.M.  
MIN. MOTOR EFFICIENCY 78%

AS BUILT

DATE	REVISION	MADE	CHKD	APPD		
<b>CARTER &amp; BURGESS, INC.</b> ENGINEERS - PLANNERS - SURVEYORS DALLAS TEXAS						
<b>RAWHIDE CREEK LIFT STATION</b> <b>AND FORCE MAIN</b> <b>LIFT STATION DETAILS</b>						
TOWN OF ADDISON, TEXAS						
DESIGN	DRAWN	CKD.	SCALE	DATE	FILE	NO.
LINDNER	BARR HULEN	LINDNER	AS NOTED	AUG. '92	01-1457	10 of 13



John H. Lindner  
8/17/92