

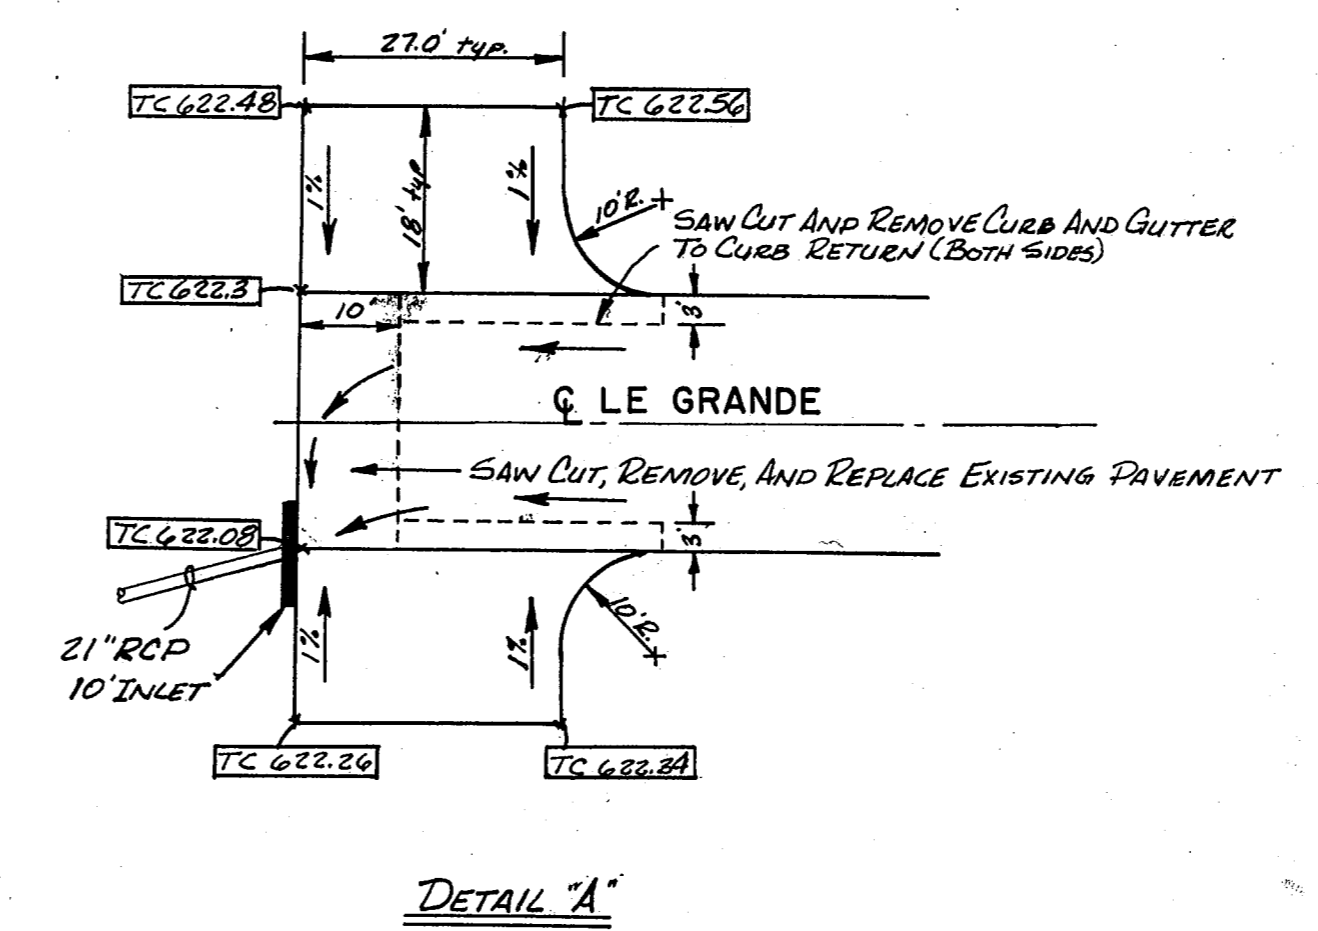
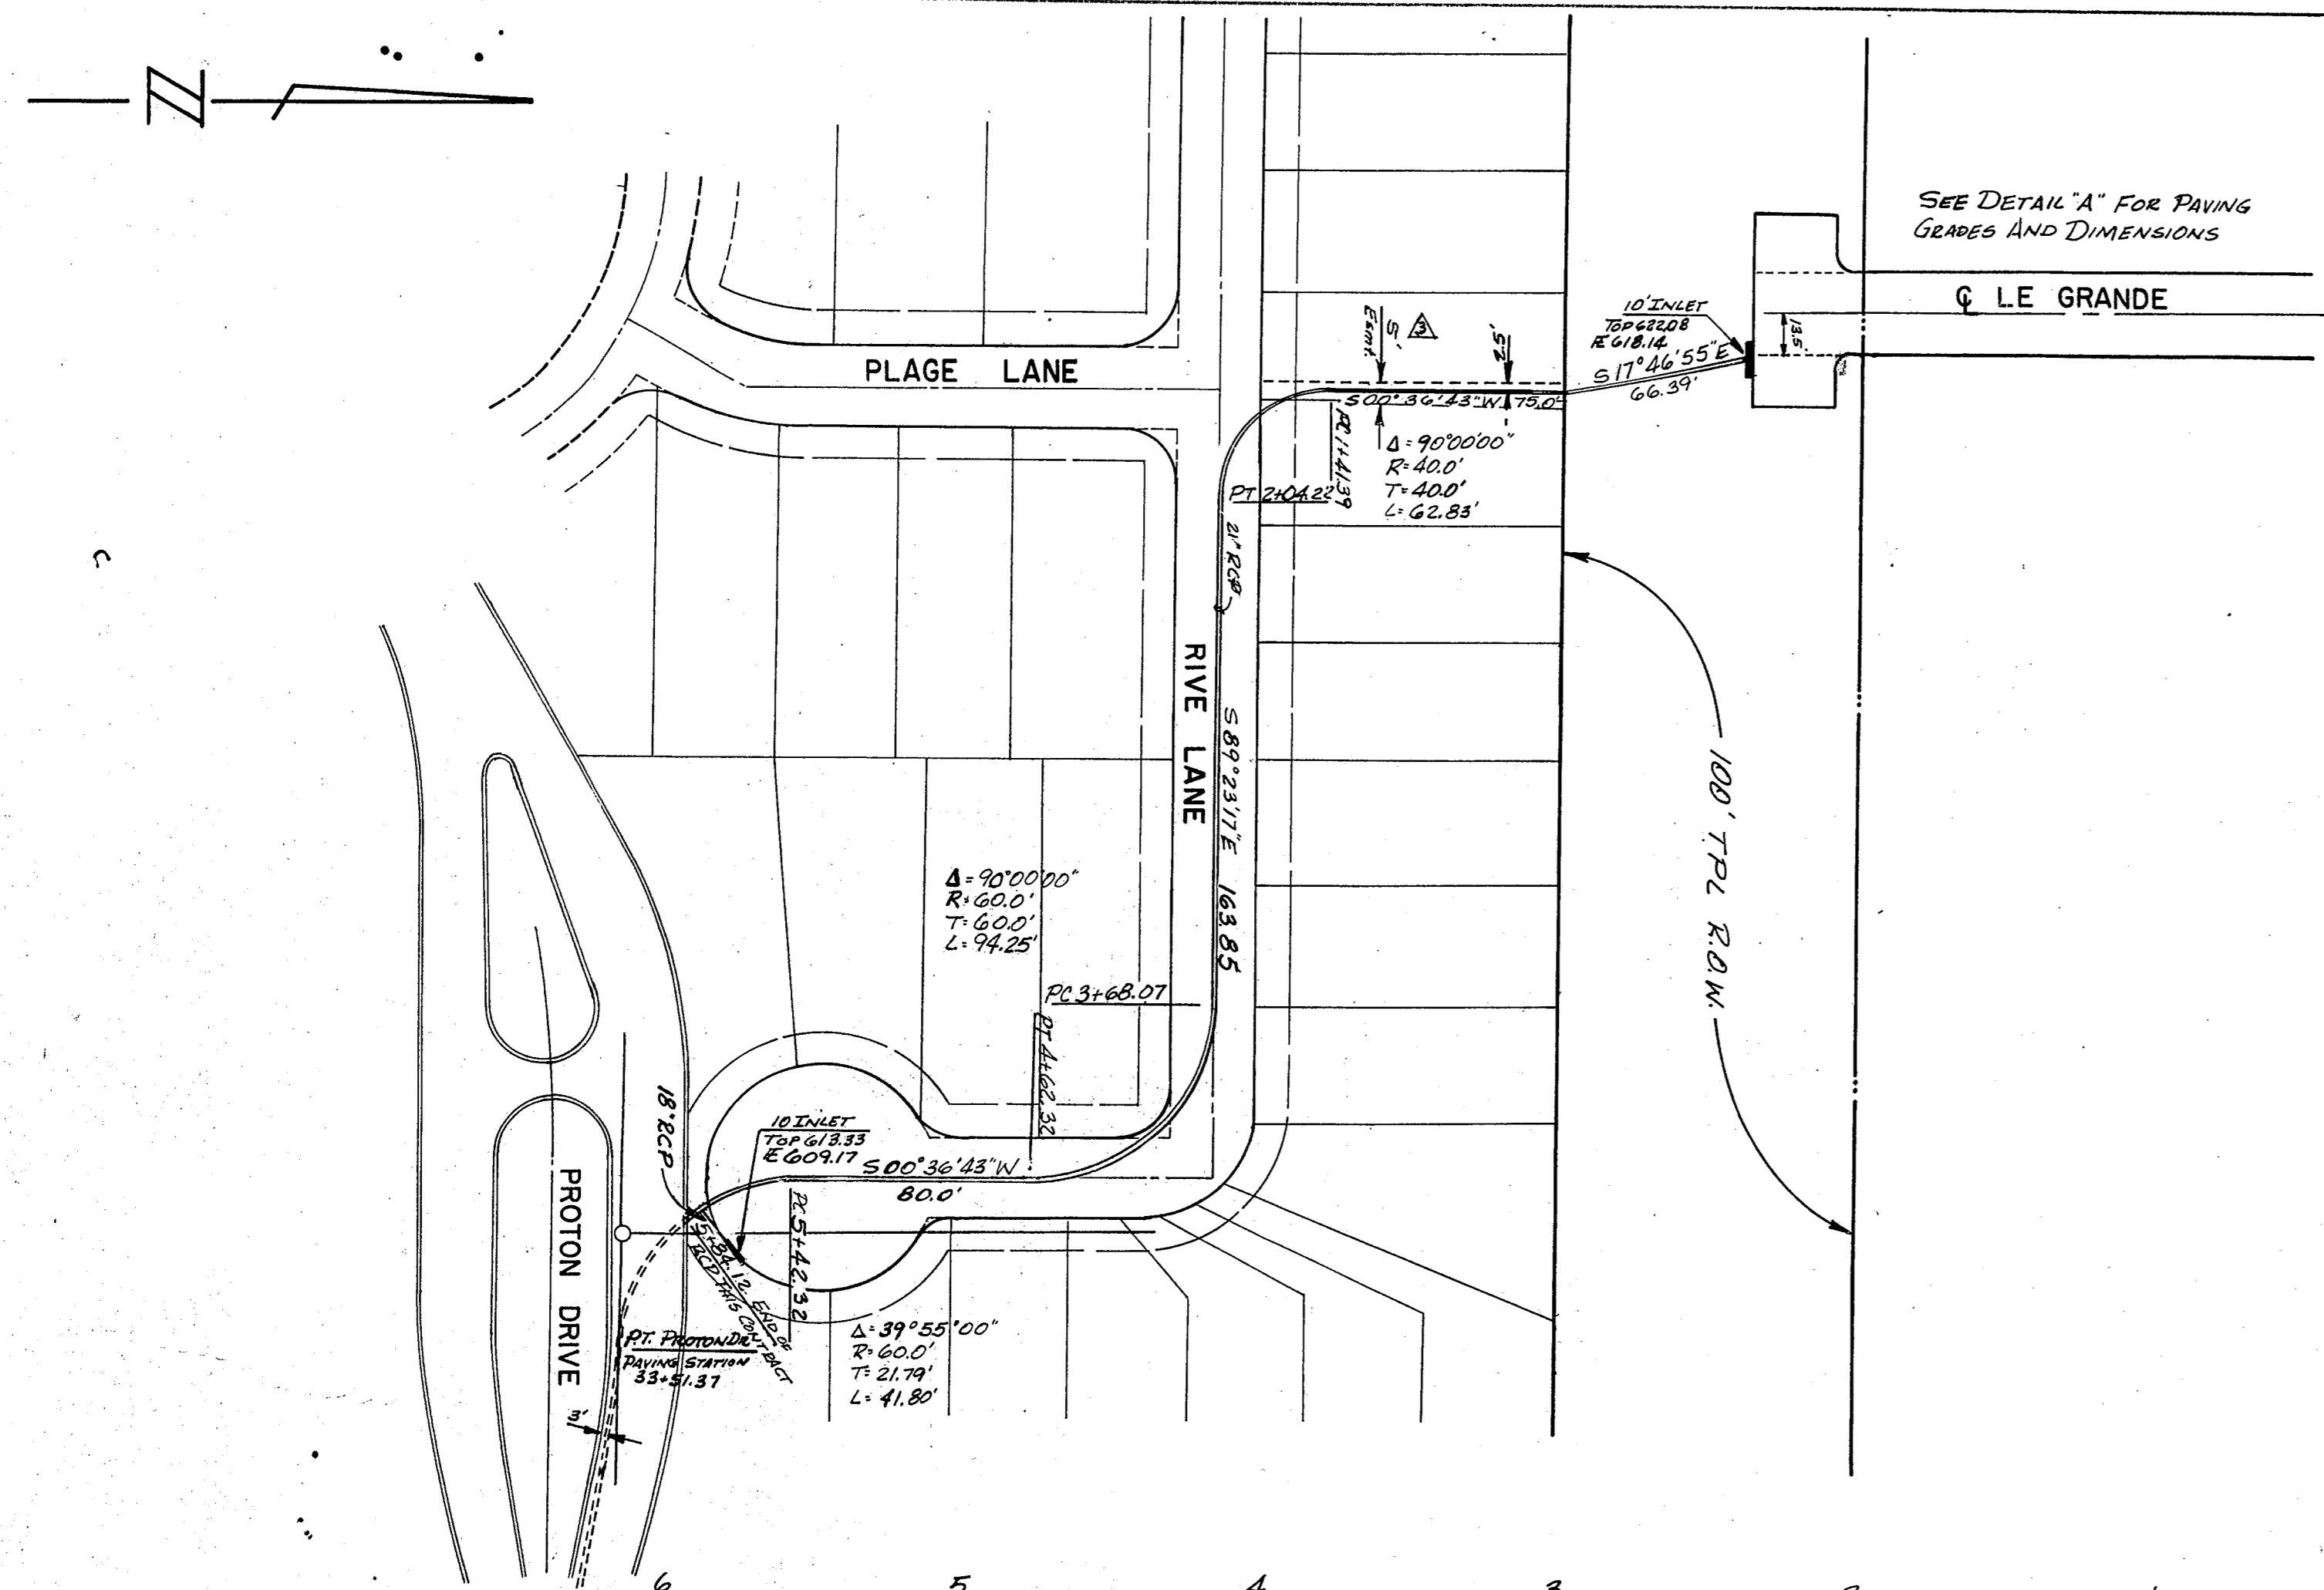


DATE
BY
SURVEYED
NOTED
CHECKED
NOTE BOOK
No.

DATE
BY
SURVEYED
NOTED
CHECKED
NOTE BOOK
No.

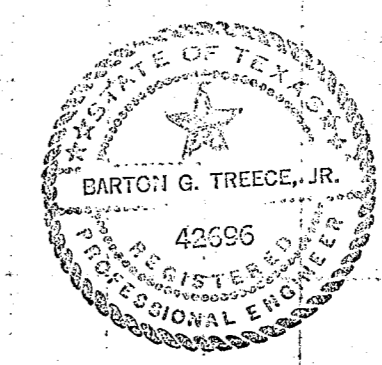

REVISIONS
 △ GENERAL REVISIONS AS PER CITY OF ADDISON - 11/13/81
 △ STREET NAME CHANGES - 11/20/81
 △ 10" STORM SEWER & WATER ESMT. CHANGED TO 5" STORM SEWER ESMT.

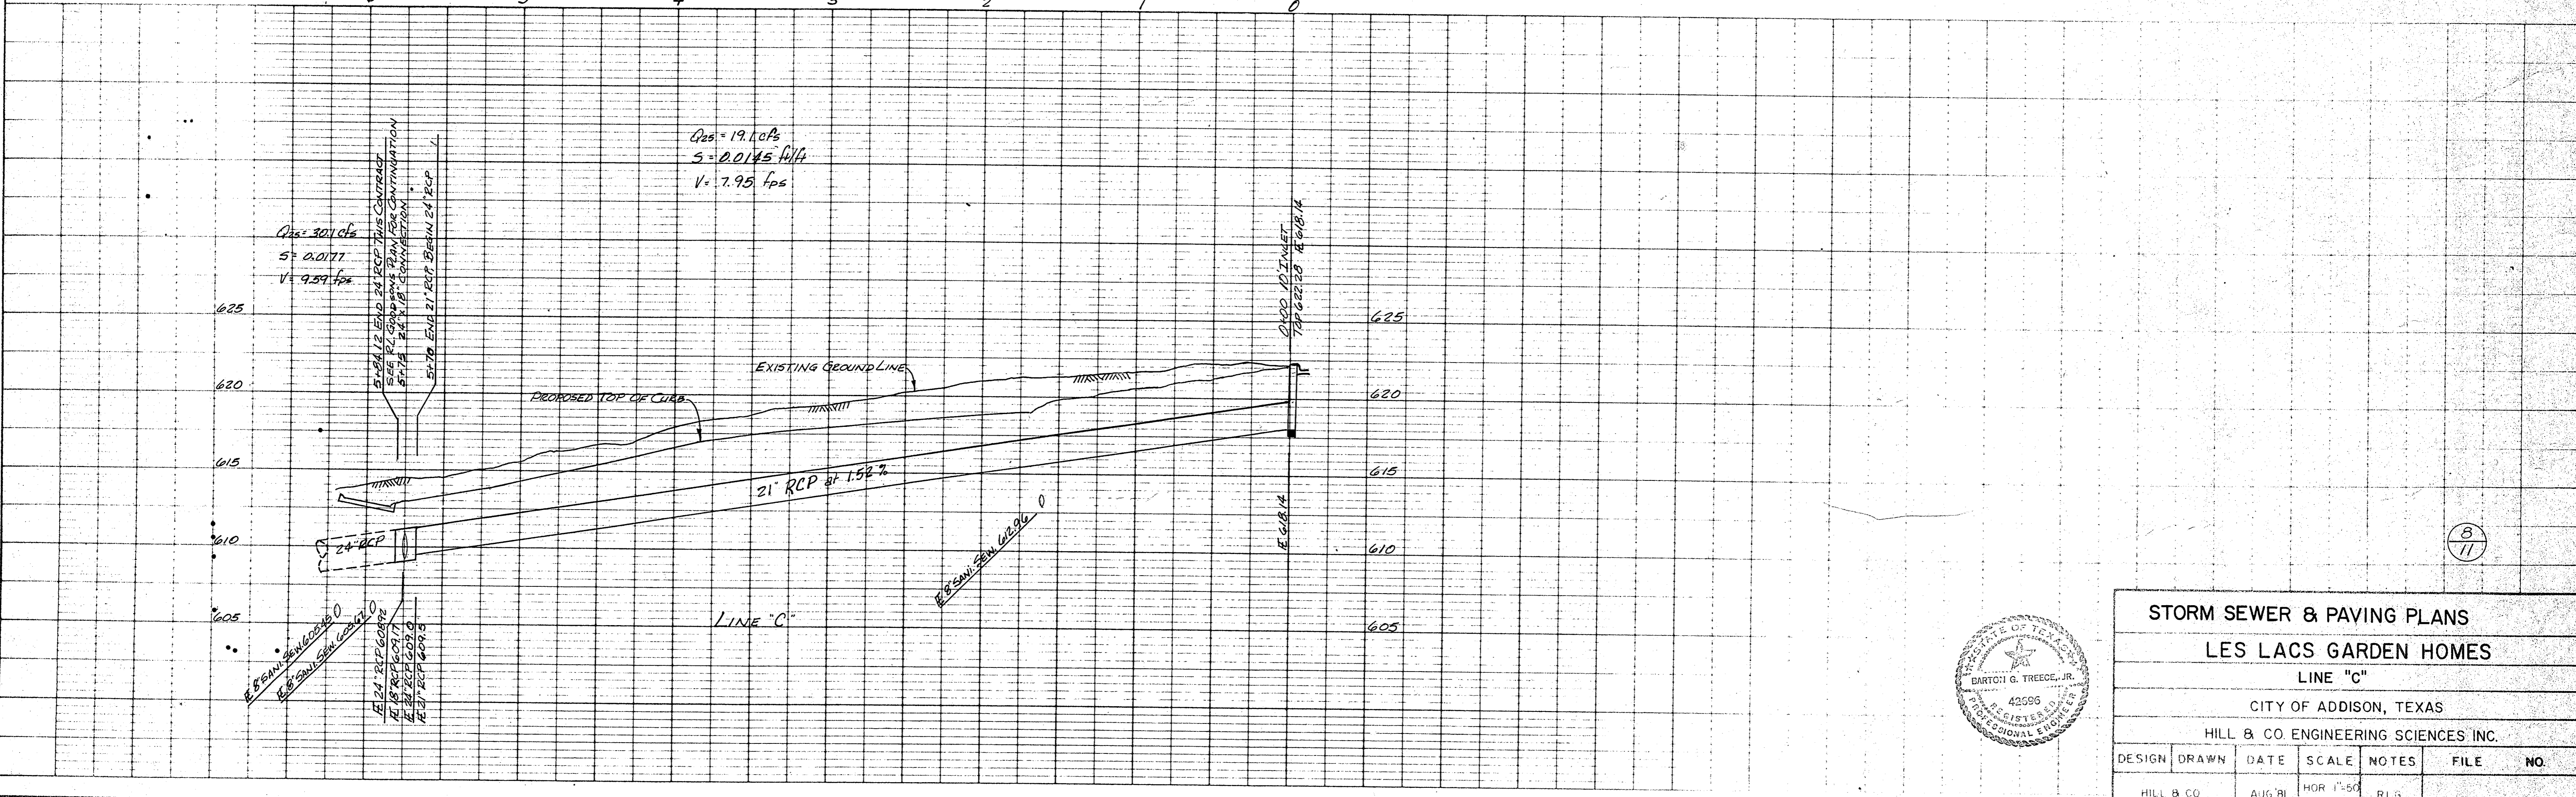

STORM SEWER & PAVING PLANS					
LES LACS GARDEN HOMES					
LINE "C"					
CITY OF ADDISON, TEXAS					
HILL & CO ENGINEERING SCIENCES INC.					
DESIGN	DRAWN	DATE	SCALE	NOTES	FILE NO.
HILL & CO		AUG'81	HOR 1"=50' VERT 1"=5'	RLG	