

EDI ARCHITECTS, INC.
 ARCHITECTURE PLANNING ENGINEERING INTERIOR DESIGN
 AMERICAN BANK TOWER
 840 WALNUT HILL LANE
 SUITE 700 DALLAS, TEXAS 75205
 AUSTIN, TEXAS 78708
 512 489-9208

TOWN OF ADDISON
ADDISON


ADDITION TO PUBLIC WORKS SERVICE CENTER
 Westgrove Road
 Addison Texas

DATE 5-18-86
 11 JUNE 86
 24 JULY 1986 - BID

SHEET NO
A2.1
 OF SHEETS
 JOB NO. 851-137

TOWN OF ADDISON
BUILDER'S COPY OF PLANS
 This set of plans contains various corrections and comments made by the City Staff. All trades will be required to comply with these corrections and comments; failure to inform all trades of this information will not be accepted as a reason to approve construction which is in violation of local ordinances.
 This set of plans is to be kept on the job site at all times and is to be made available for use by city inspectors at their request. Failure to have these plans available may delay approval of a requested inspection.

1. 1HR. OR 2 HR. RATED WALLS TO DECK OR TO CEILING IF 1HR. OR 2HR. ASSEMBLY USED. ~~FLOOR TO FLOOR~~
2. ALL FIRE RATED DOORS MUST BE SELF-CLOSING W/ CASSETS.
3. Five extinguishers:
 minimum 2A 10BC
 Minimum of 1 per 3000^{sq}
 maximum travel distance of 75' to any extinguisher

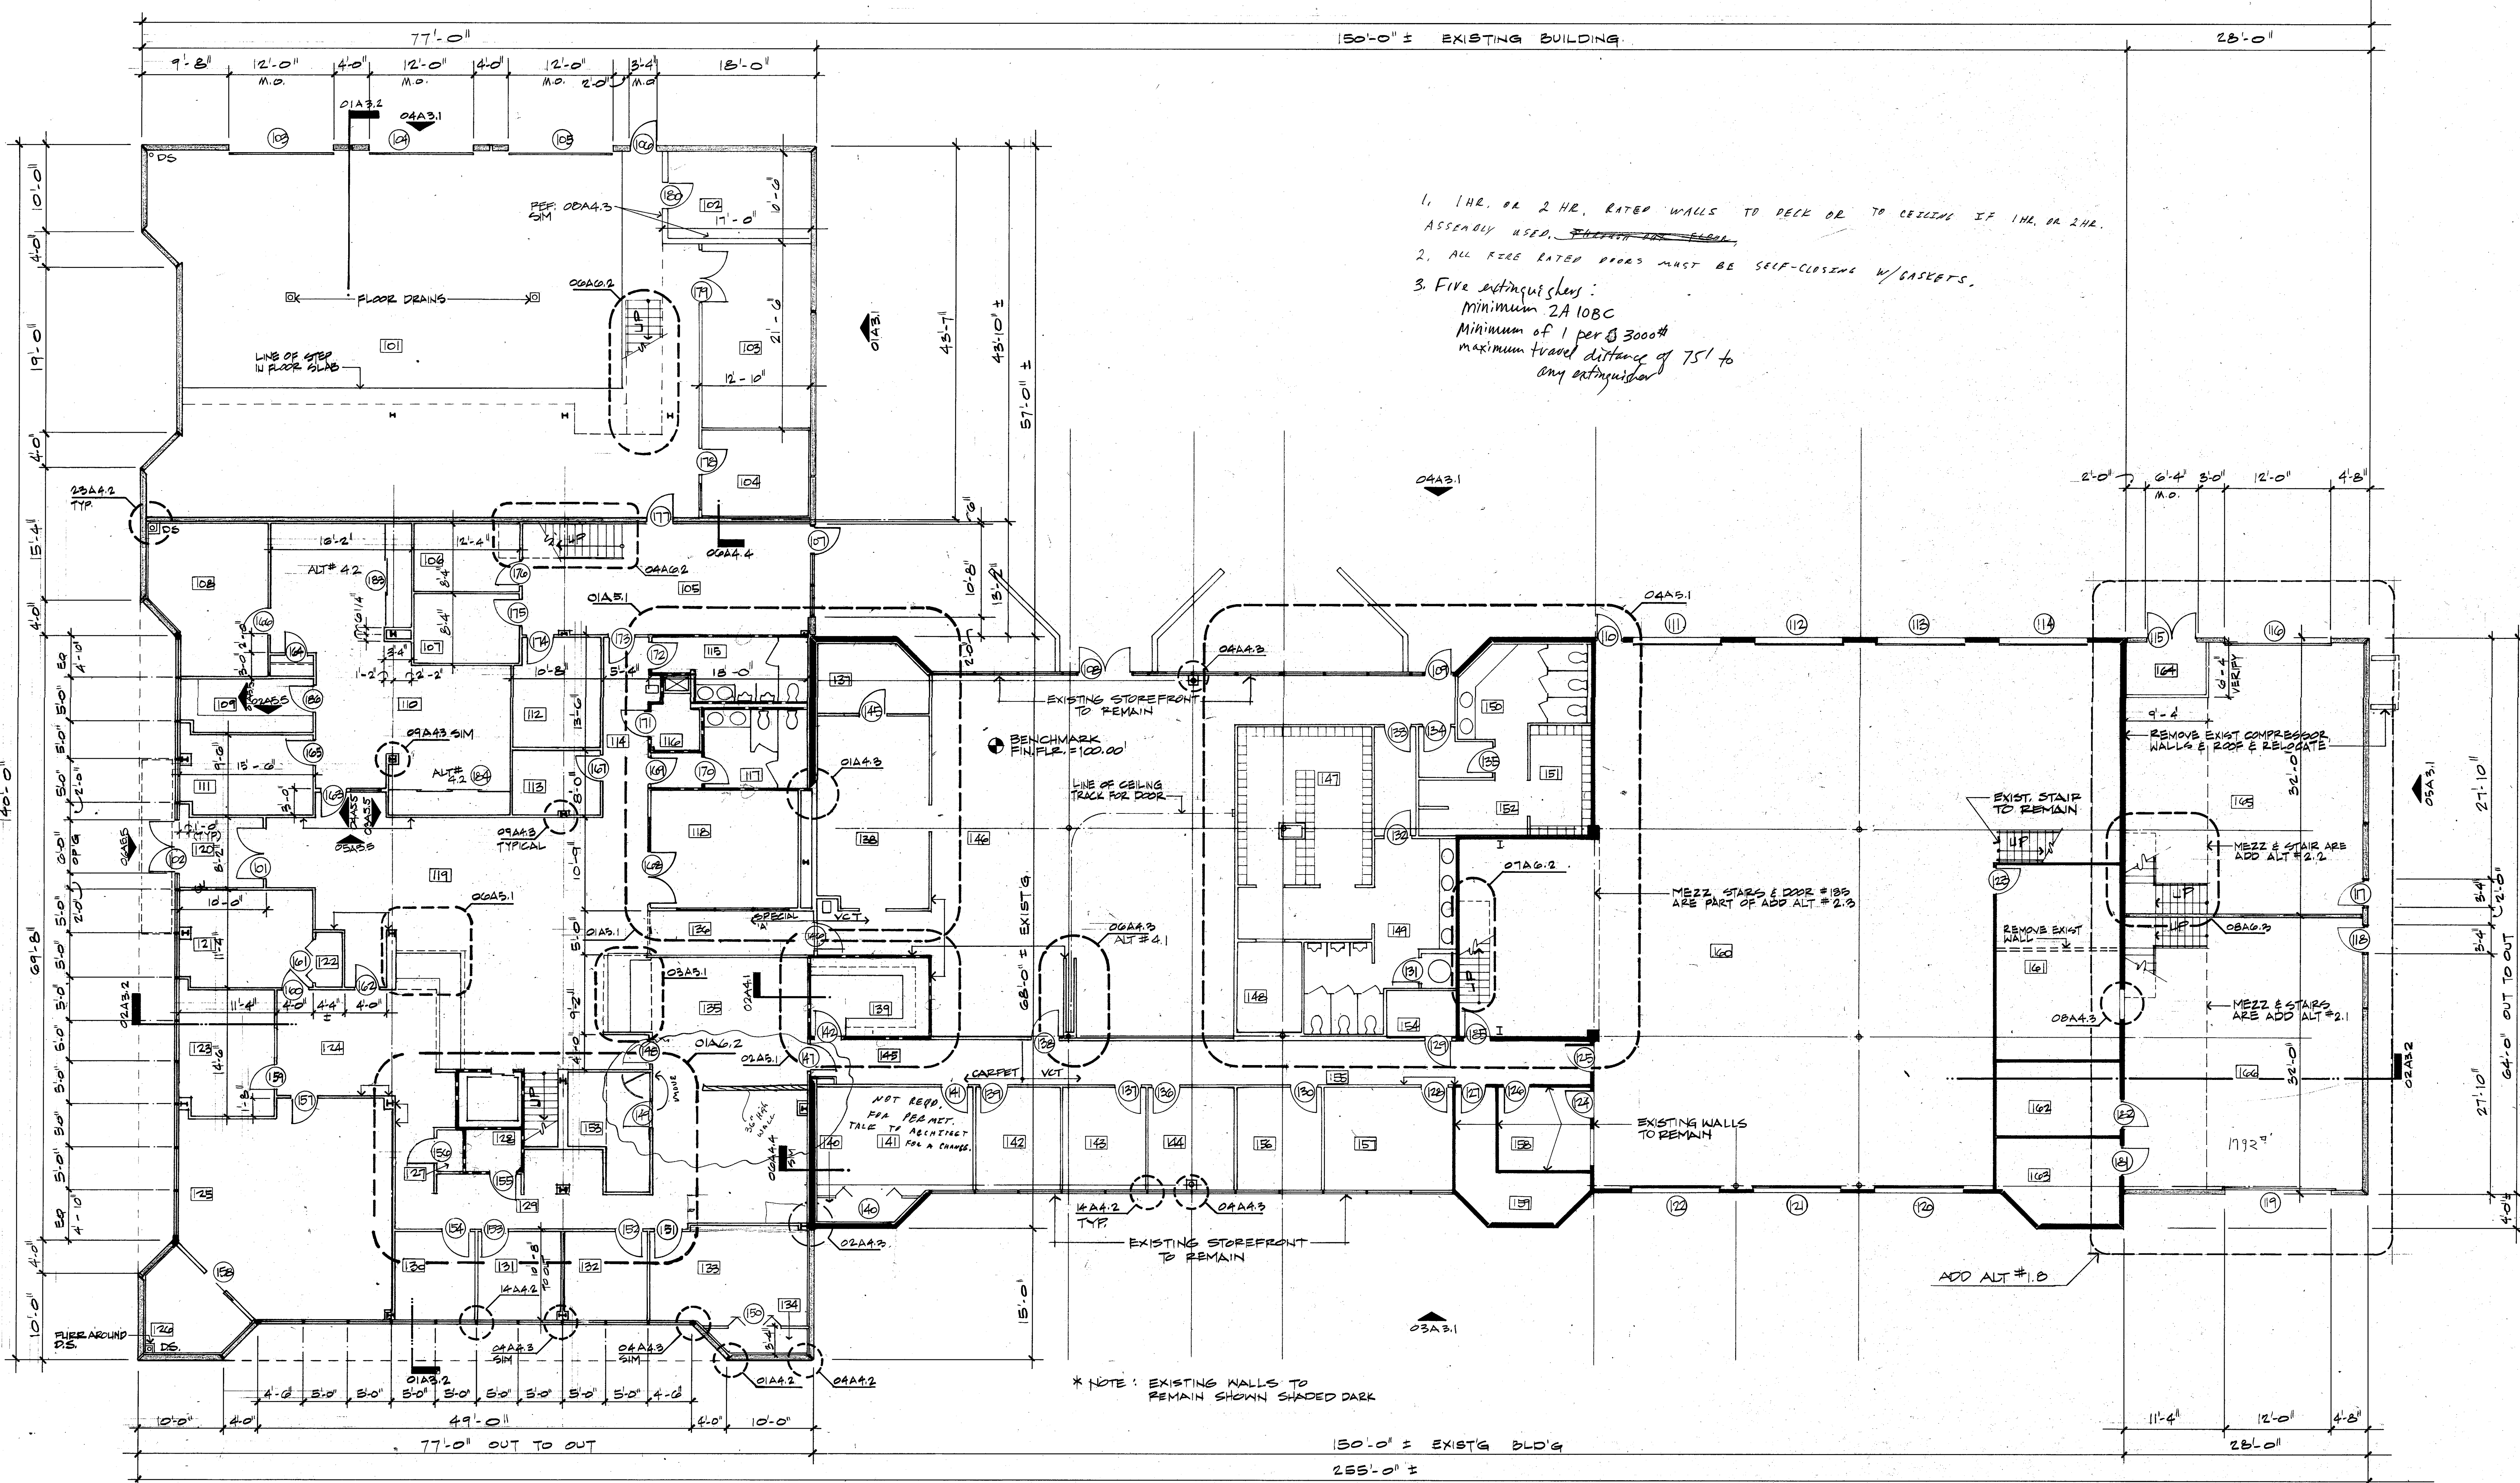

01 FIRST FLOOR PLAN
 A2.1 1/8" = 1'-0"



A
B
C
D
E
F
G
H
J
K
L
M
N
O
P
Q
R
S
T
U
V
W
X
Y
Z