


TOWN OF ADDISON
BUILDER'S COPY OF PLANS


This set of plans contains various corrections and comments made by the City Staff. All trades will be required to comply with these corrections and comments; failure to inform all trades of this information will not be accepted as a reason to approve construction which is in violation of local ordinances.

This set of plans is to be kept on the job site at all times and is to be made available for use by city inspectors at their request. Failure to have these plans available may delay approval of a requested inspection.

A B C D E F G H I J K L M N O P Q R S T U V W X Y Z

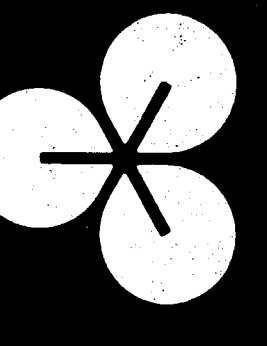

EDI ARCHITECTS, INC.
ARCHITECTURE PLANNING ENGINEERING INTERIOR DESIGN
8440 WALNUT HILL LANE
SUITE 100 AUSTIN TEXAS 78751
214 / 780-1848
214 / 488-8208

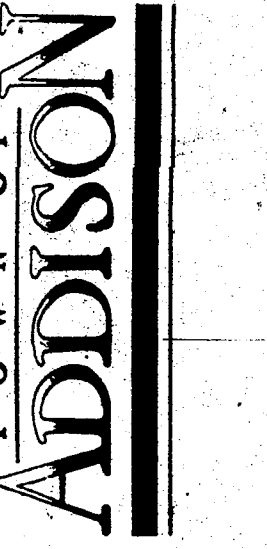

**ADDITION TO
PUBLIC WORKS SERVICE CENTER**
Westgrove Road
Addison Texas

DATE: 5-16-86
11 JUNE 86
24 JULY 1986 - BID

SHEET NO:
A5.1
OF SHEETS
JOB NO: 851-137