


- NOTES:**
- CONNECT TO EXISTING THREE-WAY SWITCH AT LOCATION SHOWN.
 - ALL 2' x 4' FLUORESCENT LIGHT FIXTURES IN THIS ROOM/ AREA ARE RELOCATED EXISTING.
 - REWIRE LIGHTING IN THIS ROOM TO CONTROL ALL LIGHTS FROM EXISTING SWITCH AT DOOR.
 - TO EXISTING 120/240V, 1P, 3W PANEL IN ROOM 150, PROVIDE NEW 20A, 1P CIRCUIT BREAKER.
 - TO NEXT AVAILABLE 20A, 1P CIRCUIT BREAKER IN EXISTING 120/240V, 1P, 3W PANEL IN WAREHOUSE.
 - NO EXIST. EMERGENCY Ltg. CIRCUIT IN WAREHOUSE.
 - ALL EXISTING LIGHT FIXTURES TO BE RE-USED SHALL BE CLEANED AND LEFT IN GOOD OPERATING CONDITION AFTER BEING INSTALLED IN NEW LOCATION. REPLACE LAMPS AND BALLASTS AS REQUIRED.
 - TO SWITCH 'X'.

TOWN OF ADDISON
BUILDER'S COPY OF PLANS
 This set of plans contains various corrections and comments made by the City Staff. All trades will be required to comply with these corrections and comments. Failure to inform the City Staff of this information will not be accepted as a reason for construction which is in violation of local ordinances.
 This set of plans is to be kept on the job site at all times and is to be made available for use by city inspectors at their request. Failure to have these plans available may delay approval of a requested inspection.

ADD ALT # - REMOVE ALL EXIST. INCANDESCENT LIGHTS IN EAST SOFFIT & REPLACE W/ TYPE 'K' FIXTURES. CIRCUIT TO H-18 VIA TIME SWITCH TO-A.

01
E2.2
FIRST FLOOR PLAN- LIGHTING

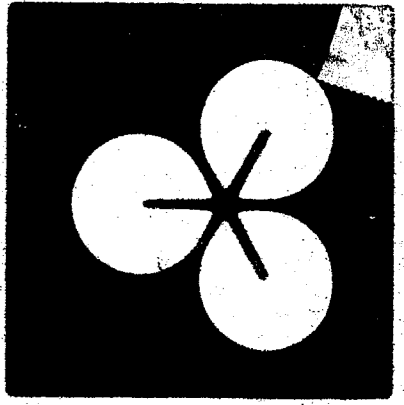

EDI ARCHITECTS, INC.
 ARCHITECTURE PLANNING ENGINEERING INTERIOR DESIGN
 8440 WALNUT HILL LANE
 SUITE 100
 DALLAS, TEXAS 75245
 TEL. 754-888-8300

TOWN OF ADDISON

ADDITION TO PUBLIC WORKS SERVICE CENTER
 Westgrove Road
 Addison Texas

11 JUNE 86
 24 JULY 1986 - BID

SHEET NO.
E2.2
 SHEETS
 JOB NO: 881-137