

PLUMBING ISSUED IN FULL SCALE CONTRACTS
 NO UTILITIES TO BE
 INSTALLED UNTIL THE
 FOLLOWING PLANS ARE SUBMITTED
 AND APPROVED BY ENGINEER
 AND UTILITY COMPANIES.

1. COMPLETE SITE PLANS
2. P-1 (REVISED PLUMBING PLANS)
3. SITE UTILITY PLANS
4. SITE LAYOUT PLANS

INFORMATION REQUIRED:


- A. SITE DATA, STAIR, AND SERVICE LINE
- B. EX. ELECTRICAL
- C. MECHANICAL SYSTEMS + LOADS
- D. SITE + TYPICAL FLOOR
- E. LOADS

BY REQUEST BY CONTRACTOR
 6/16/86 (P. 1)

TOWN OF ADDISON
 BUILDER'S COPY OF PLANS
 This set of plans contains various corrections and comments
 made by the City Staff. All trades will be required to comply
 with these corrections and comments. Failure to inform
 all trades of this information will not be accepted as a reason
 to approve construction which is in violation of local
 ordinances.
 This set of plans is to be kept on the job site at all times
 and is to be made available for use by city inspectors at
 their request. Failure to have these plans available may
 delay approval of a requested inspection.

1. SUBMIT ROOF DRAIN/STORM SEWER PLANS
2. EX. EL. PIPES & COMM. SEWER PLANS
3. SIZE & TYPE PIPE GRADES

1. STACK ALL PLUMBING.
2. KEEP SANITARY AND STORM SEPARATE.
3. ALL DRAINS IN GARAGE AND CLEAN UP AREA MUST GO THROUGH THE SAND TRAP, SAND TRAP TIES TO SANITARY.
4. AREA DRAINS FOR VEHICLE CLEAN UP MUST BE UNDER COVER.
5. SMALLEST FLOOR DRAIN, AREA DRAIN, IN HUB DRAIN ALTHOUGH IS 3" MAIN LINE SHOULD BE MIN. OF 4".

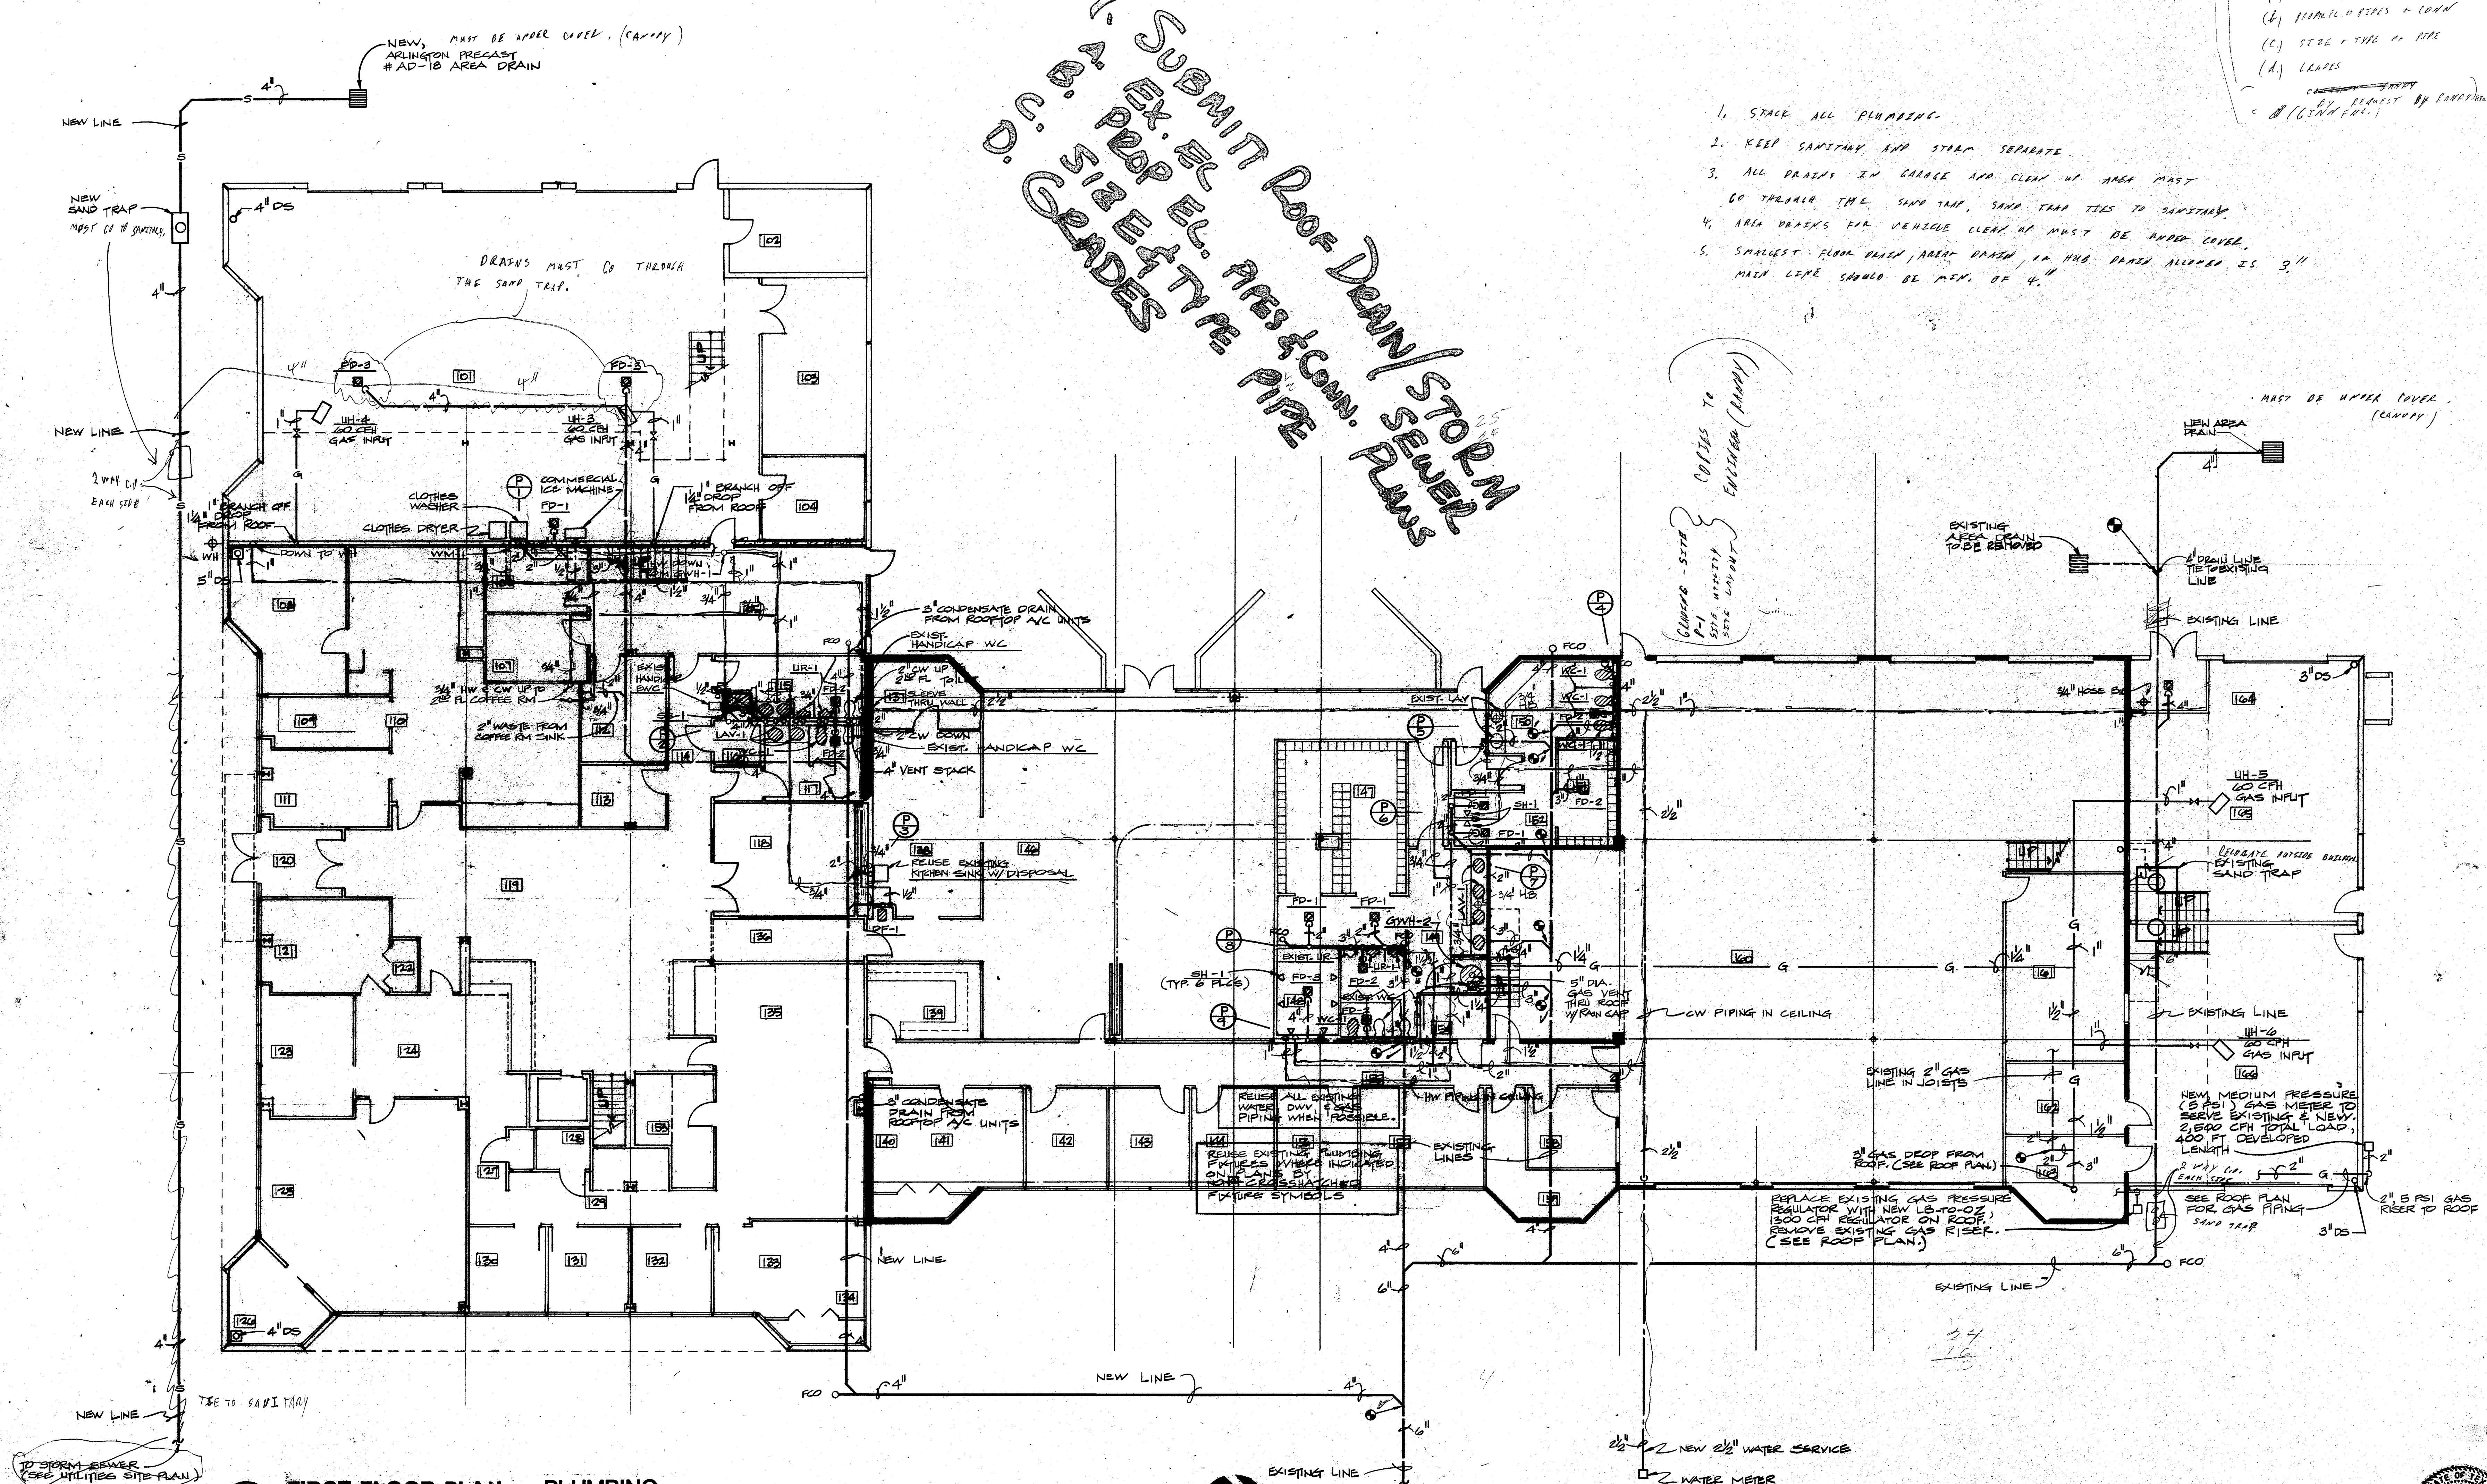

01 FIRST FLOOR PLAN - PLUMBING
 P2.1



INTERFIELD ENGINEERING CO.
 CONSULTING ENGINEERS
 840 N. CENTRAL EXPWY.
 SUITE 340
 DALLAS, TEXAS 75206
 (214) 628-6864

EDI ARCHITECTS, INC.
 ARCHITECTURE PLANNING ENGINEERING INTERIOR DESIGN
 6440 WALNUT HILL LANE
 SUITE 100
 DALLAS, TEXAS 75201
 512 496-6308

TOWN OF
ADDISON

**ADDITION TO
 PUBLIC WORKS SERVICE CENTER**
 Westgrove Road
 Addison Texas

DATE:
 11 JUNE 86 -
 24 JULY 1983 - BID

SHEET NO.
P2.1
 OF SHEETS
 JOB NO: 851-137