

EDI ARCHITECTS, INC.
 ARCHITECTURE PLANNING ENGINEERING INTERIOR DESIGN
 8440 WALNUT HILL LANE
 SUITE 100
 DALLAS, TEXAS 75205
 812 / 750-1955

TOWN OF
ADDISON

**ADDITION TO
 PUBLIC WORKS SERVICE CENTER**
 Westgrove Road
 Addison Texas

DATE
 11 JUNE 86
 24 JULY 1986 - BID



SHEET NO.
P2.2

OF SHEETS
 JOB NO: 851-131

**TOWN OF ADDISON
 BUILDING COPY OF PLANS**

This set of plans contains various corrections and comments made by the City Staff. All trades will be required to comply with these corrections and comments. Failure to inform the contractor of this information will not be accepted as a reason to approve construction which is in violation of local ordinances.

This set of plans is to be kept on the job site at all times and is to be made available for use by city inspectors at their request. Failure to have these plans available may delay approval of a requested inspection.

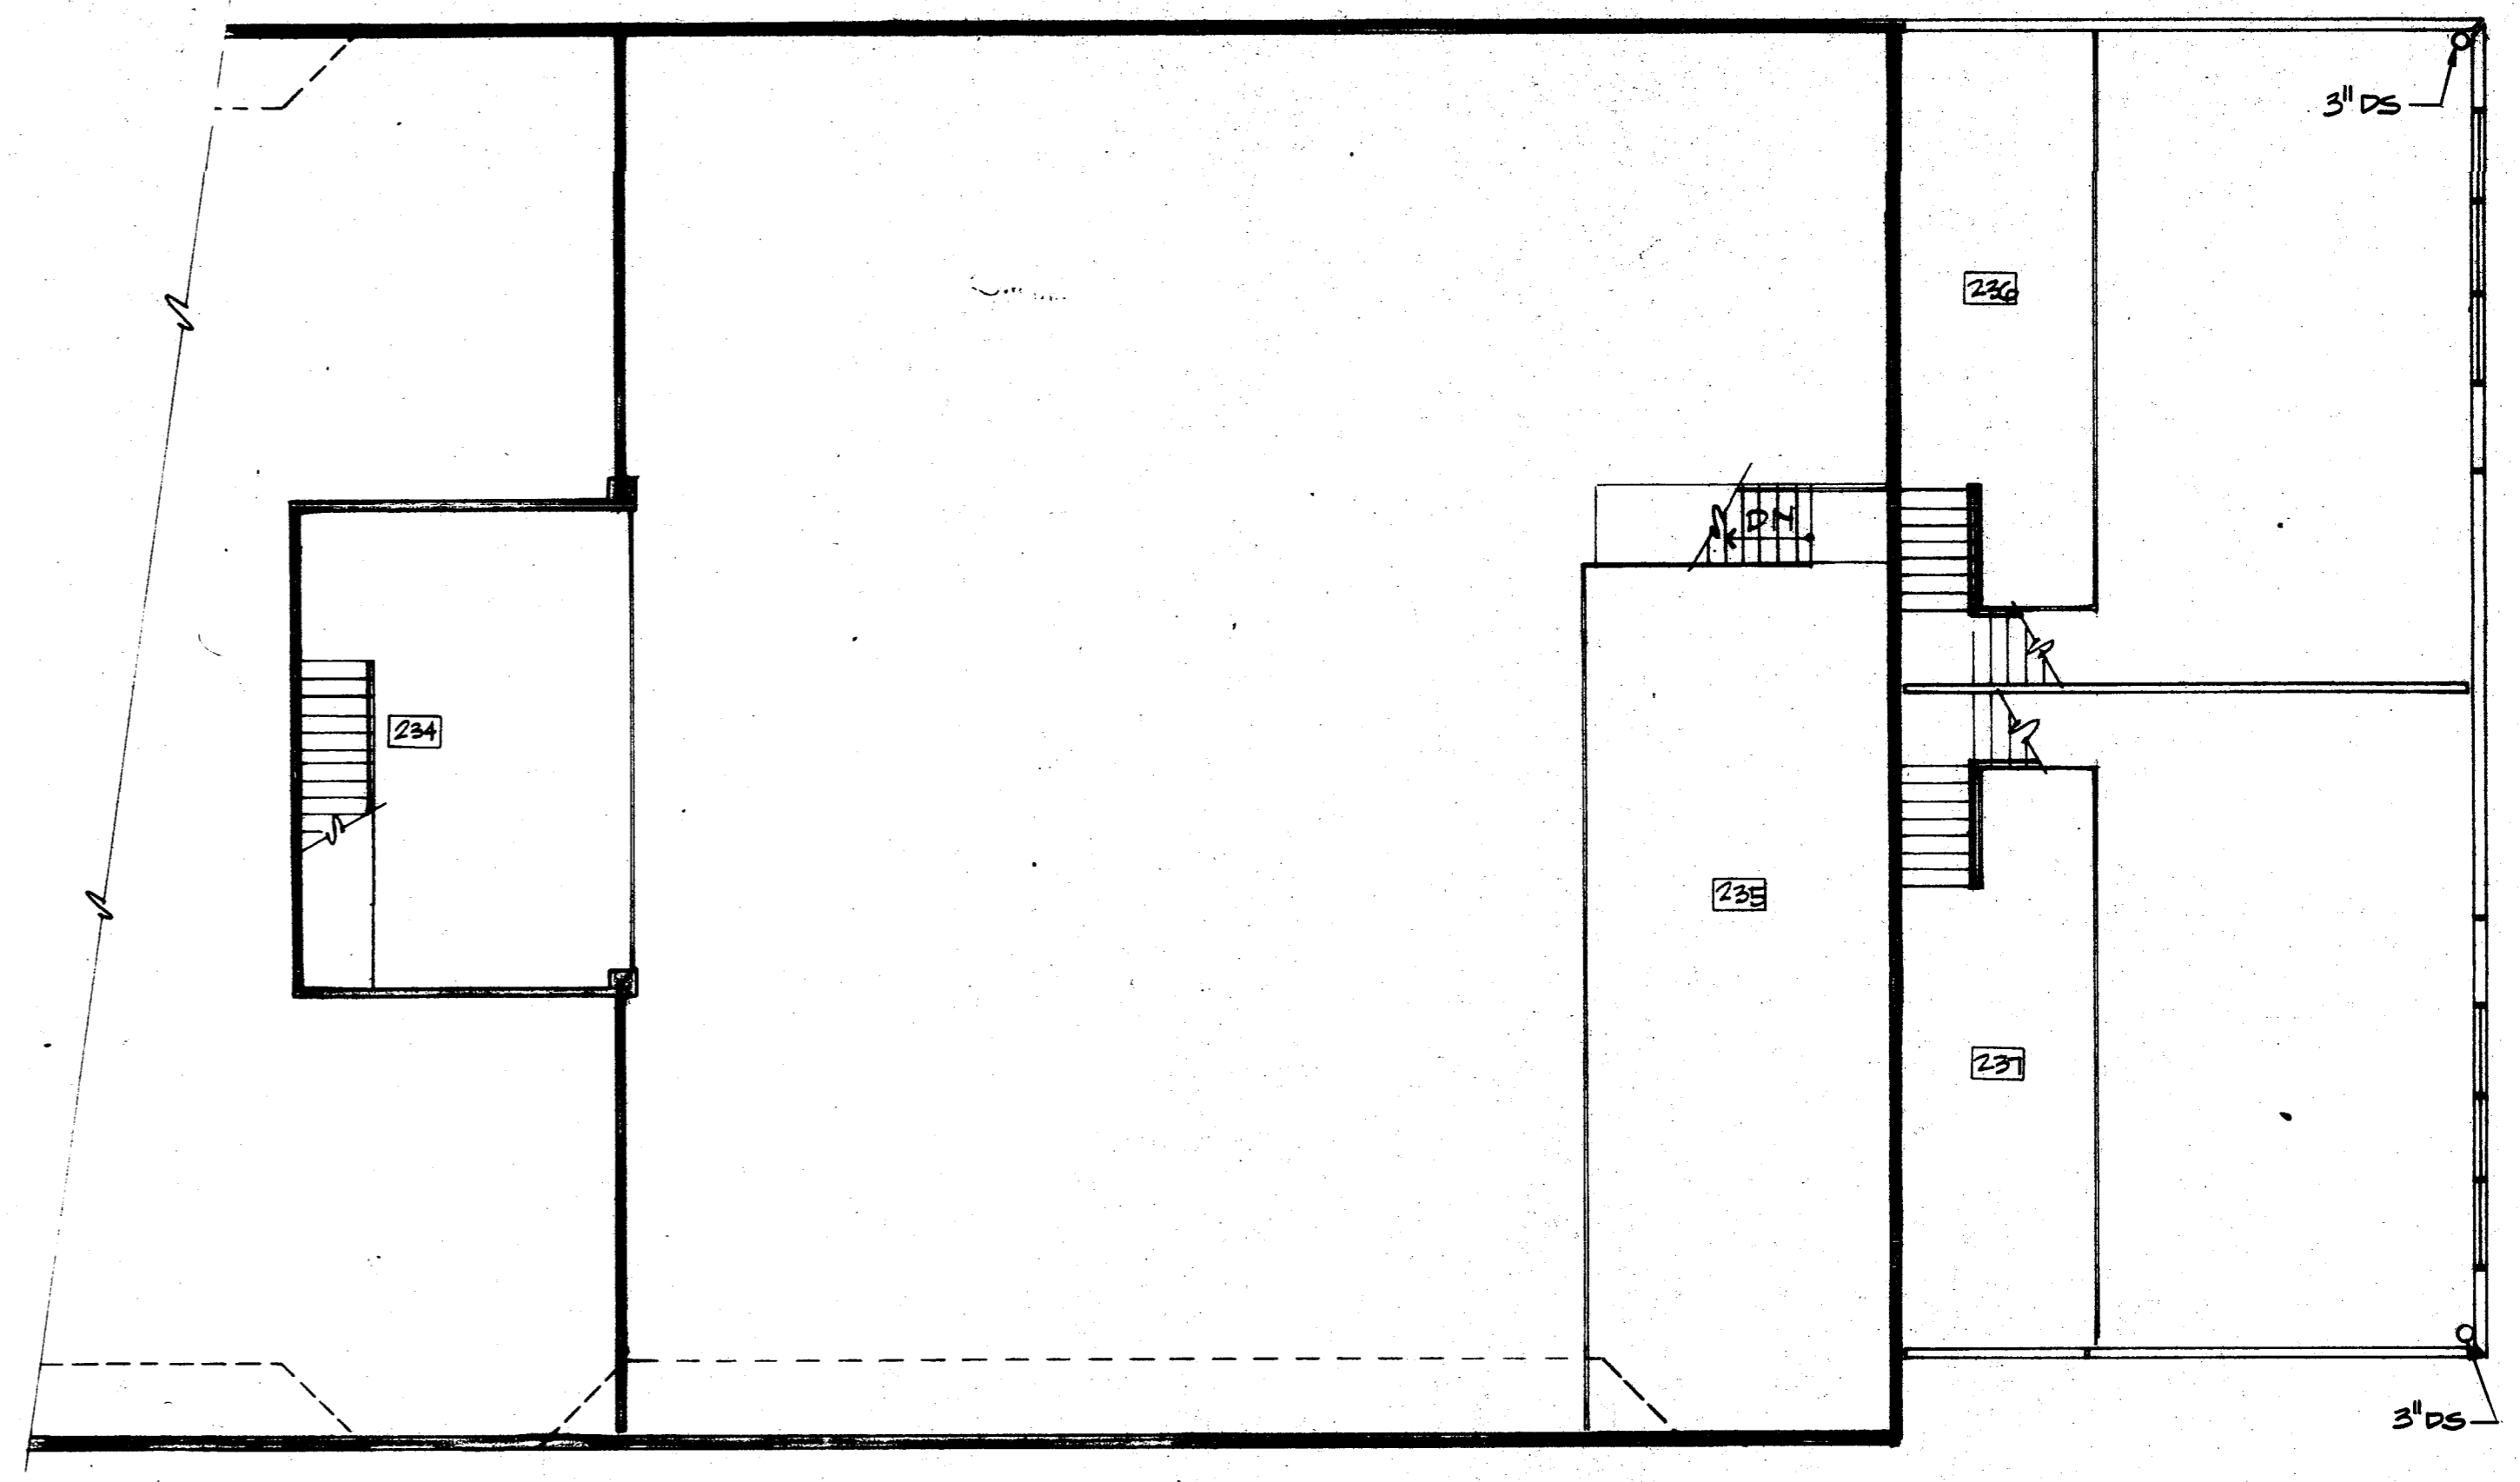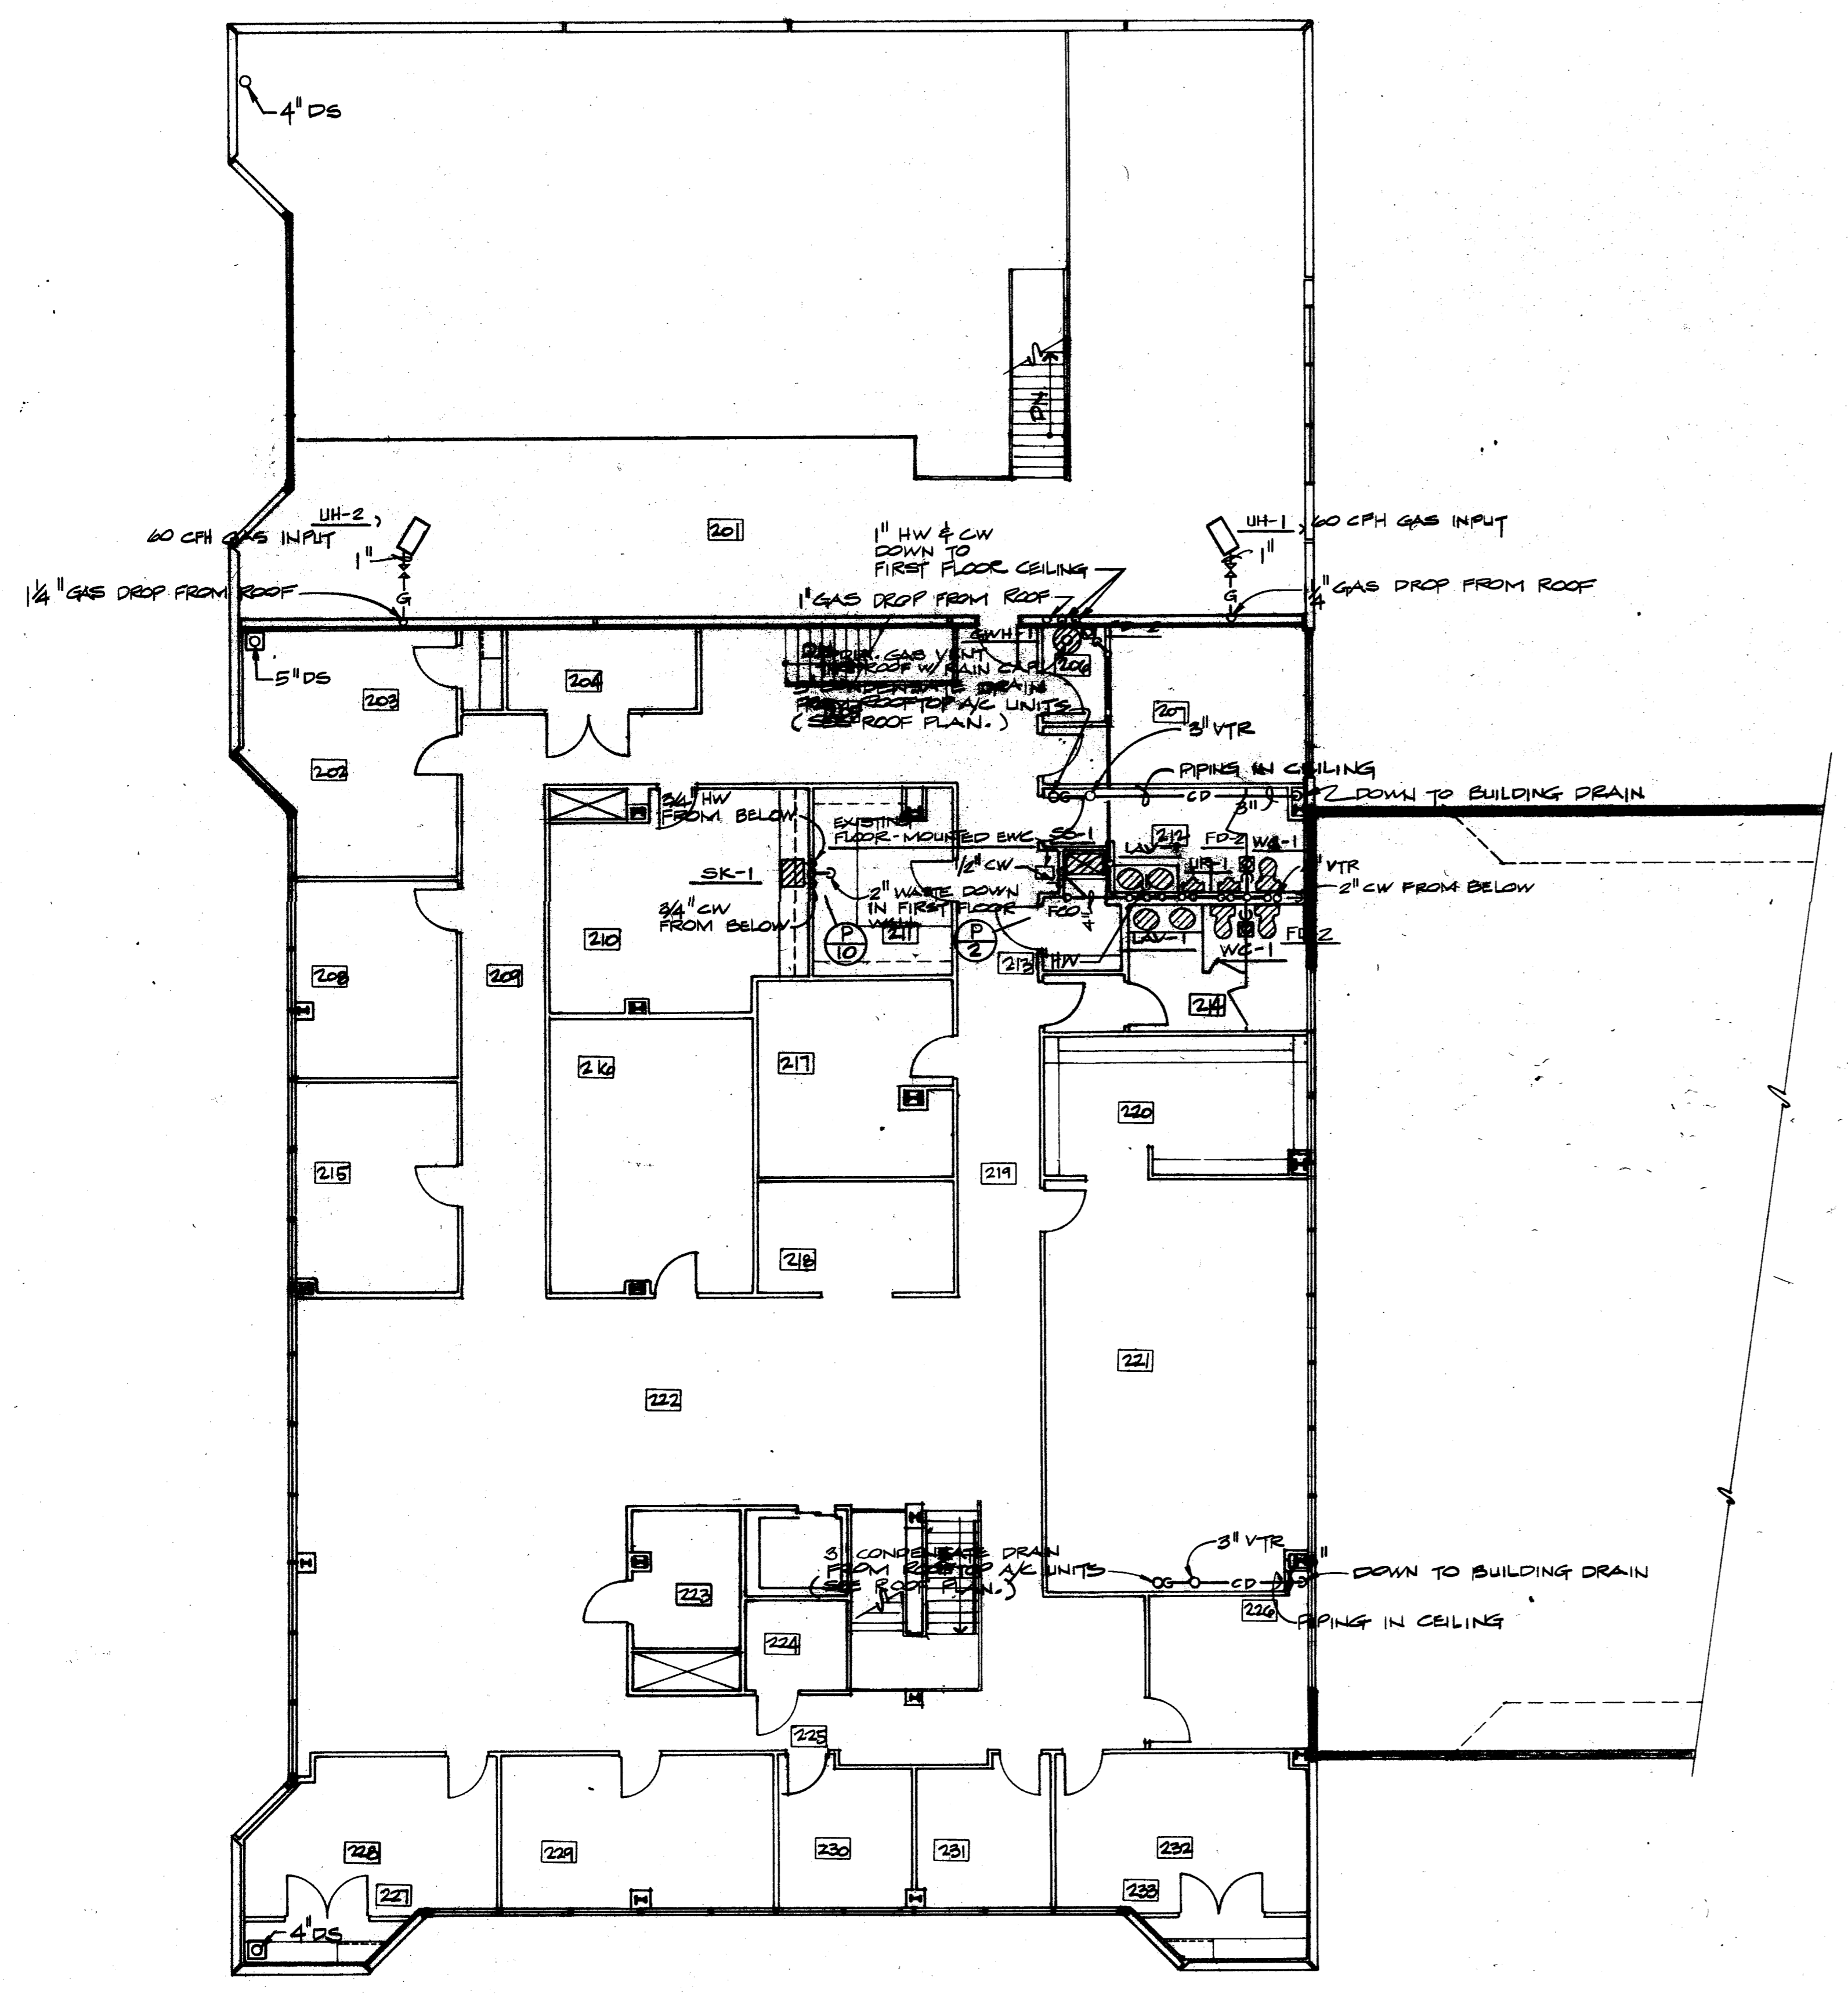

01 SECOND FLOOR PLAN - PLUMBING
 P2.2 1/8" = 1'-0"



INTERFIELD ENGINEERING CO.
 CONSULTING ENGINEERS
 5401 N. CENTRAL EXPWY.
 SUITE 340
 DALLAS, TEXAS 75205
 (214) 828-8854

