


A B C D E F G H I J K L M N O P Q R S T U V W X Y Z AA BB CC DD EE FF GG HH II JJ KK LL MM NN OO PP QQ RR SS TT UUU VV WW XX YY ZZ

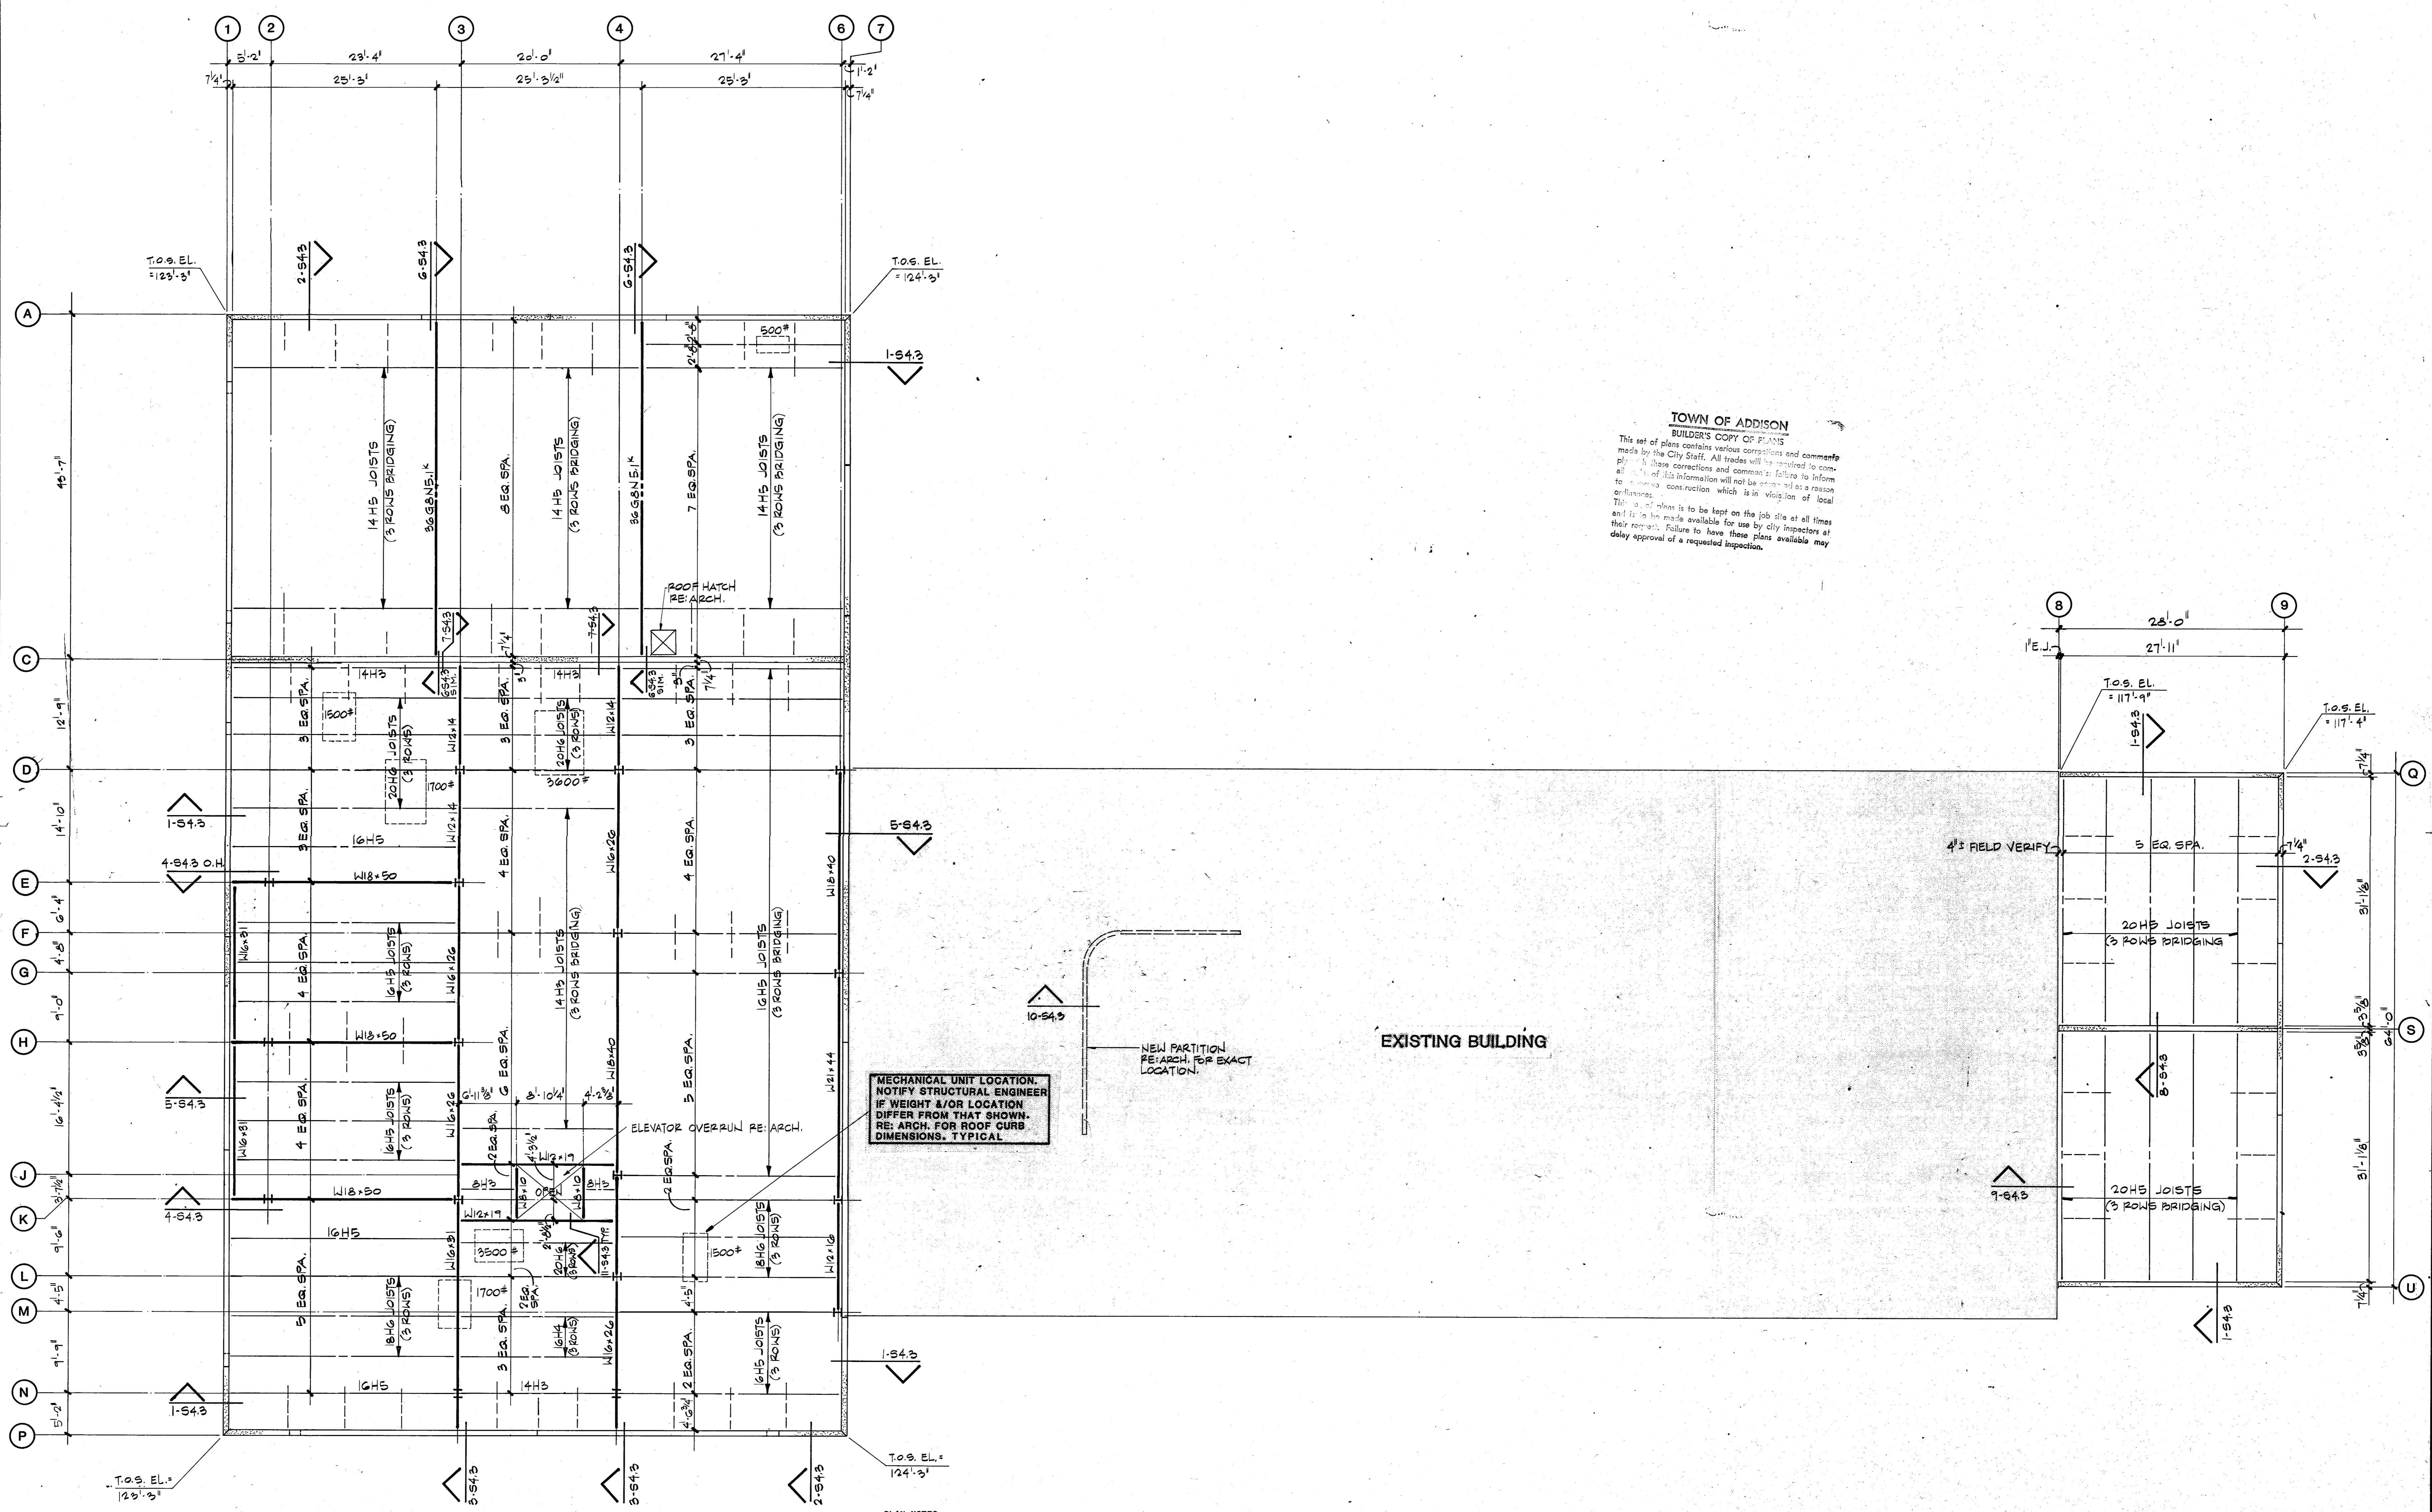

TOWN OF ADDISON
BUILDER'S COPY OF PLANS
 This set of plans contains various corrections and comments made by the City staff. All trades will be required to comply with these corrections and comments. Failure to inform all trades of this information will not be considered as a reason to a construction which is in violation of local ordinances.
 This set of plans is to be kept on the job site at all times and is to be made available for use by city inspectors at their request. Failure to have these plans available may delay approval of a requested inspection.

ROOF FRAMING PLAN
 SCALE: 1/8" = 1'-0"

- PLAN NOTES:
1. REFERENCE ELEVATION 100'-0" EQUALS SITE ELEVATION 657.50'.
 2. REFERENCE SHEET S1.1 FOR GENERAL NOTES AND TYPICAL DETAILS.
 3. REFERENCE SHEET S4.2 & S4.3 FOR FRAMING DETAILS.
 4. T.O.S. ELEV. = xxx'-x" INDICATES BOTTOM OF ROOF DECK.
 5. R.D. INDICATES ROOF DRAIN. RE: ARCH. FOR EXACT LOCATION AND DETAILS.

PRELIMINARY DRAWING
 NOT TO BE USED FOR CONSTRUCTION

INTERFIELD ENGINEERING CO.
 CONSULTING ENGINEERS
 5401 N. CENTRAL EXPWY.
 SUITE 340
 DALLAS, TEXAS 75205
 (214) 526-6854

ED I ARCHITECTS, INC.
 ARCHITECTURE PLANNING ENGINEERING INTERIOR DESIGN
 8440 WALNUT HILL LANE
 SUITE 100
 DALLAS, TEXAS 75201
 214 / 750-1985

TOWN OF ADDISON

ADDITION TO PUBLIC WORKS SERVICE CENTER
 Westgrove Road
 Addison, Texas

DATE:
 11 JUNE 86
 24 JULY 1986 - BID

SHEET NO:
S2.3
 OF SHEETS
 JOB NO: 851-137