


Paving, Drainage and Utility Plans

KNIGHT RENOVATIONS

Lot 2R, Block A - Westgrove and Airborn Addn.

Town of Addison, Texas

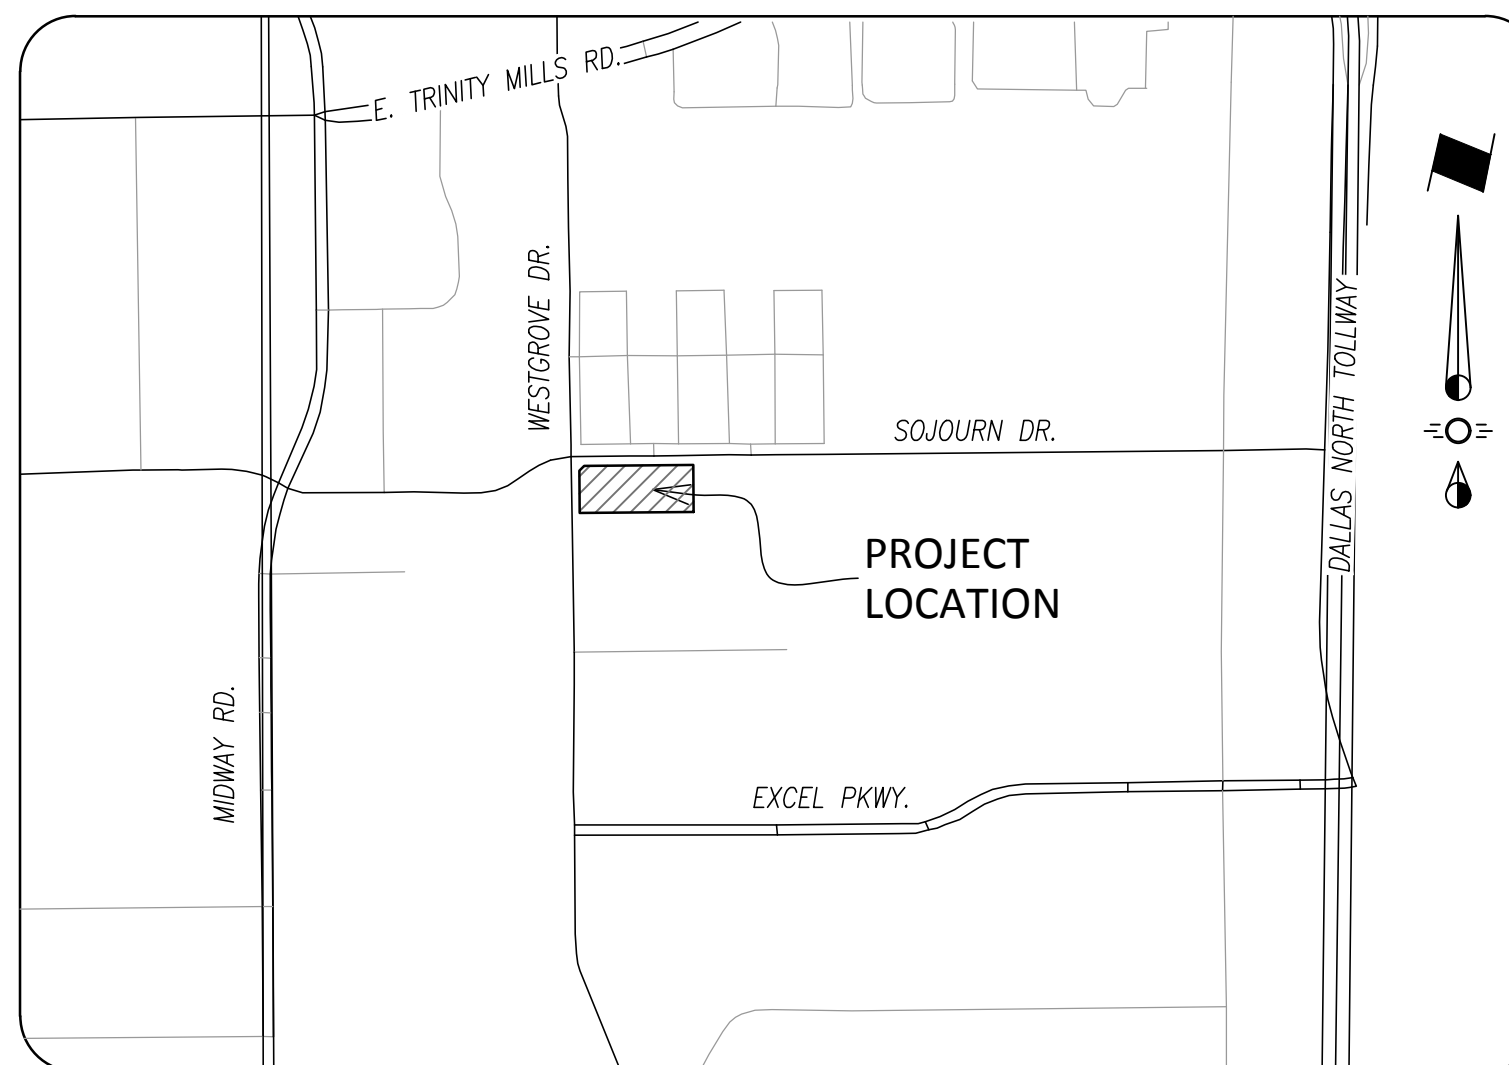

Vicinity Map
NTS

Notes:

1. Prior to beginning any construction or construction staking, it shall be the Contractor's responsibility to contact the civil engineer to ensure that all parties are in possession of the most current set of CD's.
2. All construction within Town of Addison R.O.W. or easements shall conform to Town Details available from Town of Addison Development Services Department.

Index Of Drawings

	Cover Sheet
	Replat
C 1	Paving & Horizontal Control Plan
C 2	Grading Plan
C 3	Drainage Area Map
C 3a	Sojourn Office Center Sh. C-4 (For Reference Only)
C 4	Drainage Plan
C 5	Storm Sewer Profiles
C 6	Utility Plan
C 7	Sanitary Sewer Profile
C 8	Erosion Control Plan
C 9	Stormwater Pollution Prevention Guidelines
C 10	Private Site Details
	Town Details
	Town Details
	Landscape Plan

Prepared By:



RECORD DRAWINGS

NOTE:
THESE PLANS HAVE BEEN REVISED TO CONFORM WITH
CONSTRUCTION RECORDS PROVIDED BY THE CONTRACTOR.

Prepared For:
Squire Properties, LLC
901 Waterfall Way Richardson, TX 75080
Telephone (469) 330-7838
Contact: John De Tiberiis