



Printed by: ibornett; Plot Date: 4/1/2016 8:05 AM

Drawing: C:\2016\2016-03-04\2016-03-04\Sanitary Sewer Profile.dwg; Saved By: ibornett; Save Time: 1/26/2016 11:53:31 AM

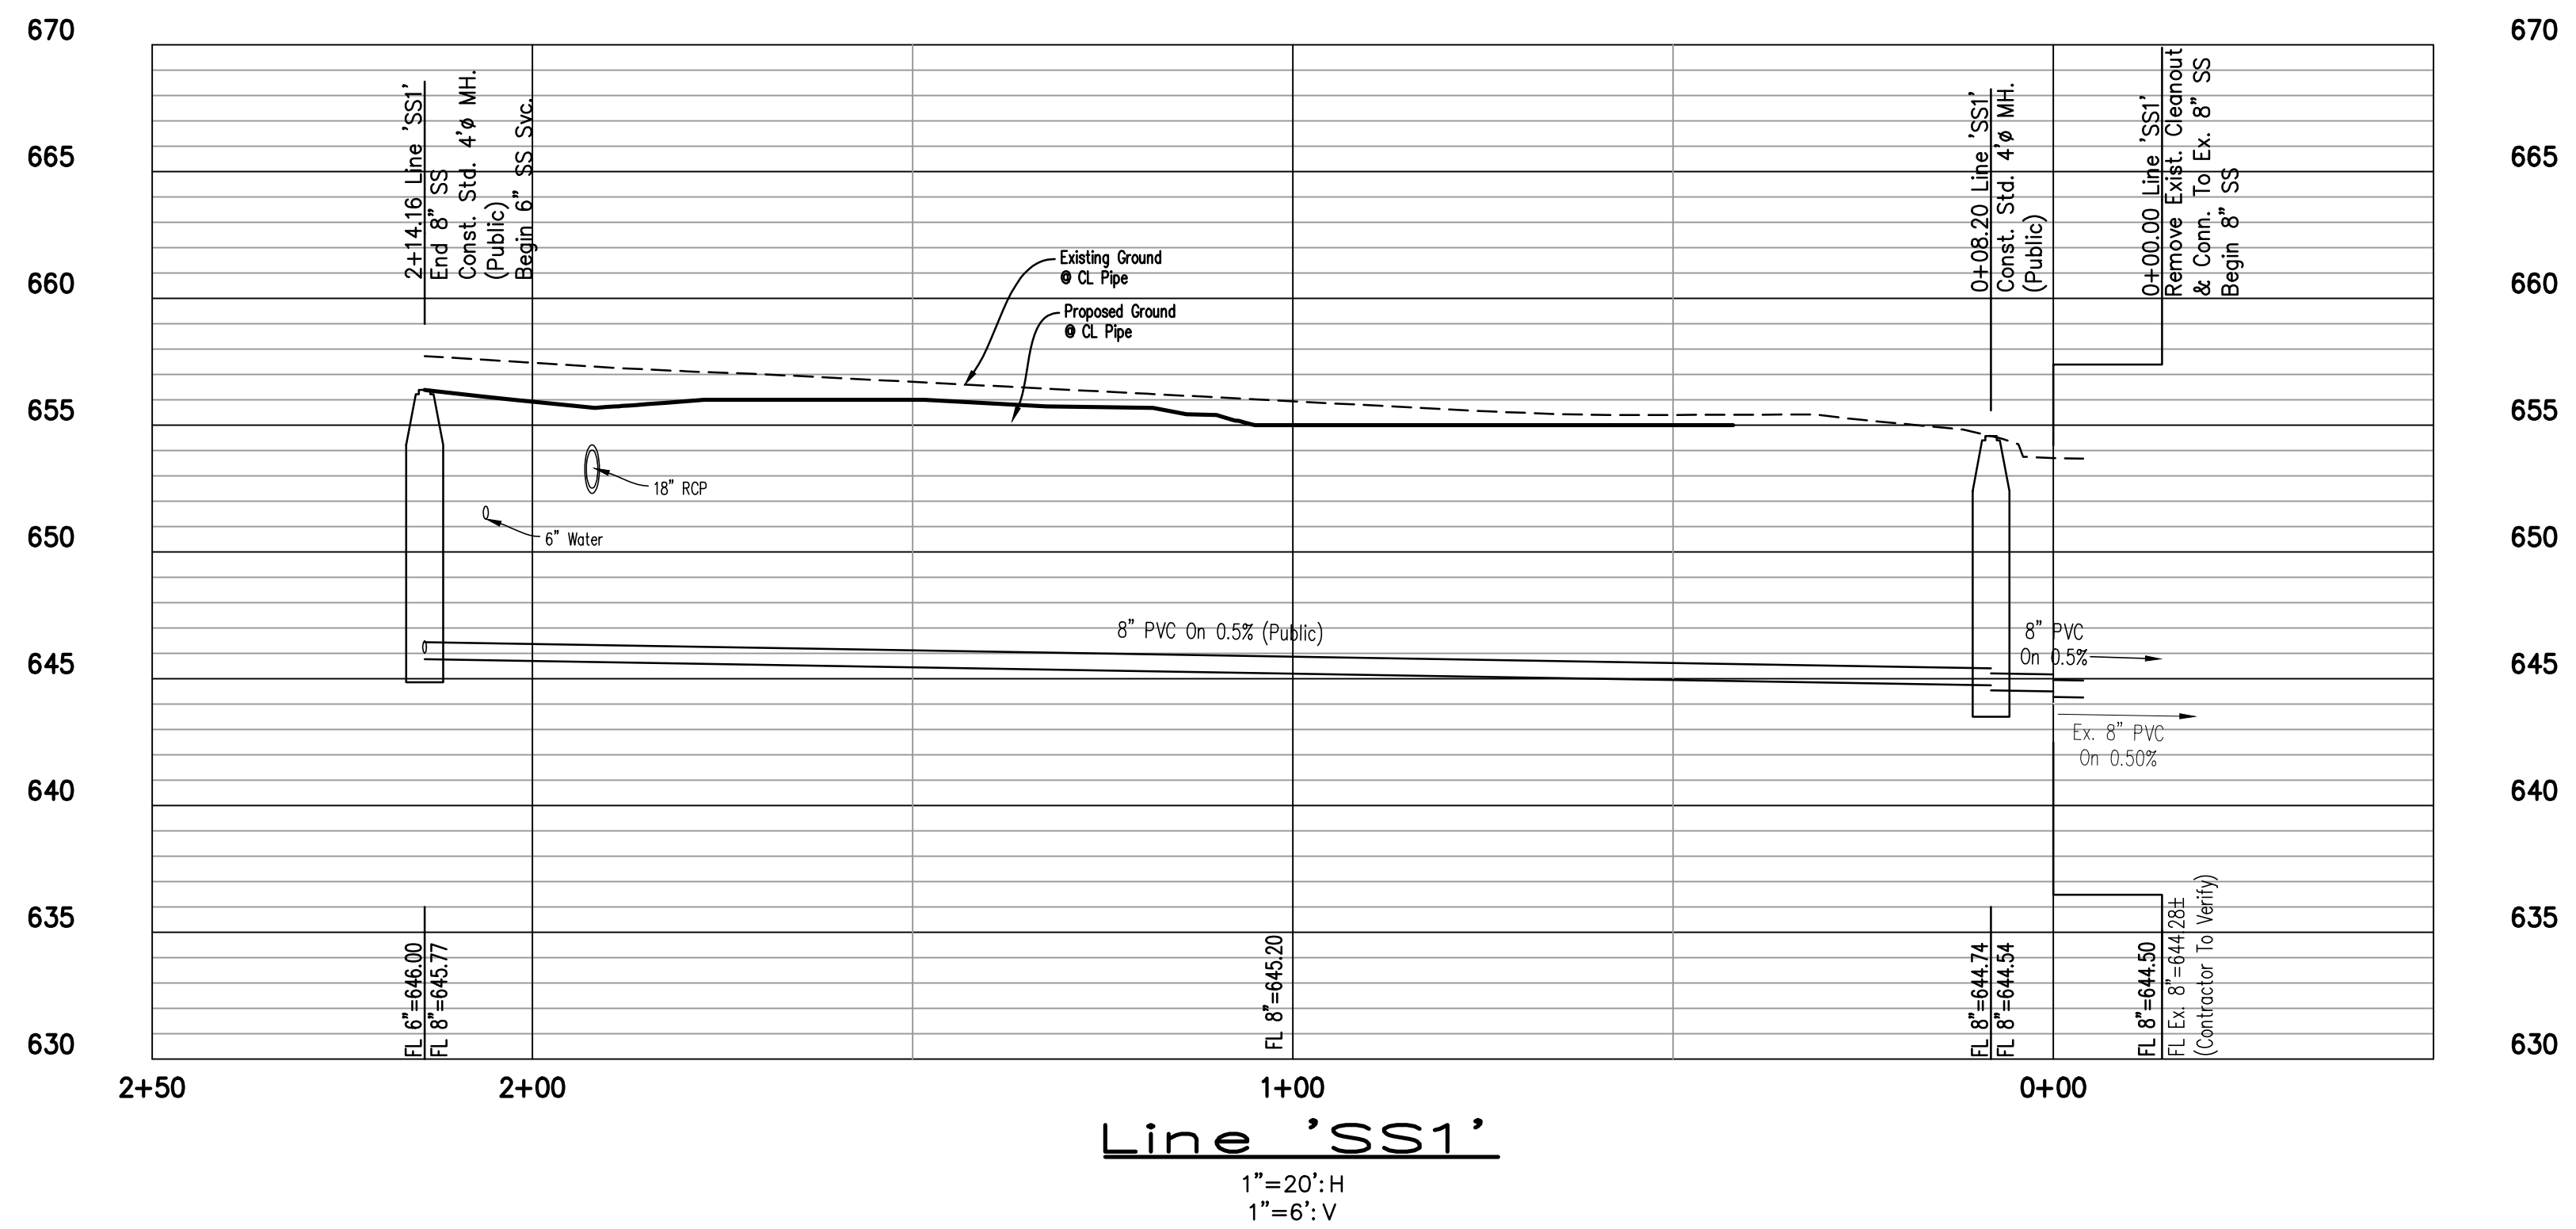

**RECORD DRAWINGS**

NOTE:  
THESE PLANS HAVE BEEN REVISED TO CONFORM WITH  
CONSTRUCTION RECORDS PROVIDED BY THE CONTRACTOR.

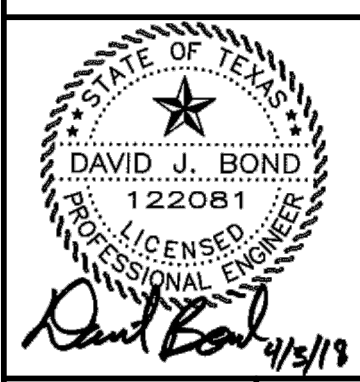

**KNIGHT RENOVATIONS**  
LOT 2R, BLOCK A  
TOWN OF ADDISON  
DALLAS COUNTY, TEXAS  
SANITARY SEWER PROFILE

Issue Dates:  
September 16, 2016

Revisions	Date

Scale: As Shown  
Drawn By: BLM  
Checked By: JWS

Sheet **C 7**  
of **10**

SEI No. 16-036