


- NOTES:
- CONTRACTOR SHALL FIELD VERIFY HORIZ. AND VERT. LOCATION OF EXISTING UTILITY LINE.
 - NOTIFY ENGINEER TO ALLOW FOR ANY ADJUSTMENTS TO PROPOSED DESIGN, BASED ON FIELD VERIFICATION.
 - DO NOT CONSTRUCT ADJUSTMENT UNTIL APPROVAL IS GIVEN BY ENGINEER.
 - VERTICAL PI'S SHALL BE CONSTRUCTED USING STANDARD BENDS AND OR BY PROVIDING JOINT DEFLECTIONS NOT TO EXCEED 75% OF PIPE MANUFACTURER'S MAXIMUM RECOMMENDATIONS.

1 TYPICAL VERTICAL WATERLINE ADJUSTMENT
NOT TO SCALE

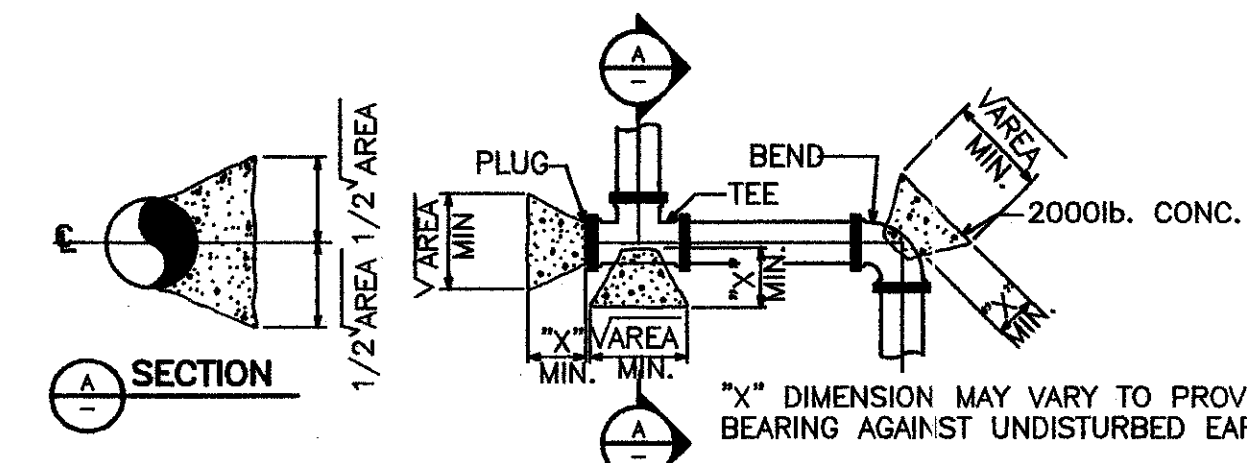

HORIZONTAL BLOCKING TABLE


PIPE SIZE (IN)	DEPTH OF COVER TO CL PIPE (FT)	TEST PRESSURE (LBS)	DEAD END AND TEE	90 BEND	45 BEND	22.5 BEND	11.25 BEND	5 DEFLECT.	*X\"-DIM. FT.
8	3.8	150	7.87	11.13	6.02	3.07	1.54	0.69	1.00
			7,540	10,663	5,771	2,942	1,478	658	
12	4.0	150	16.96	23.99	12.98	6.62	3.33	1.48	1.25
			16,965	23,992	12,984	6,619	3,326	1,480	
16	4.2	150	28.95	40.95	22.16	11.30	5.68	2.53	1.50
			30,159	42,652	23,083	11,768	5,912	2,631	

- NOTES:
- THRUST BLOCK AREAS SHOWN ARE BASED ON TEST PRESSURES OF 150 P.S.I. AND 250 P.S.F. PER VERTICAL FOOT OF SOIL COVER MEASURED TO CENTERLINE OF PIPE.
 - MINIMUM AREAS SHOWN ARE IN SQUARE FEET AND ARE BASED UPON MIN 3.5 FEET OF COVER TO TOP OF
 - BEARING MUST BE ON UNDISTURBED EARTH.
 - ADJUST THRUST BLOCK AREAS ACCORDINGLY IF PRESSURES, DEPTH OF COVER AND/OR SOIL BEARING VALUE VARIES.


2 TYPICAL BLOCKING DETAIL
NOT TO SCALE

BENDS	90°	45°	22 1/2°	11 1/4°
* VOL. REQ'D. C.F.	28.27	22.61	11.33	5.65
6 A FT.	1.75	1.5	1.0	0.75
B FT.	4.0	3.88	3.36	2.75
C FT.	4.0	3.88	3.36	2.75
* VOL. REQ'D. C.F.	50.27	40.21	20.11	10.05
8 A FT.	2.0	1.75	1.5	1.0
B FT.	5.0	4.8	3.66	3.2
C FT.	5.0	4.8	3.66	3.2
* VOL. REQ'D. C.F.	78.54	62.83	31.41	15.71
10 A FT.	2.25	2.0	1.75	1.5
B FT.	5.9	5.6	4.25	3.25
C FT.	5.9	5.6	4.25	3.25
* VOL. REQ'D. C.F.	153.94	123.15	61.57	30.79
12 A FT.	4.0	3.5	2.0	1.75
B FT.	6.2	6.0	5.54	4.2
C FT.	6.2	6.0	5.54	4.2


* VOLUME CALCULATED ON THE BASIS OF CONCRETE REACTING THRUST ON THE RESPECTIVE BENDS UNDER AN INTERNAL PRESSURE OF 150 PSIG AT THE RATE OF 150 LB. WT. PER CU.FT. OF CONCRETE.

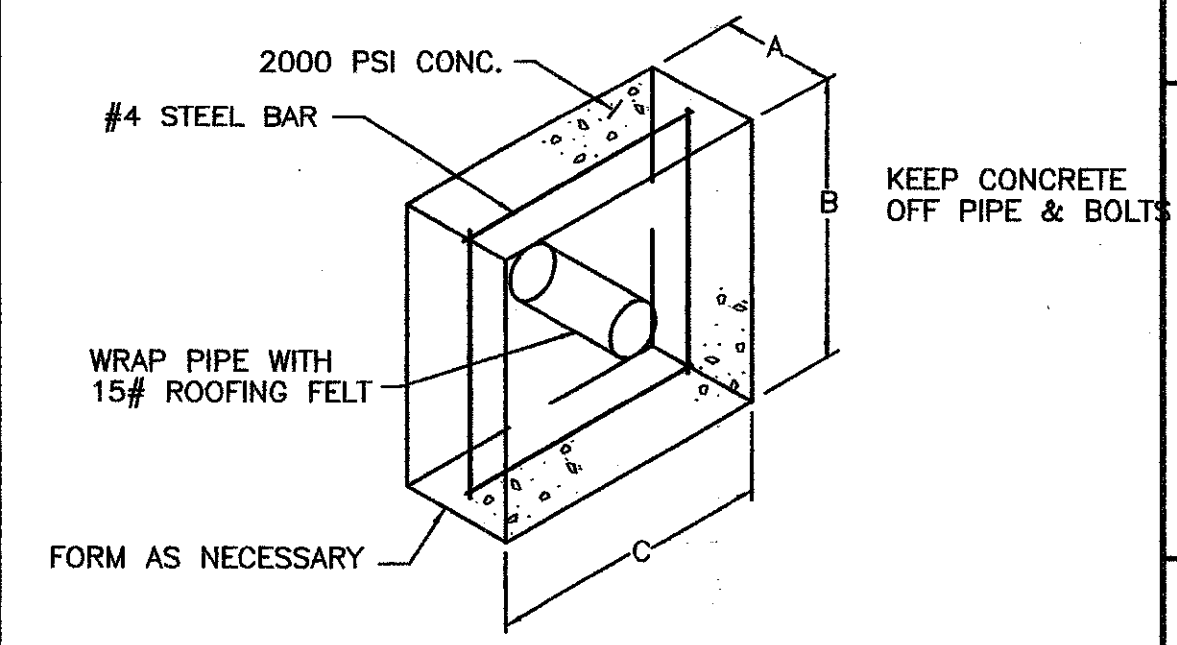


3 VERTICAL TIE-DOWN BLOCK DETAIL
NOT TO SCALE

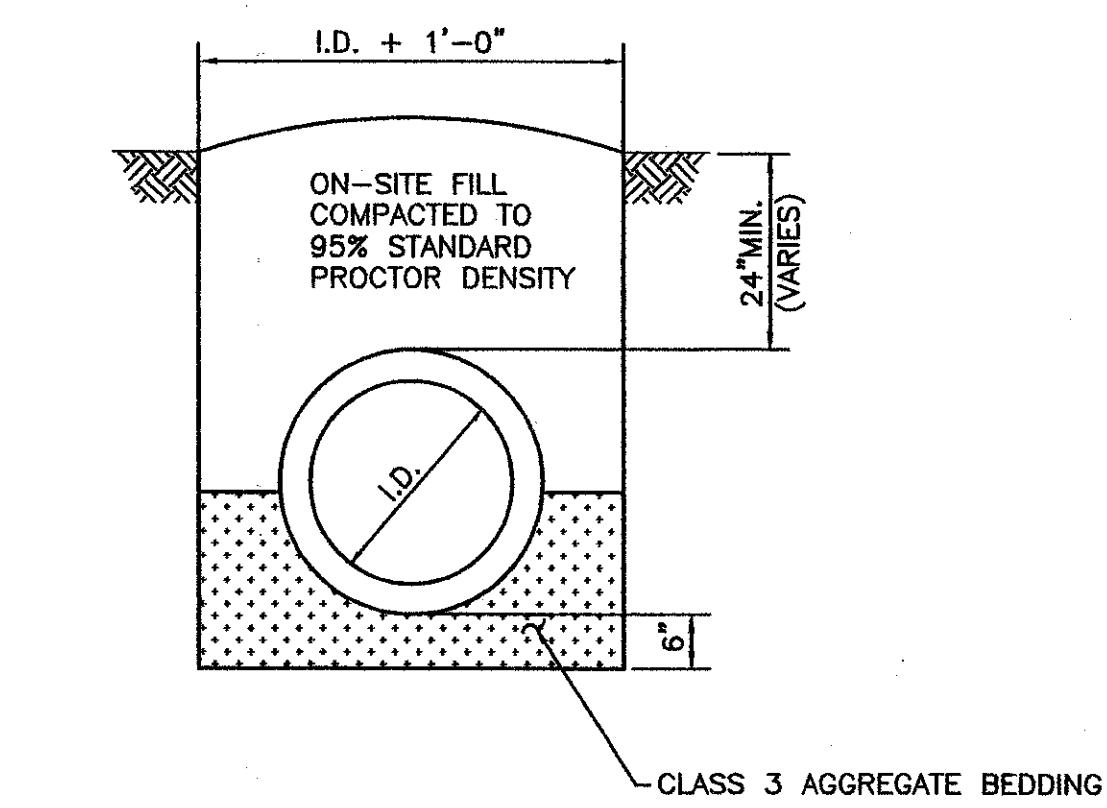


4 STORM DRAIN TRENCH
NOT TO SCALE

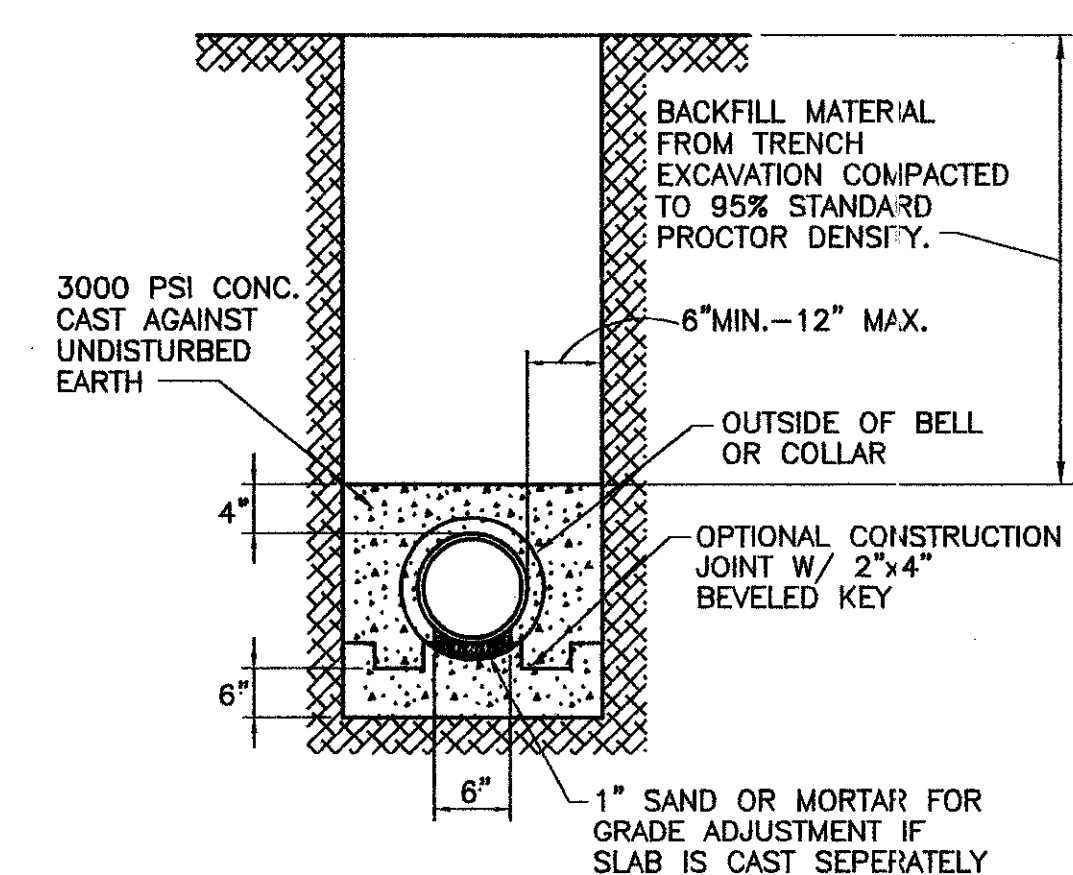


5 TYPICAL CONCRETE ENCASEMENT FOR PIPE
NOT TO SCALE

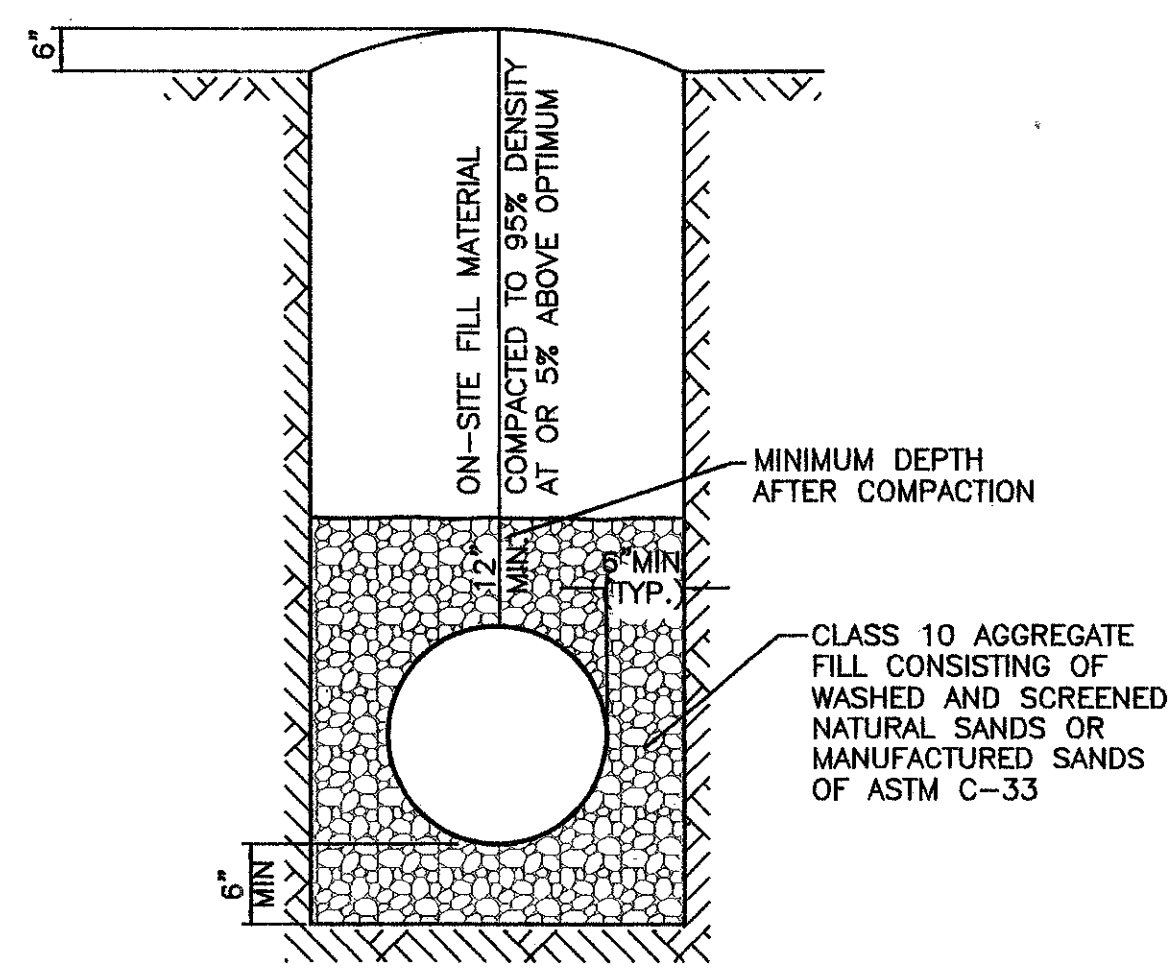

6 TYPICAL PVC LINE TRENCH DETAIL
NOT TO SCALE

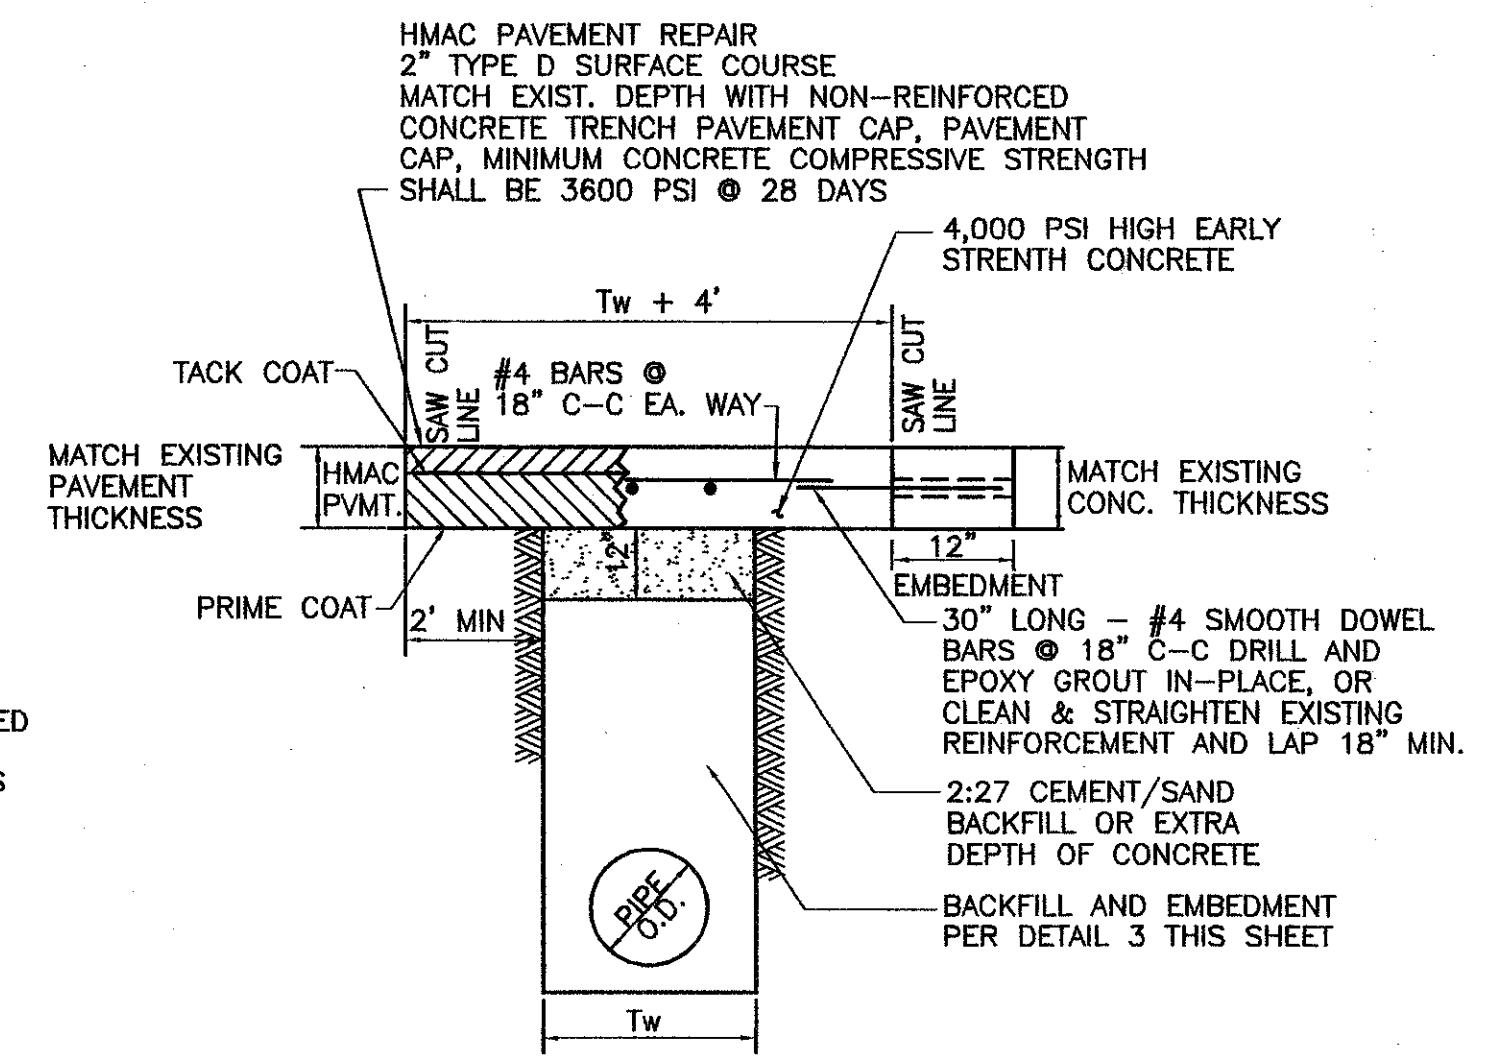


7 TYPICAL PAVEMENT REPAIR TRENCH DETAIL
NOT TO SCALE

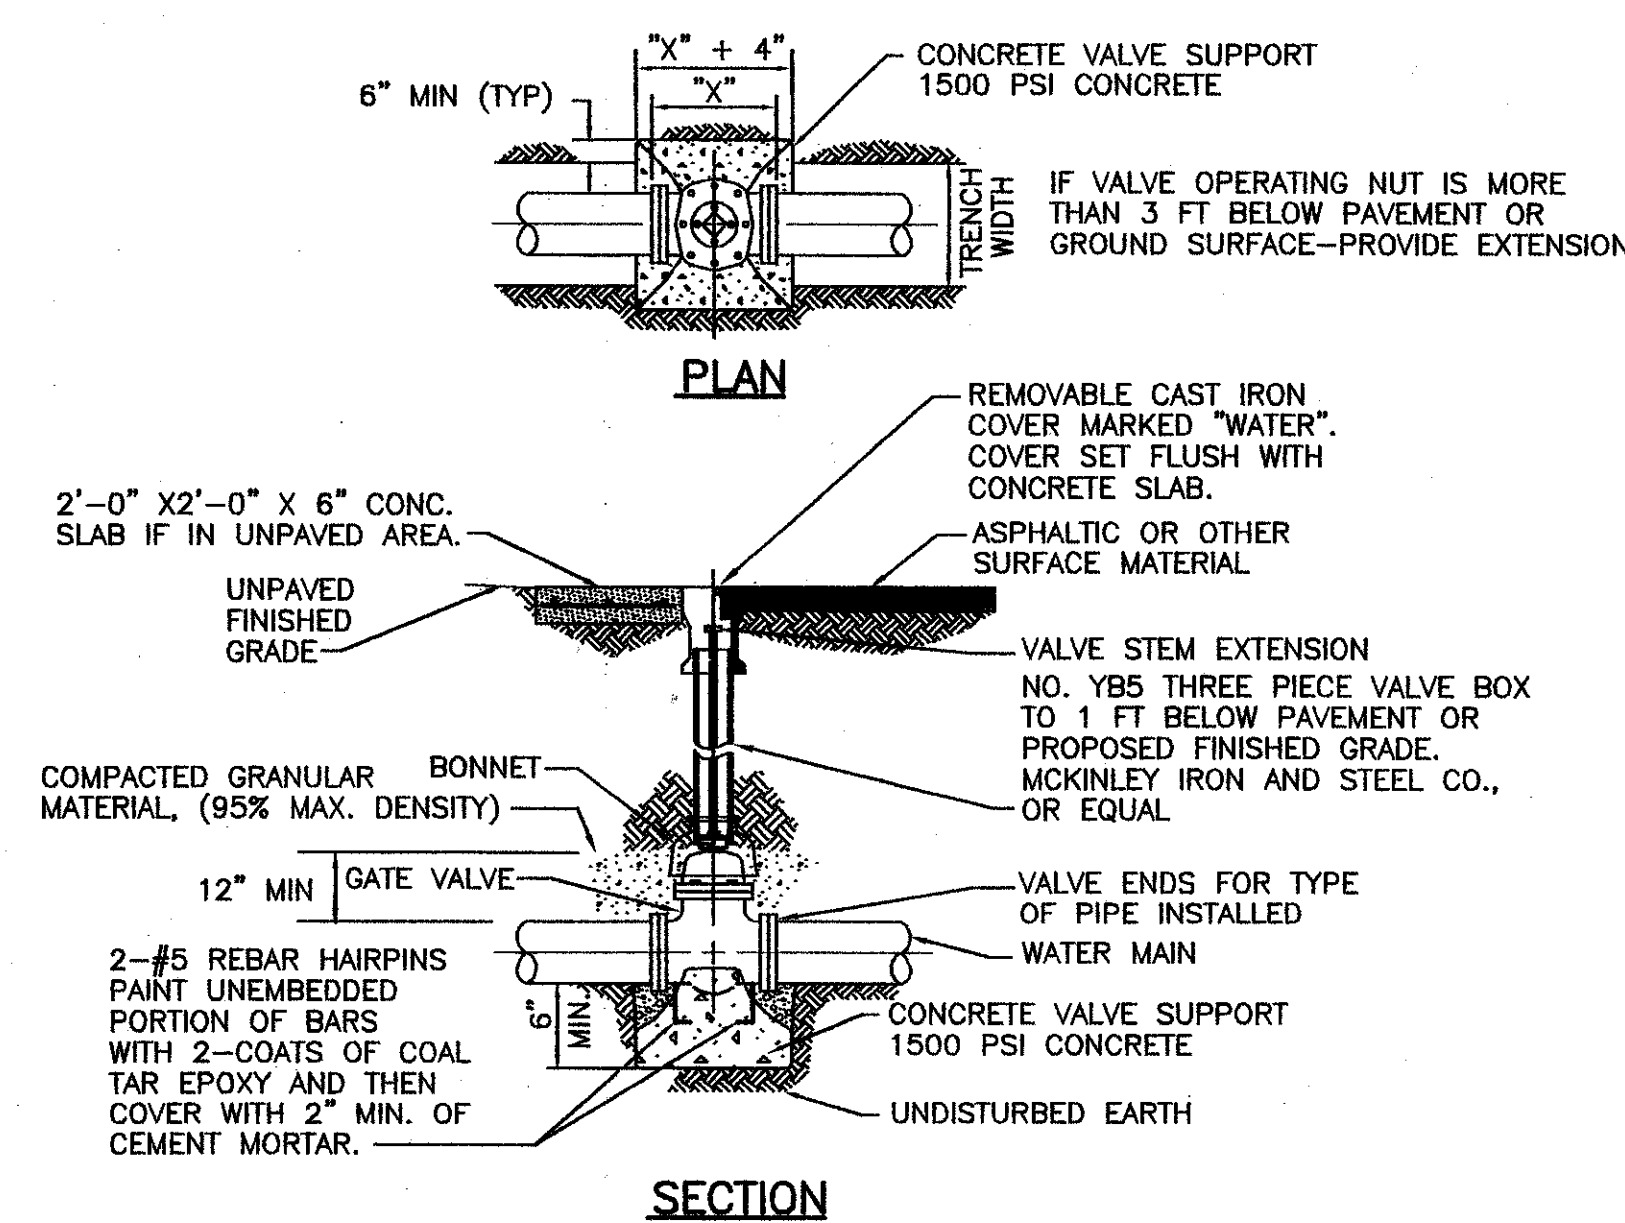


- NOTES:
- ALL BURIED VALVES SHALL BE PROVIDED W/EXTENSION STEM OPERATOR W/ 2\"/>
 - COAT BURIED PIPE & VALVE BOX PER SPECIFICATIONS. WRAP WITH 8 MIL POLYETHYLENE.
 - CLEAN VALVE BOX OF ALL DEBRIS AND SOIL.
 - VALVE SIZE & TYPE AS SHOWN ON PLANS.

8 TYP. VALVE, VALVE BOX, AND EXTENSION INSTALLATION DETAIL
NOT TO SCALE

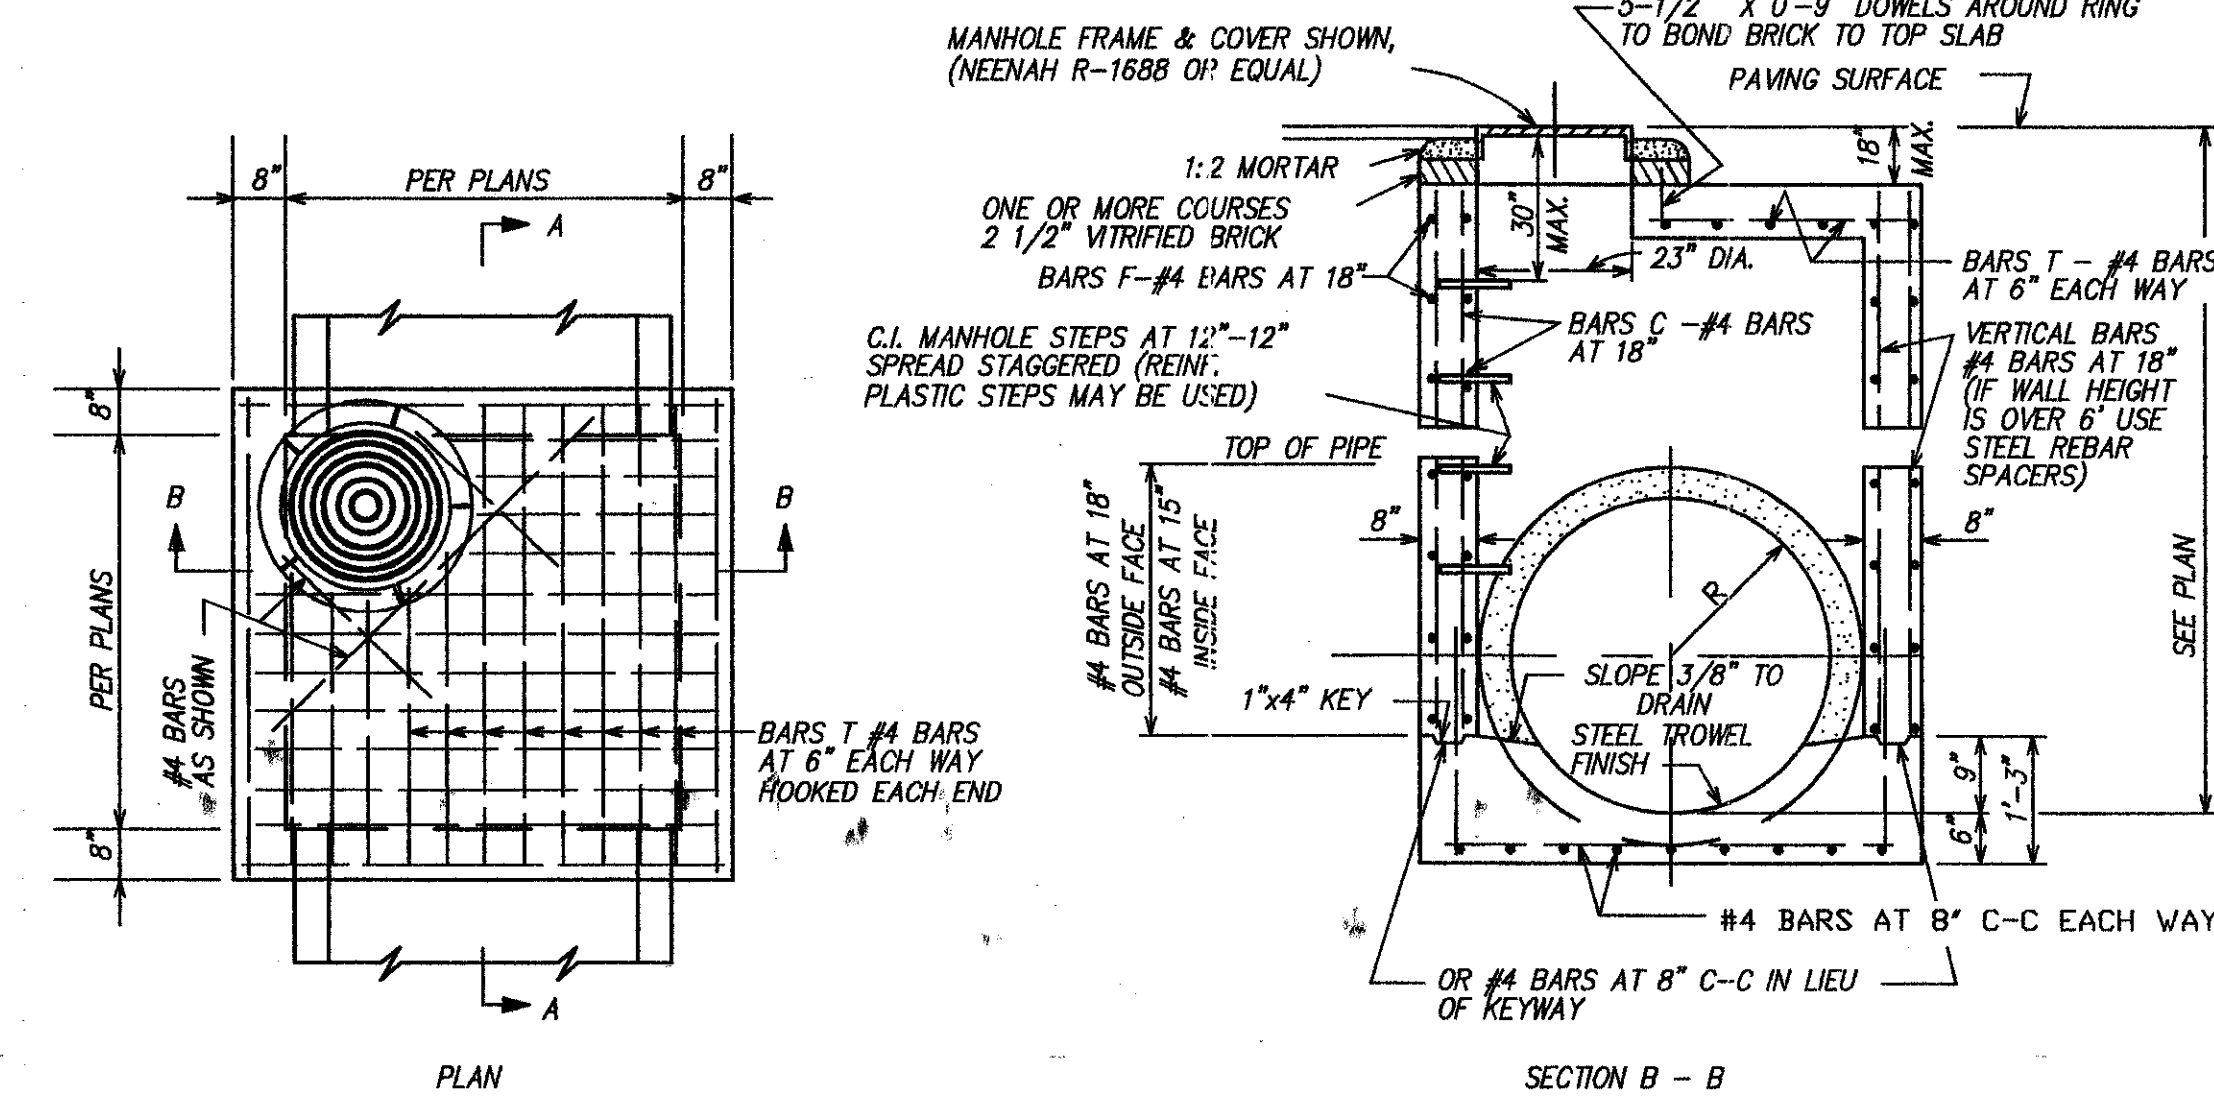

9 STORM DRAIN MANHOLE
NOT TO SCALE

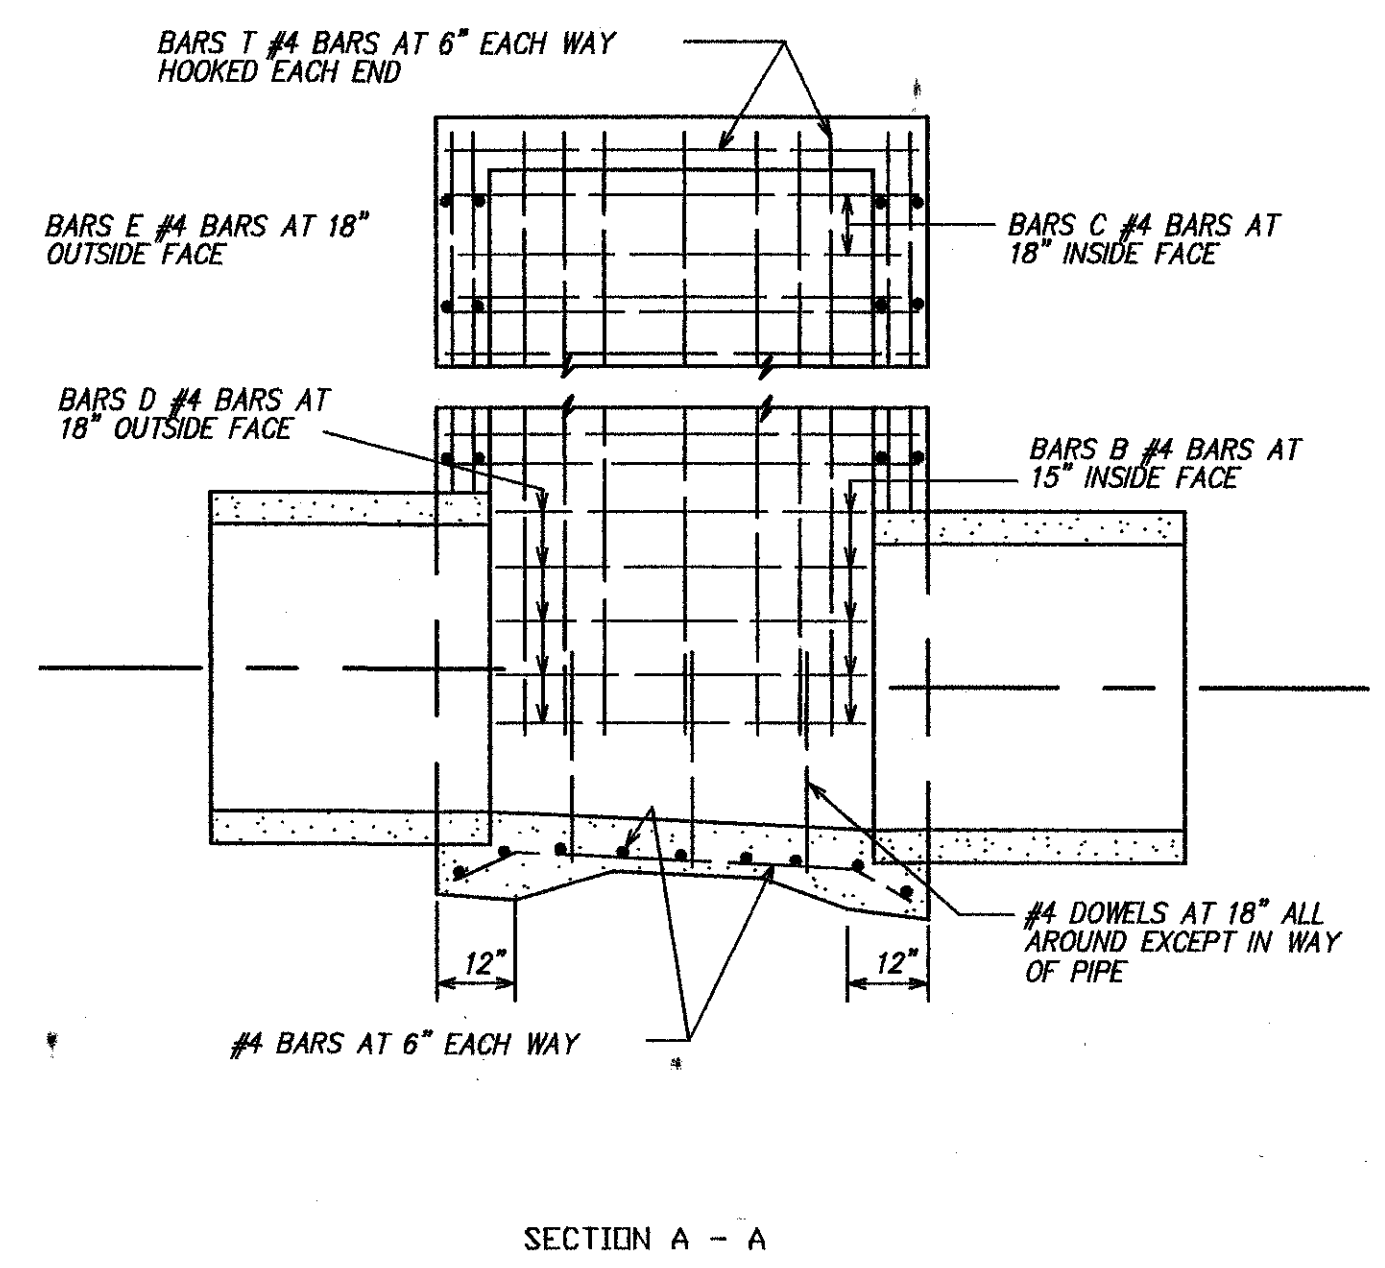

TYPICAL CORNER DETAIL
PLAN VIEW

RECORD DRAWING
BASED ON THE INFORMATION SUPPLIED BY THE CONTRACTOR
DATE: 3-3-00
NO. THH

THE SEAL, APPROVED BY THIS BOARD, IS VALID ONLY IF THE SEAL IS SIGNED, SEALED AND DATED BY THE ENGINEER.
ENGINEER: TRICIA H. HATLEY
TEXAS REGISTRATION NO. 83282
DATE: OCT. 6, 1999

FREESE-NICHOLS
341 W. MacArthur Blvd., Suite 230-E
Dallas, TX 75244
214-920-9200

OMNIPLAN ARCHITECTS
SOJOURN OFFICE CENTER
ADDISON, TEXAS
SITEWORK PLANS
UTILITY DETAILS

NO.	REVISION	DATE	BY	DATE	FILE	DESIGNED	DRAWN	REVIEWED	CHECKED	THH
1	PER CONTRACTOR REF 1\"/>	4/30/99	MDW	7-26-99	206DET-UTIL	MDW	MDW	MDW	MDW	THH

Bar is one inch on original drawing. If not one inch on this sheet, adjust scale.

VERIFY SCALE

SHEET C-11

SEQ. 14 OF 16

"AS-BUILTS"