



NOTES:


1. MAXIMUM SLOPE ON BARRIER FREE RAMPS MUST NOT EXCEED 1" PER 1' IN ANY DIRECTION.
2. GROOVES MUST BE CLEAN AND STRAIGHT FOR CLEAR DETECTION BY TOUCH WITH A CANE AND PARALLEL TO CROSSWALKS.
3. RAMP 6' LONG W/1:12 SLOPE AND GROOVES 1/8" x 1/4" @ 2" C-C

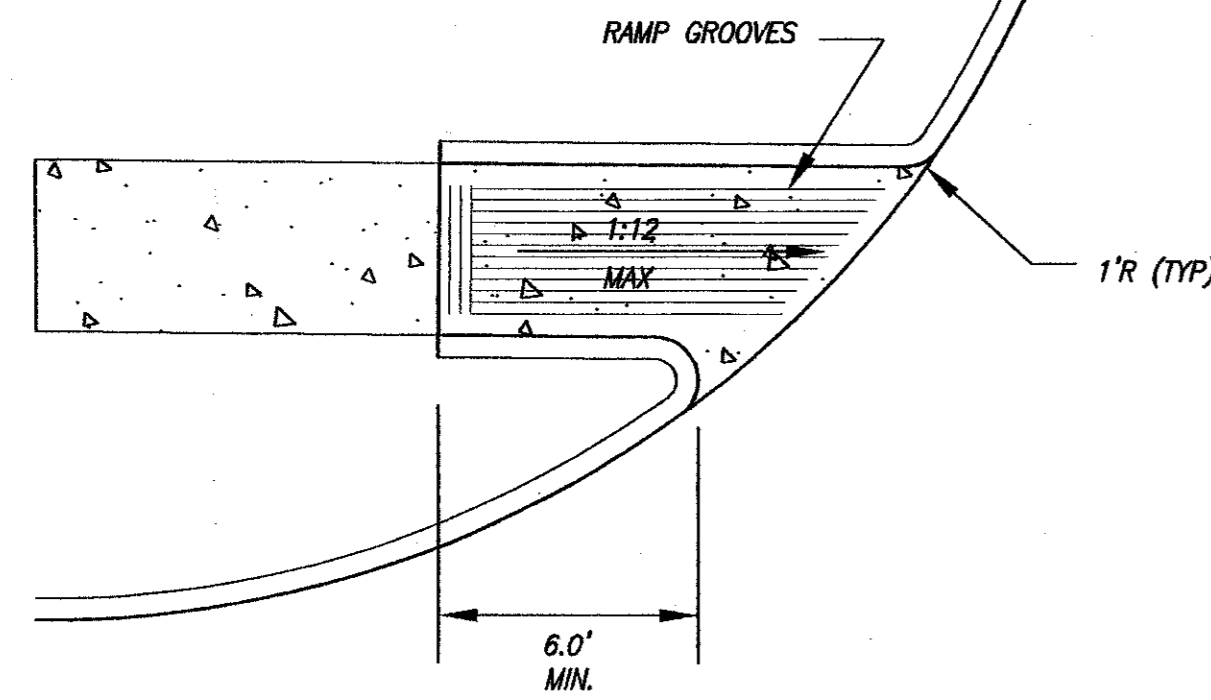


CURB RAMP DETAIL
NOT TO SCALE

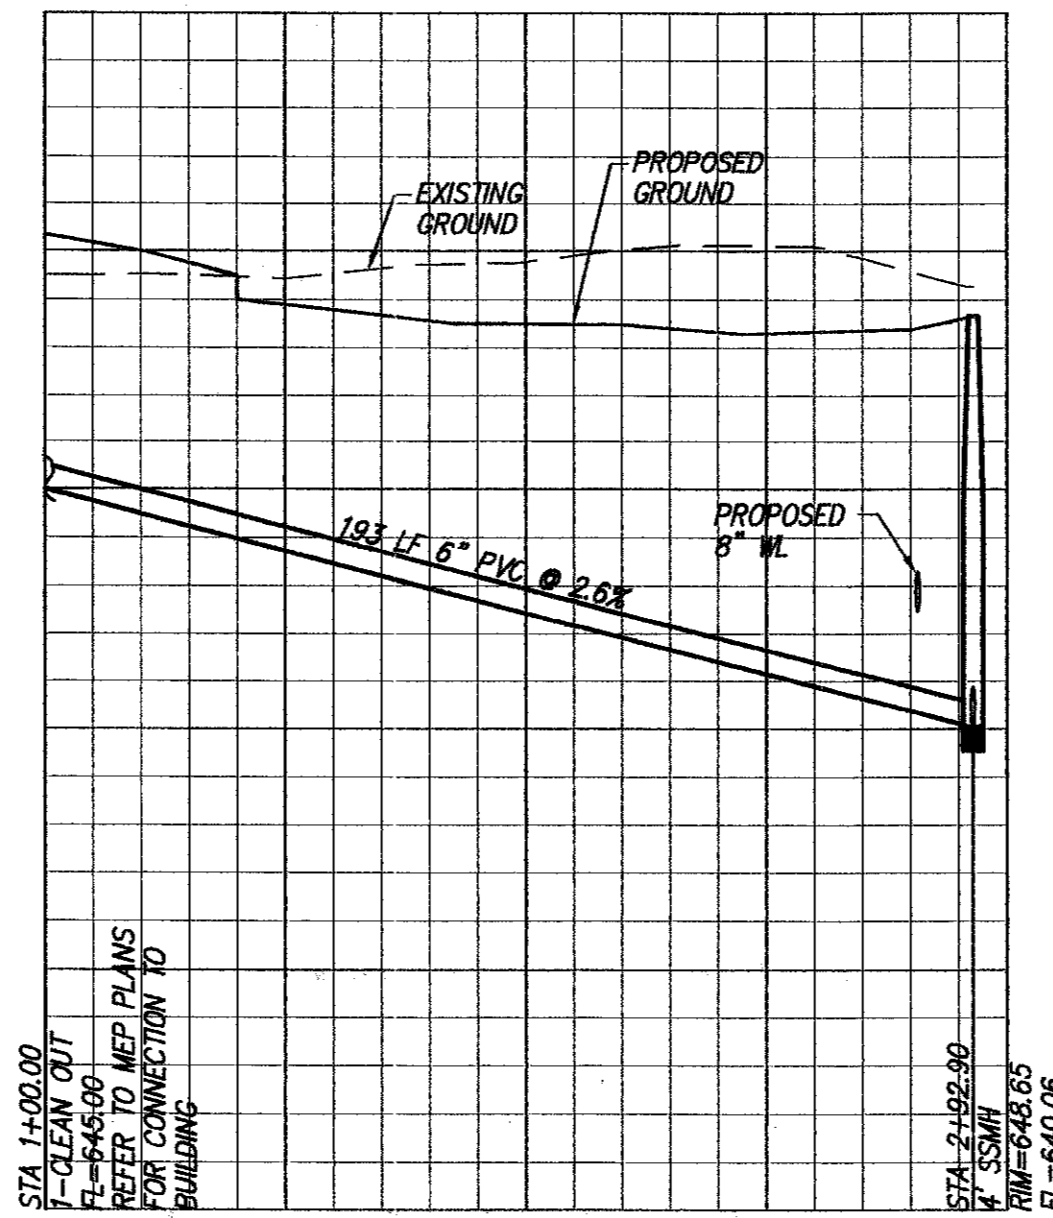

SANITARY SEWER PROFILE - LINE A
SCALE: 1"=40' HORIZ.
1"=4' VERT.

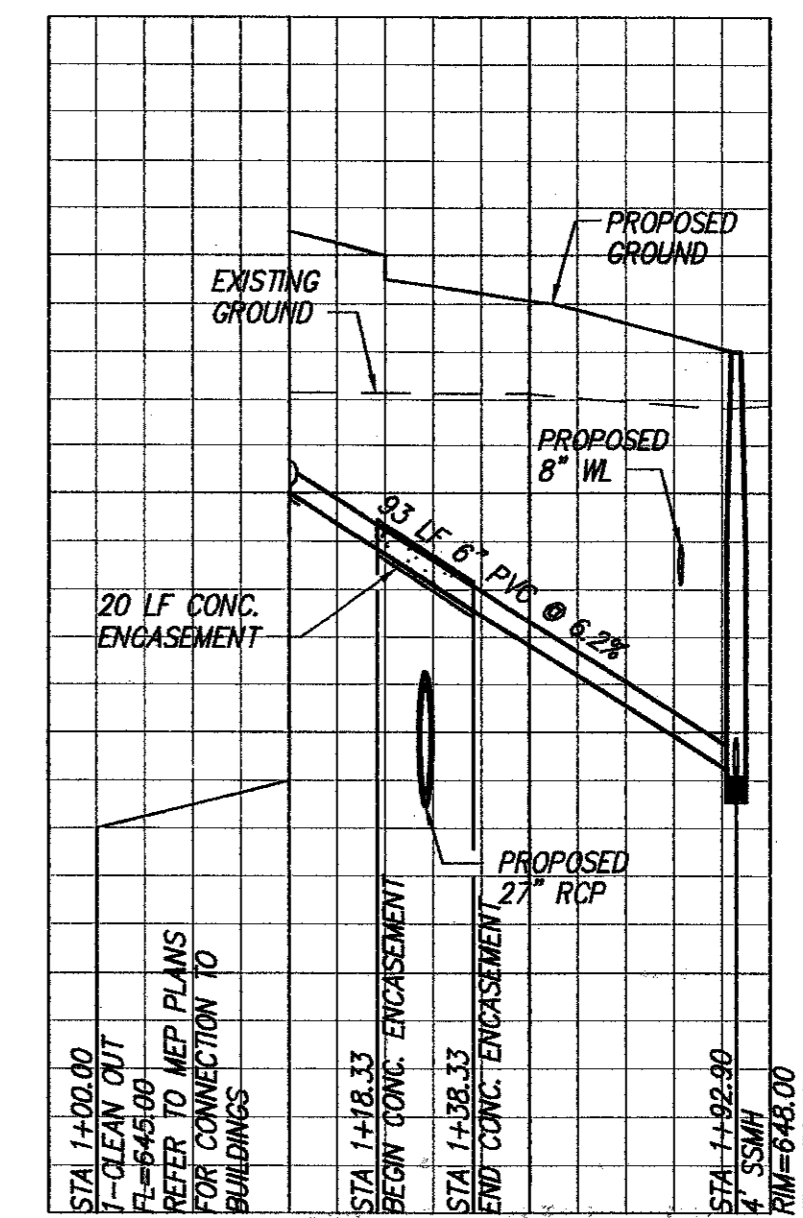


SANITARY SEWER PROFILE - LINE B
SCALE: 1"=40' HORIZ.
1"=4' VERT.

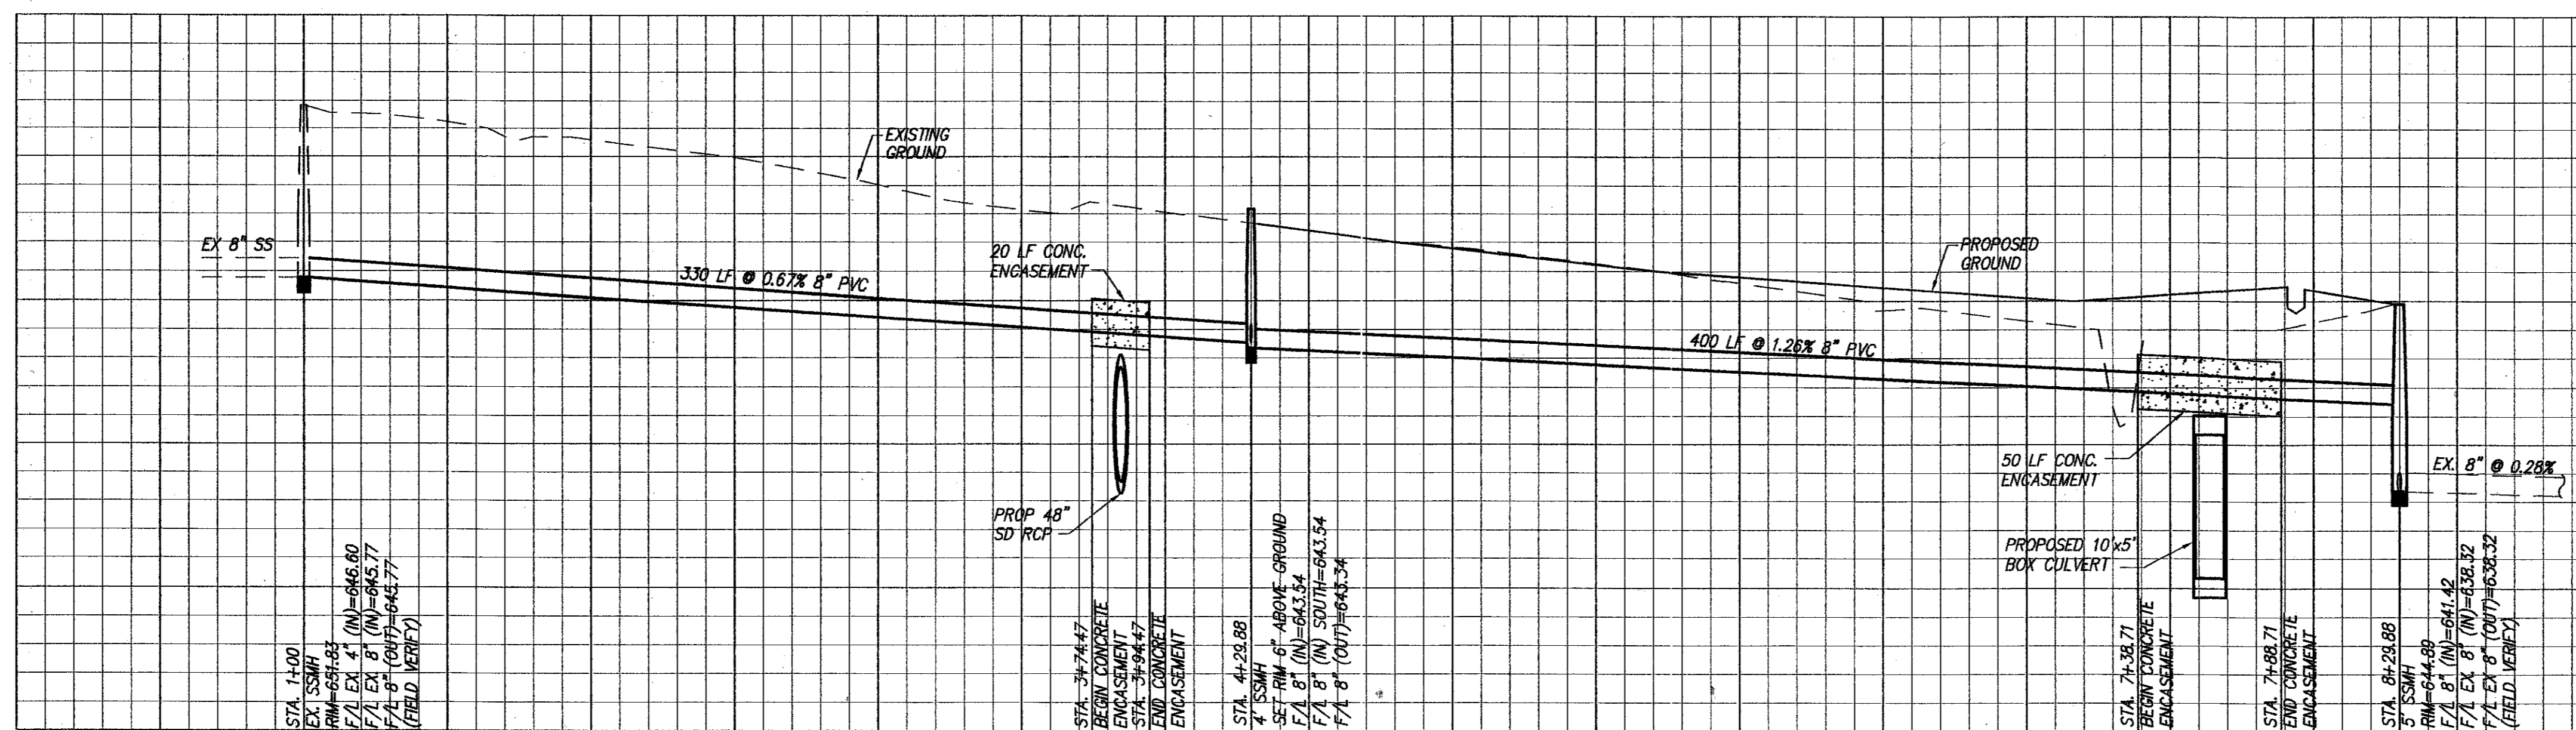

SANITARY SEWER PROFILE - LINE C
SCALE: 1"=40' HORIZ.
1"=4' VERT.

RECORD DRAWING
BASED ON THE INFORMATION
SUPPLIED BY THE CONTRACTOR
DATE: 5-3-00 T.D. THH

THIS SEAL APPLICABLE TO THE CONTRACT
THIS SEAL SHALL BE VALID AND DATED BY
ENGINEER: TRICIA H. HATLEY
TEXAS REGISTRATION NO: 83282
DATE: OCT. 6, 1989

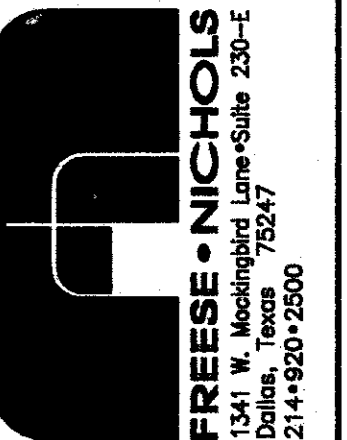

OMNIPLAN ARCHITECTS
SOJOURN OFFICE CENTER
ADDISON, TEXAS

SITEWORK PLANS
MISCELLANEOUS DETAILS & SEWER PROFILES

NO. / REVISION	BY	DATE	PLAN JOB NO.
1 / PER CONTRACTOR SET 1" AND 2"	MDW	4/20/99	OMP99206
2 / REVISED PER RAISING FF 1 FOOT	MDW	5/3/99	FILE 206DET-MISC
3 / REVISED PER CITY COMMENTS	GG	7/28/99	DATE 7-26-99
VERIFY SCALE	DESIGNED	MDW	DRAWN
0	REVISOR	GAH	CHECKED
	THH		

SHEET **C-13**

"AS-BUILTS"