


**DETENTION BASIN SIZING FOR SOJOURN PLAZA
FOR THE CITY OF CARROLLTON**

PROJECT: Addison - Sojourn Plaza
 PARAMETER: Pond Allowable Outflow = 328.92 cfs
 Pond Actual Outflow = 305.00 cfs
 DATE: 04/29/99

MODIFIED RATIONAL METHOD FOR SIZING DETENTION BASINS


EXISTING CONDITIONS	Q ₁₀₀ OFFSITE (NON-DETAINED FLOW)	Q ₁₀₀ SITE (DETAINED FLOW)	Q ₁₀₀ TOTAL OFFSITE AND ONSITE
Area*	38.60 Acres	13.86 Acres	52.46 Acres
Cumulative C/P CA	34.82	9.53	44.35
Time of Concentration*	15.50 Min	15.50 Min	15.50 Min
Rainfall Intensity	7.45 in/hr	7.45 in/hr	7.45 in/hr
Allowable Flow (Cfd)			328.92 cfs

DEVELOPED CONDITIONS	Q ₁₀₀ OFFSITE (NON-DETAINED FLOW)	Q ₁₀₀ SITE (DETAINED FLOW)	Q ₁₀₀ TOTAL OFFSITE AND ONSITE
Area*	38.60 Acres	13.86 Acres	52.46 Acres
Cumulative CA	34.82	13.86	48.68
Time of Concentration (Tcd)*	15.50 Min	15.50 Min	15.50 Min
Rainfall Intensity	7.45 in/hr	7.45 in/hr	7.45 in/hr
Developed Flows			301.18 cfs

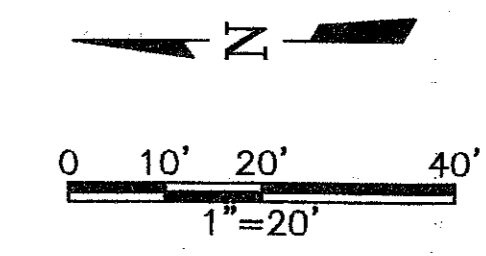

BENCHMARK:
 SQUARE CUT ON INLET AT S.W. CORNER OF SOJOURN DR. AND ADDISON RD. ELEV. 641.95

LEGEND

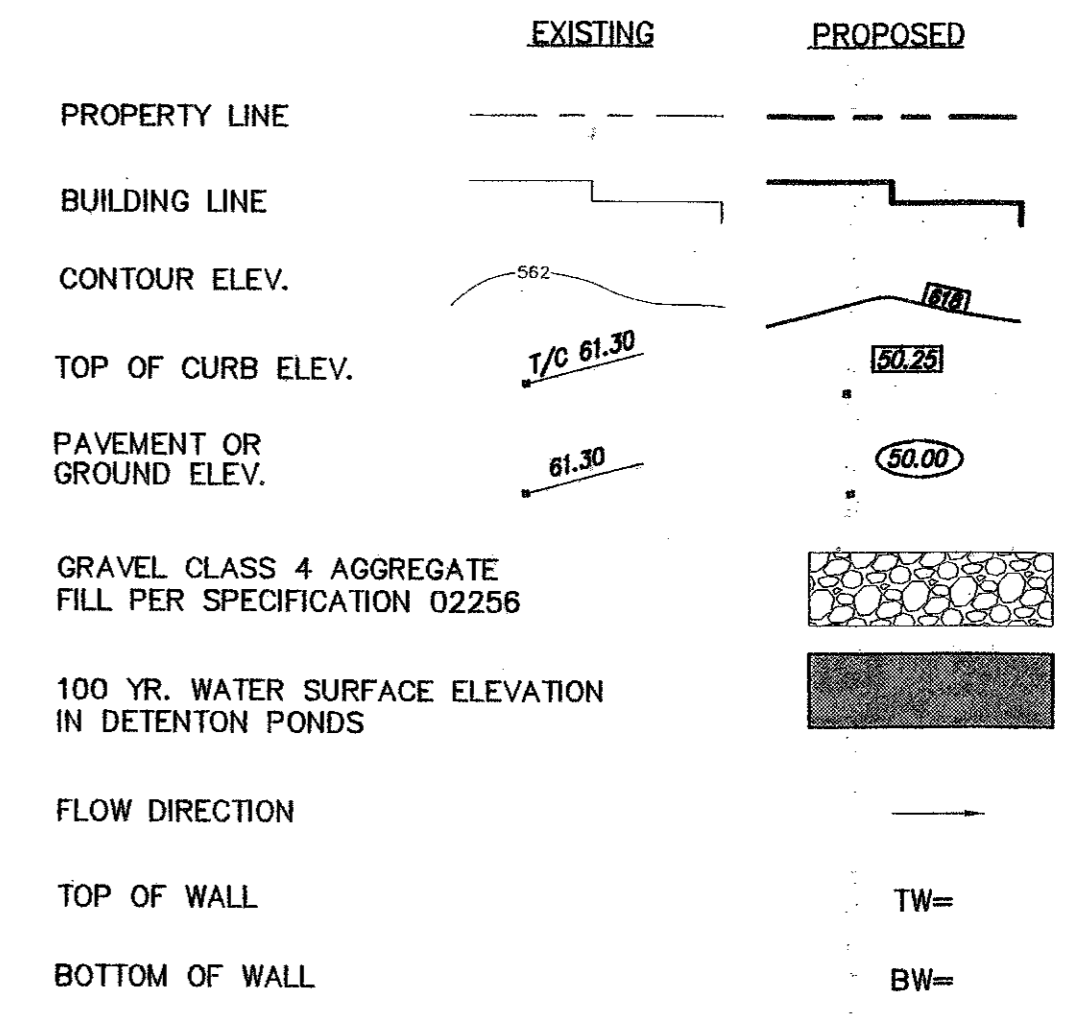

NOTES

- BOTTOM OF POND SHALL SLOPE TO DRAIN AS NOTED ON PLANS.
- DETENTION POND DESIGN IS BASED ON THE CITY CARROLLTON DRAINAGE DESIGN STANDARDS.

Detention Pond Capacities

Stage	Area (sq)	Volume (cf)	Cumulative Vol. (cf)	Storage acre-ft
634.67	0	0	0	0.01
635	3003	495	495	0.15
636	9410	6207	6,702	0.37
637	9410	10482	26,594	0.61
638	11554	11554	38,148	0.88
639	11554	11554	49,702	1.14
640	11554	12725	62,427	1.43
641	13897	13897	76,324	1.75
642	13897	8338	84,663	1.94
642.6	13897			

BOX CULVERT ANALYSIS
 COMPUTATION OF CULVERT PERFORMANCE CURVE

April 30, 1999
 SOJOURN PLAZA OFFICE CENTER - OMP99206
 DETENTION POND
 RELEASE BOX CULVERT

Q (cfs)	Flow	Storage
5.0	10.50	509.04
10.0	8.82	427.59
15.0	7.52	364.57
20.0	6.80	329.66
25.0	6.29	300.59
30.0	5.74	278.28
35.0	5.20	252.10
40.0	4.80	242.40
45.0	4.40	232.70
50.0	4.10	213.31
55.0	3.90	198.77
60.0	3.80	189.07
65.0	3.65	186.65
70.0	3.65	176.95
75.0	3.45	167.26
80.0	3.30	159.98
85.0	3.20	155.14
90.0	3.10	150.29

A (Min)	B Intensity	C Flow	(A-C*60)	(Qd)(Tcd+A)/2(60)
5.0	10.50	509.04	152,712	187,575
10.0	8.82	427.59	256,556	233,325
15.0	7.52	364.57	328,113	279,075
20.0	6.80	329.66	395,997	324,825
25.0	6.29	300.59	450,864	370,575
30.0	5.74	278.28	500,895	416,325
35.0	5.20	252.10	529,402	462,075
40.0	4.80	242.40	581,760	507,825
45.0	4.40	232.70	628,901	553,575
50.0	4.10	213.31	638,936	599,325
55.0	4.10	198.77	656,934	645,075
60.0	3.90	189.07	680,059	690,825
65.0	3.65	186.65	727,927	736,575
70.0	3.65	176.95	743,198	782,325
75.0	3.45	167.26	752,652	828,075
80.0	3.30	159.98	767,923	873,825
85.0	3.20	155.14	791,194	919,575
90.0	3.10	150.29	811,555	965,325

Volume = 84,570 AC. FT.
 Volume Provided = 84,663 AC. FT.




PROGRAM INPUT DATA:

DESCRIPTION	VALUE
Culvert Span (Width of Opening) (feet)	10.00
Culvert Rise (Height of Opening) (feet)	5.00
FWMA Chart Number (8, 9, 10, 11, 12 or 13)	10
Scale Number on Chart (Type of Culvert Entrance)	1
Manning's Roughness Coefficient (n-value)	0.0120
Entrance Loss Coefficient of Culvert Opening	0.50
Culvert Length (feet)	33.9
Culvert Slope (feet per foot)	0.0050

PROGRAM RESULTS:

Flow Rate (cfs)	Tailwater Depth (ft)	Headwater Depth (ft)	Normal Depth (ft)	Critical Depth (ft)	Outlet Depth (ft)	Outlet Velocity (fps)
305.0	7.19	5.03	7.93	2.48	3.07	5.00


BOX CULVERT ANALYSIS COMPUTER PROGRAM Version 1.6 Copyright (c) 1986 Dodson & Associates, Inc., 7015 W. Tidwell, #107, Houston, TX 77092 (713) 895-8322. All Rights Reserved.

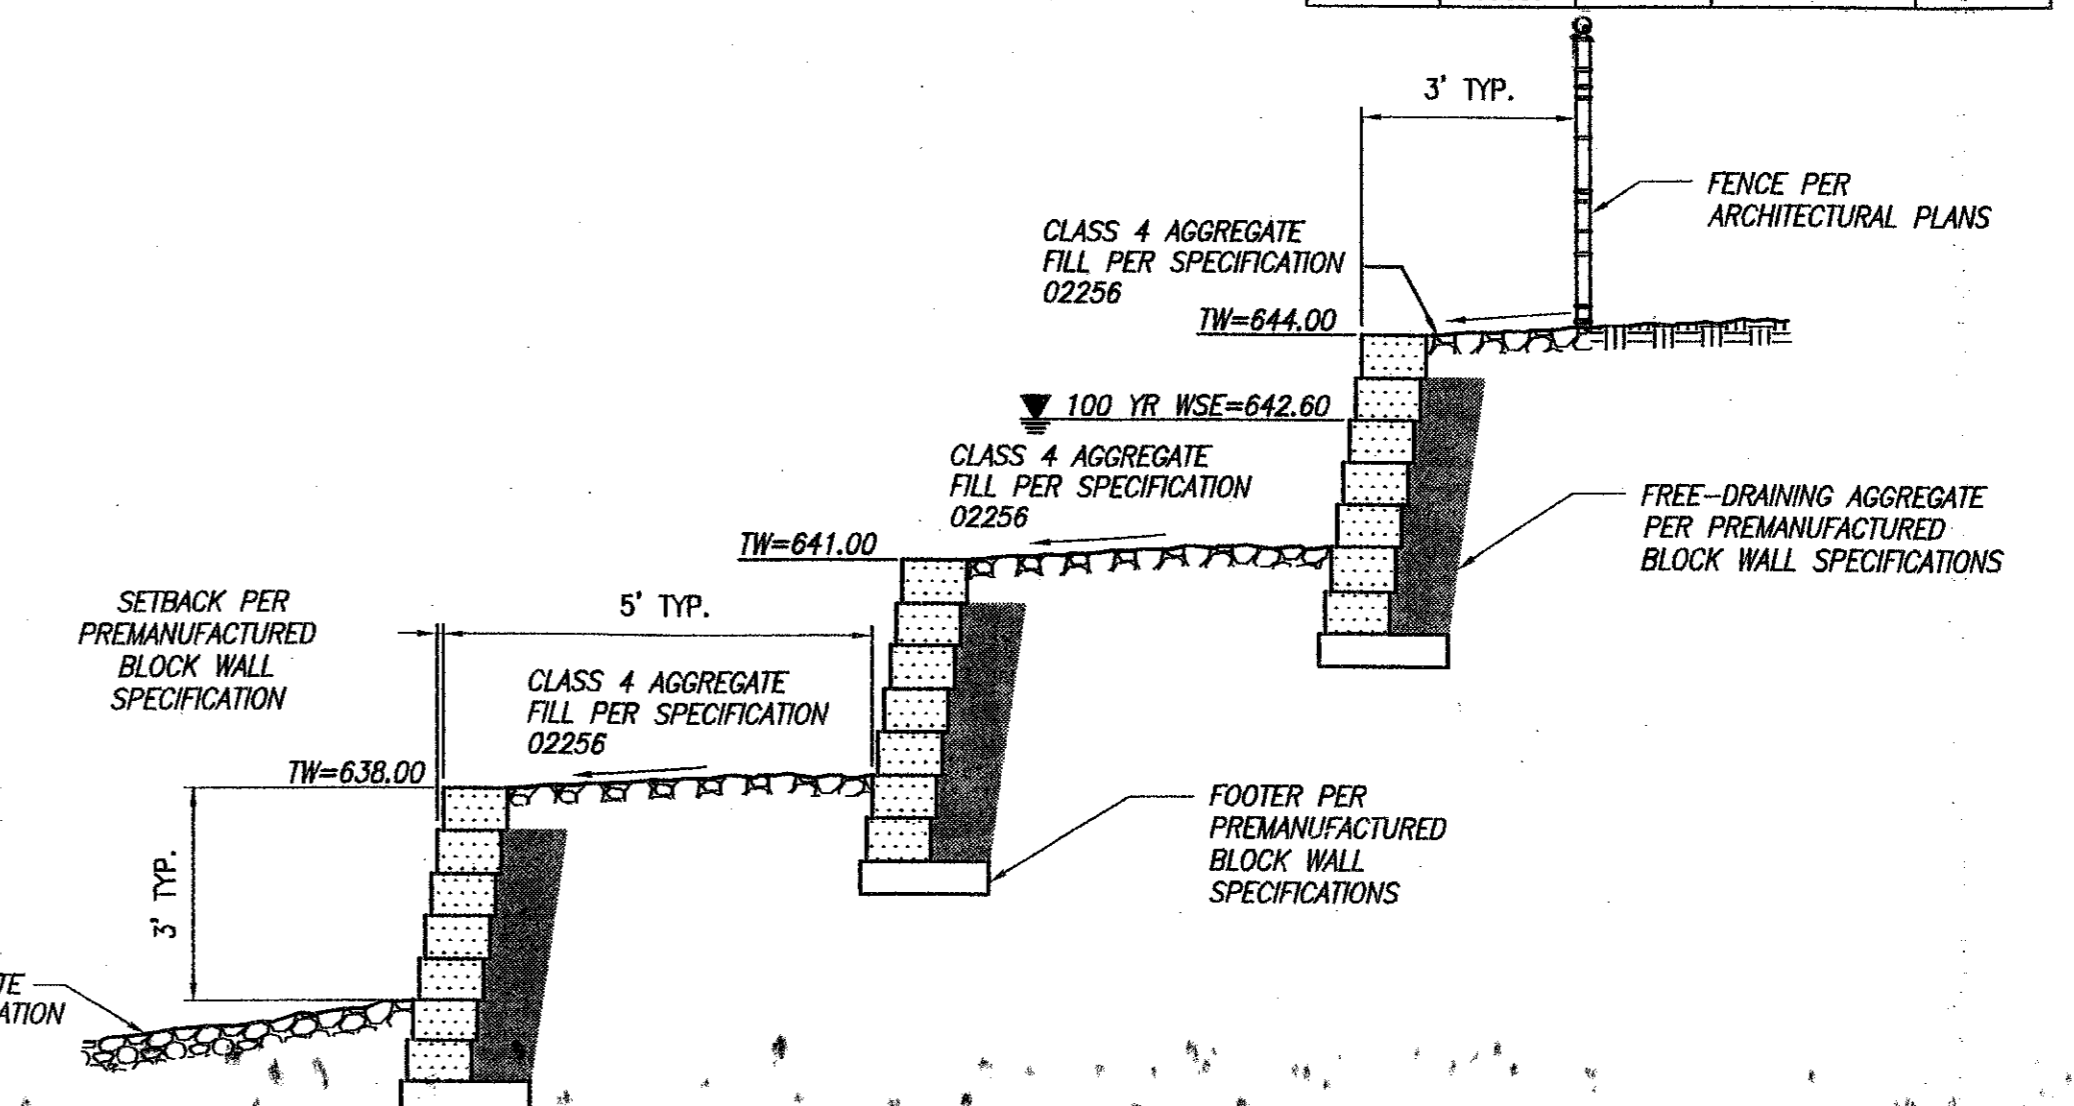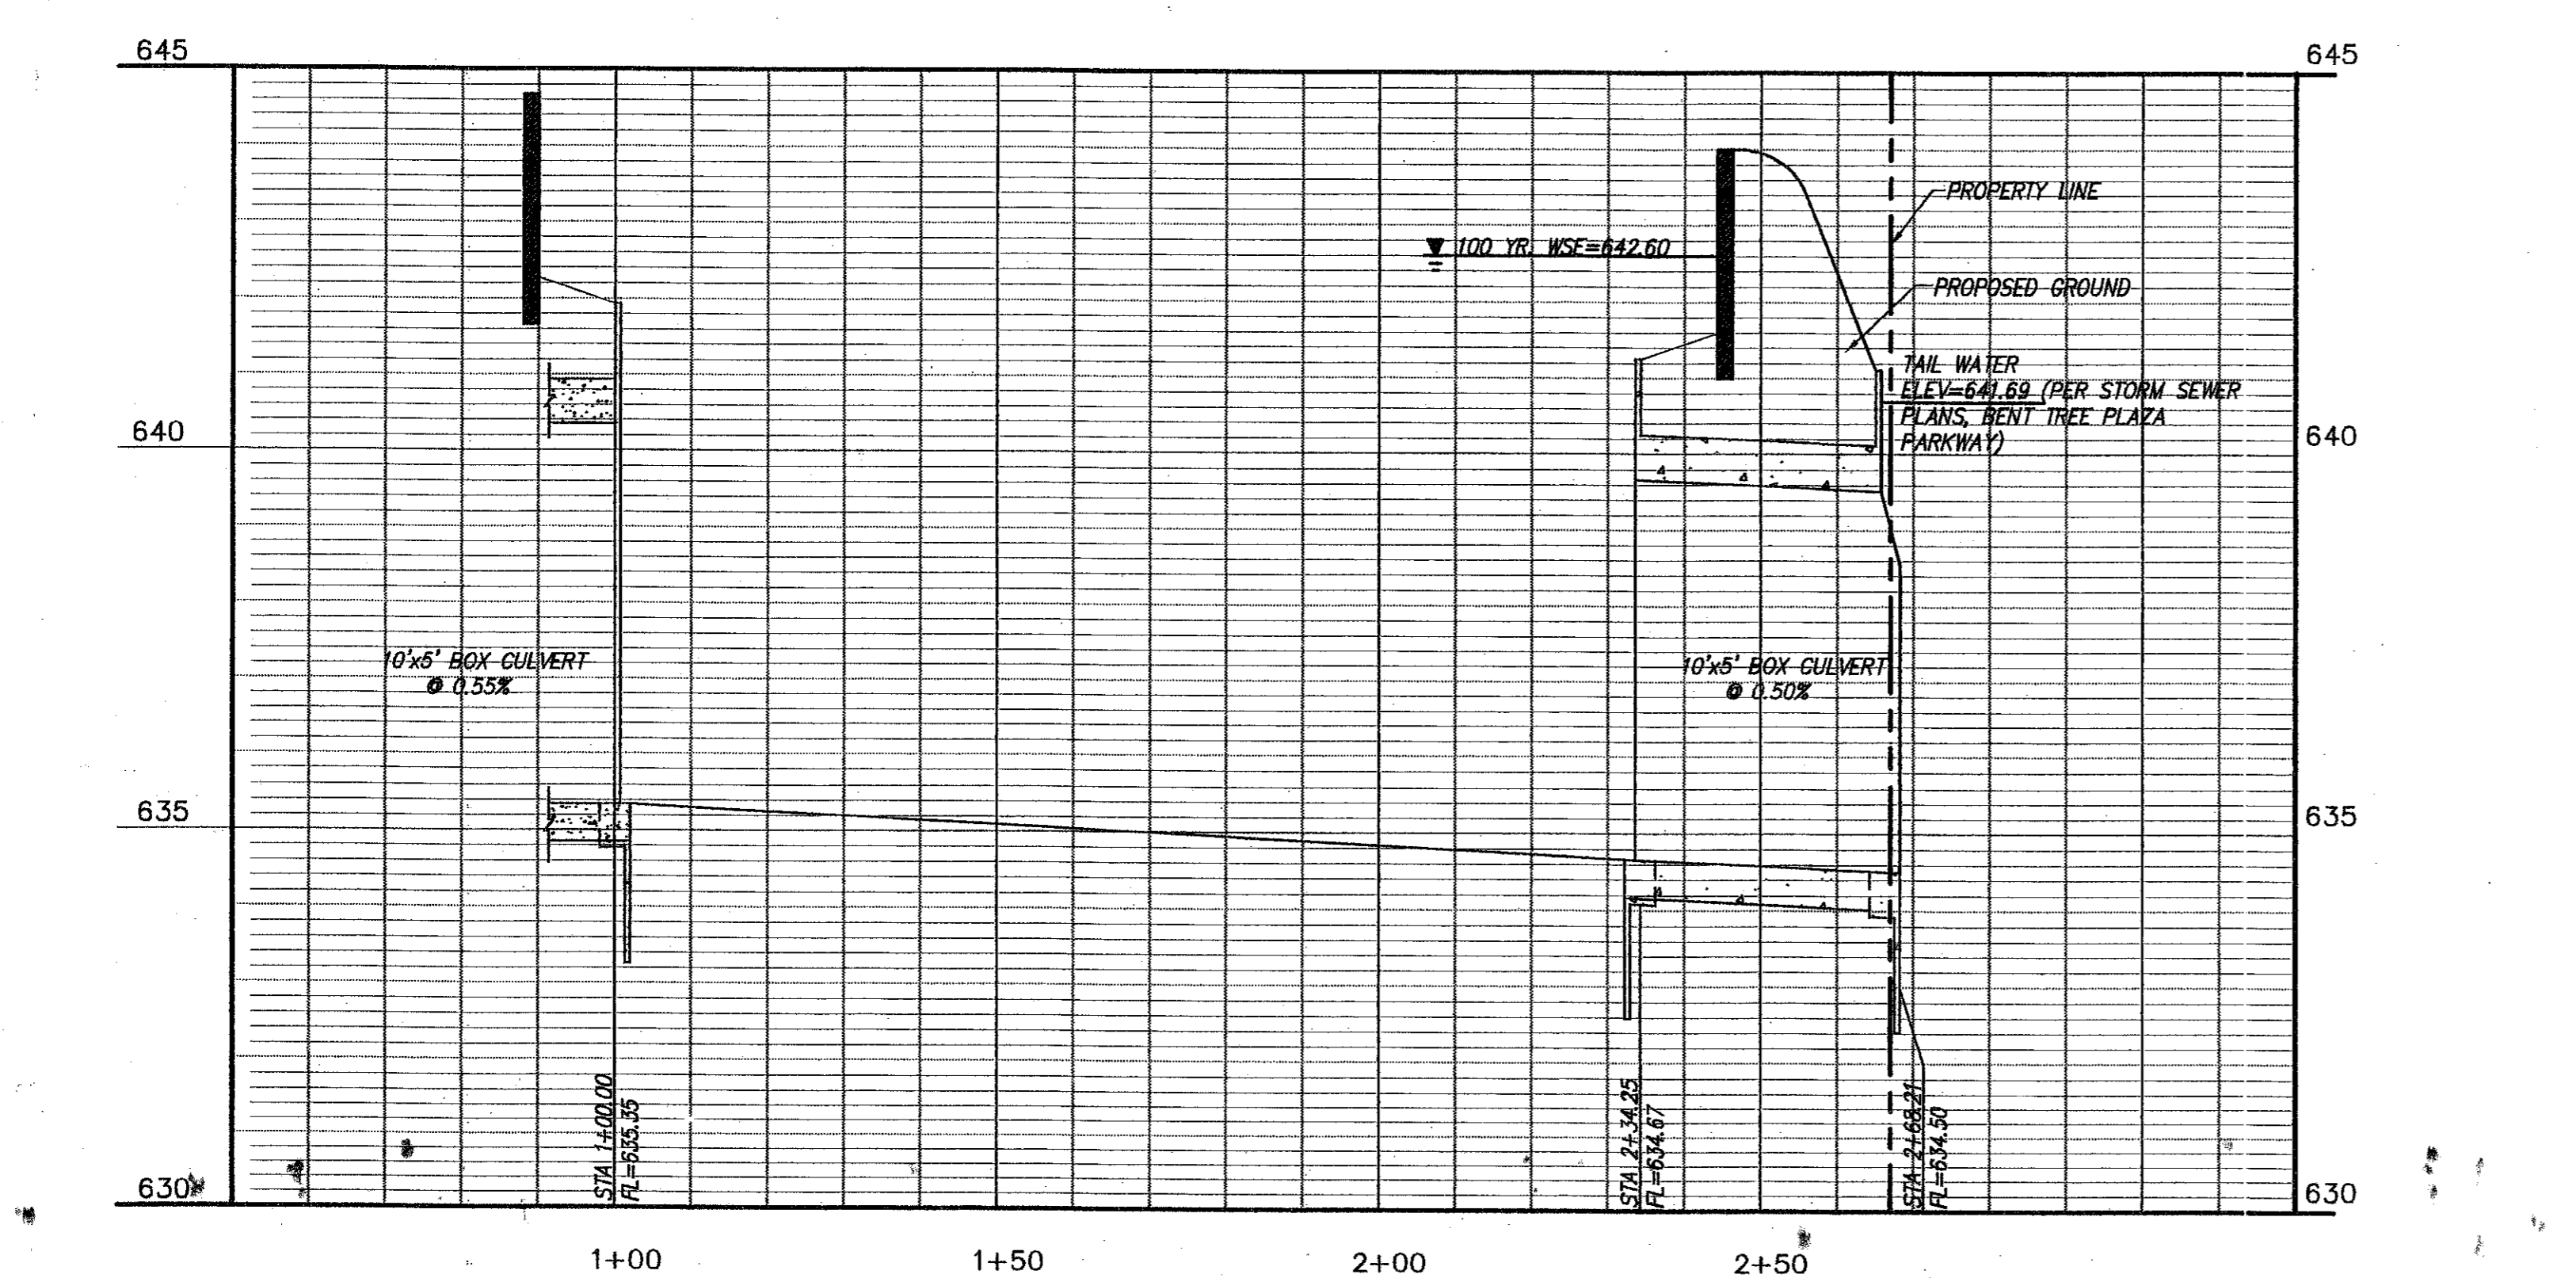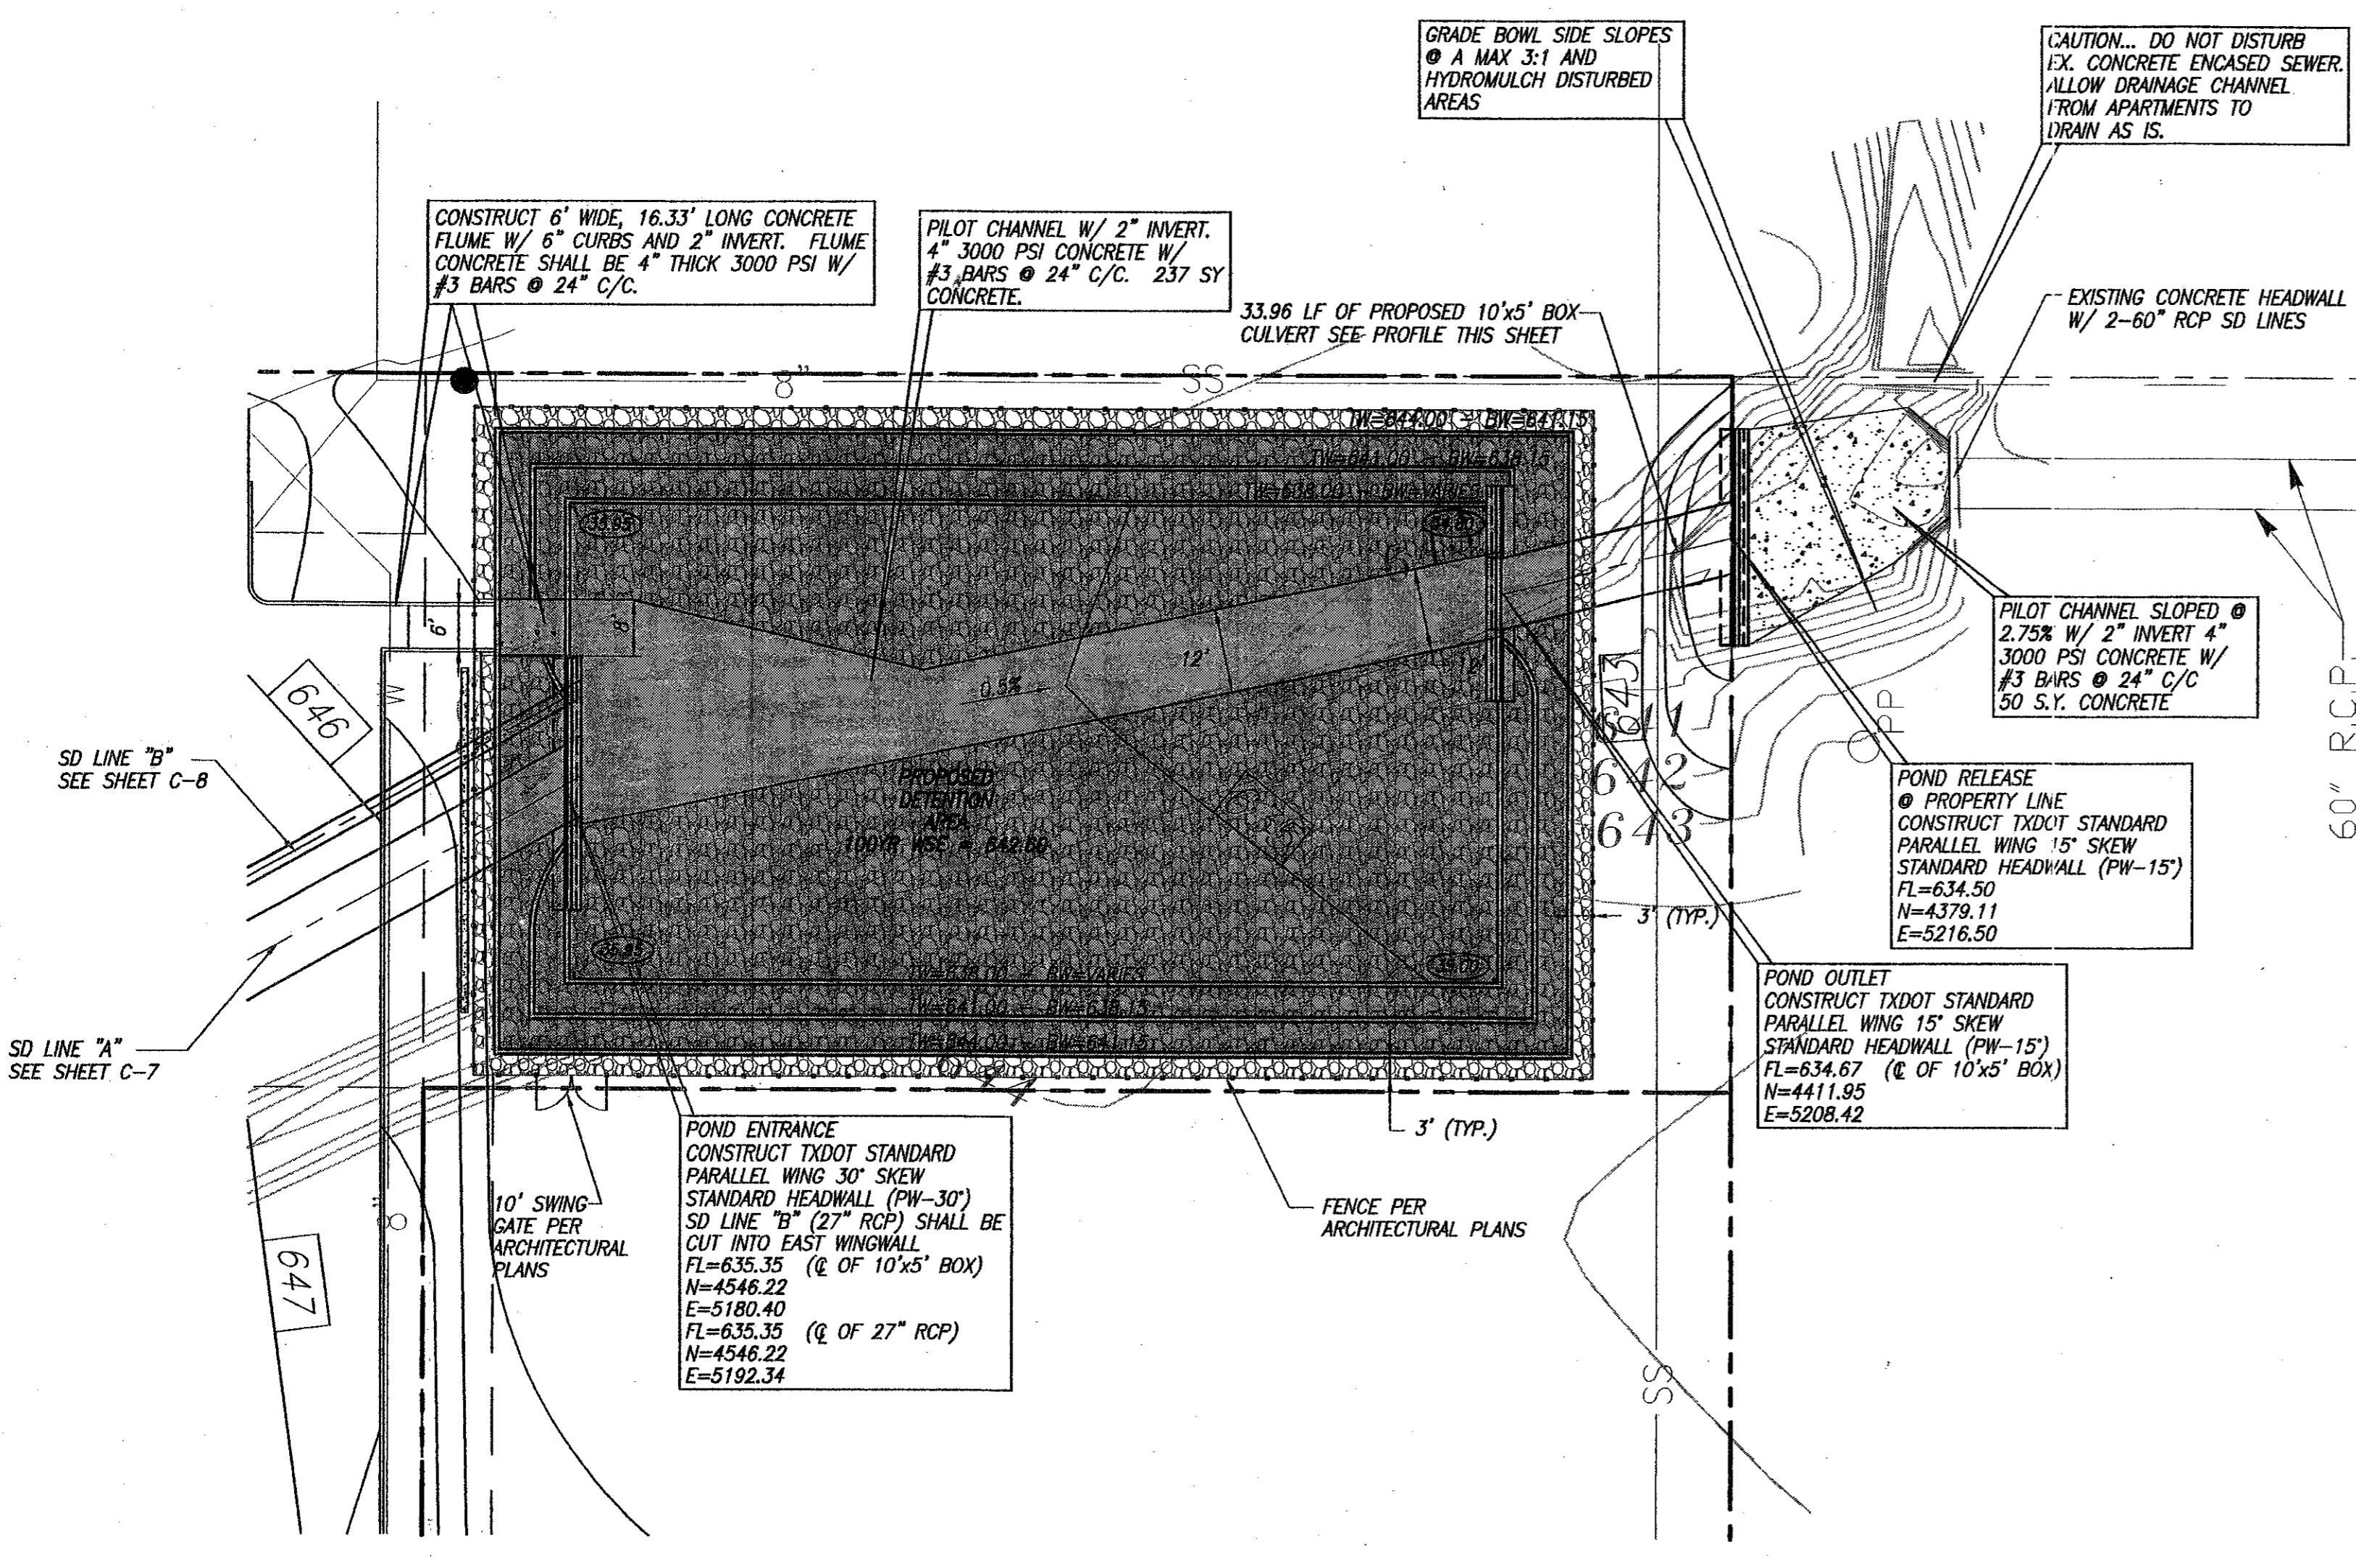

RETAINING WALL @ POND
 NOT TO SCALE

DETENTION POND RELEASE PIPE
 SCALE: HORIZ: 1"=20'
 VERT: 1"=2'

"AS-BUILTS"

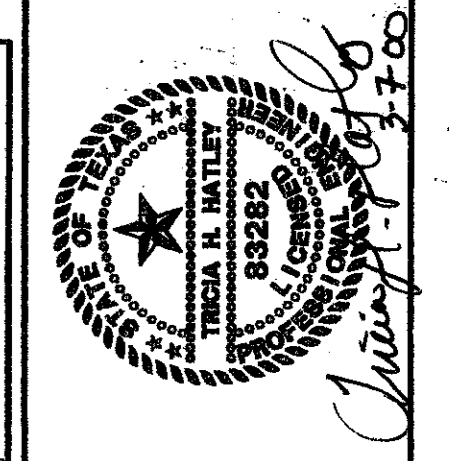

OMNIPLAN ARCHITECTS
SOJOURN OFFICE CENTER
 ADDISON, TEXAS
 NETWORK PLANS
DETENTION POND PLAN & CALCULATIONS

NO.	REVISION	DATE	BY	DATE	FILE	DESIGNED	DRAWN	REVIEWED	CHECKED	THH
1	PER CONTRACTOR REF "A" AND "B"	4/30/99	MDW	7-28-99	206POND	MDW	GAH			

VERIFY SCALE: Bar is one inch on original drawing. If not one inch on this sheet, adjust scale.