

SITWORK PLANS FOR SOJOURN OFFICE CENTER

LOT 1, BLOCK A, SOJOURN PLAZA ADDITION ADDISON, TEXAS

OWNER/DEVELOPER:

WILCOX DEVELOPMENT SERVICES
5420 LBJ FREEWAY, STE 740
DALLAS, TEXAS 75240
(972)770-2188

ARCHITECT:


OMNIPLAN
2711 N. HASKELL, STE 1340
DALLAS, TEXAS 75204
(214)826-7080

CIVIL ENGINEER:

FRESE AND NICHOLS, INC.
1341 W. MOCKINGBIRD, STE 230E
DALLAS, TEXAS 75247
(214)920-2500


SHEET INDEX

SEQ NO.	SHEET NO.	TITLE
1		COVER
2	C-0a	FINAL PLAT
3	C-0b	FINAL PLAT
4	C-1	EXISTING TOPOGRAHPIC & UTILITY MAP
5	C-2	DIMENSIONAL CONTROL & PAVING PLAN
6	C-3	GRADING & EROSION CONTROL PLAN
7	C-4	OFFSITE DRAINAGE AREA MAP
8	C-5	ONSITE DRAINAGE AREA MAP
9	C-6	STORM DRAINAGE PP LINE "A"
10	C-7	STORM DRAINAGE PP LINE "A"
11	C-8	STORM DRAINAGE PP LINE "B"
12	C-9	DETENTION POND PLAN & CALCULATIONS
13	C-10	UTILITY PLAN
14	C-11	UTILITY DETAILS
15	C-12	PAVING DETAILS
16	C-13	MISC. DETAILS & SEWER PROFILES

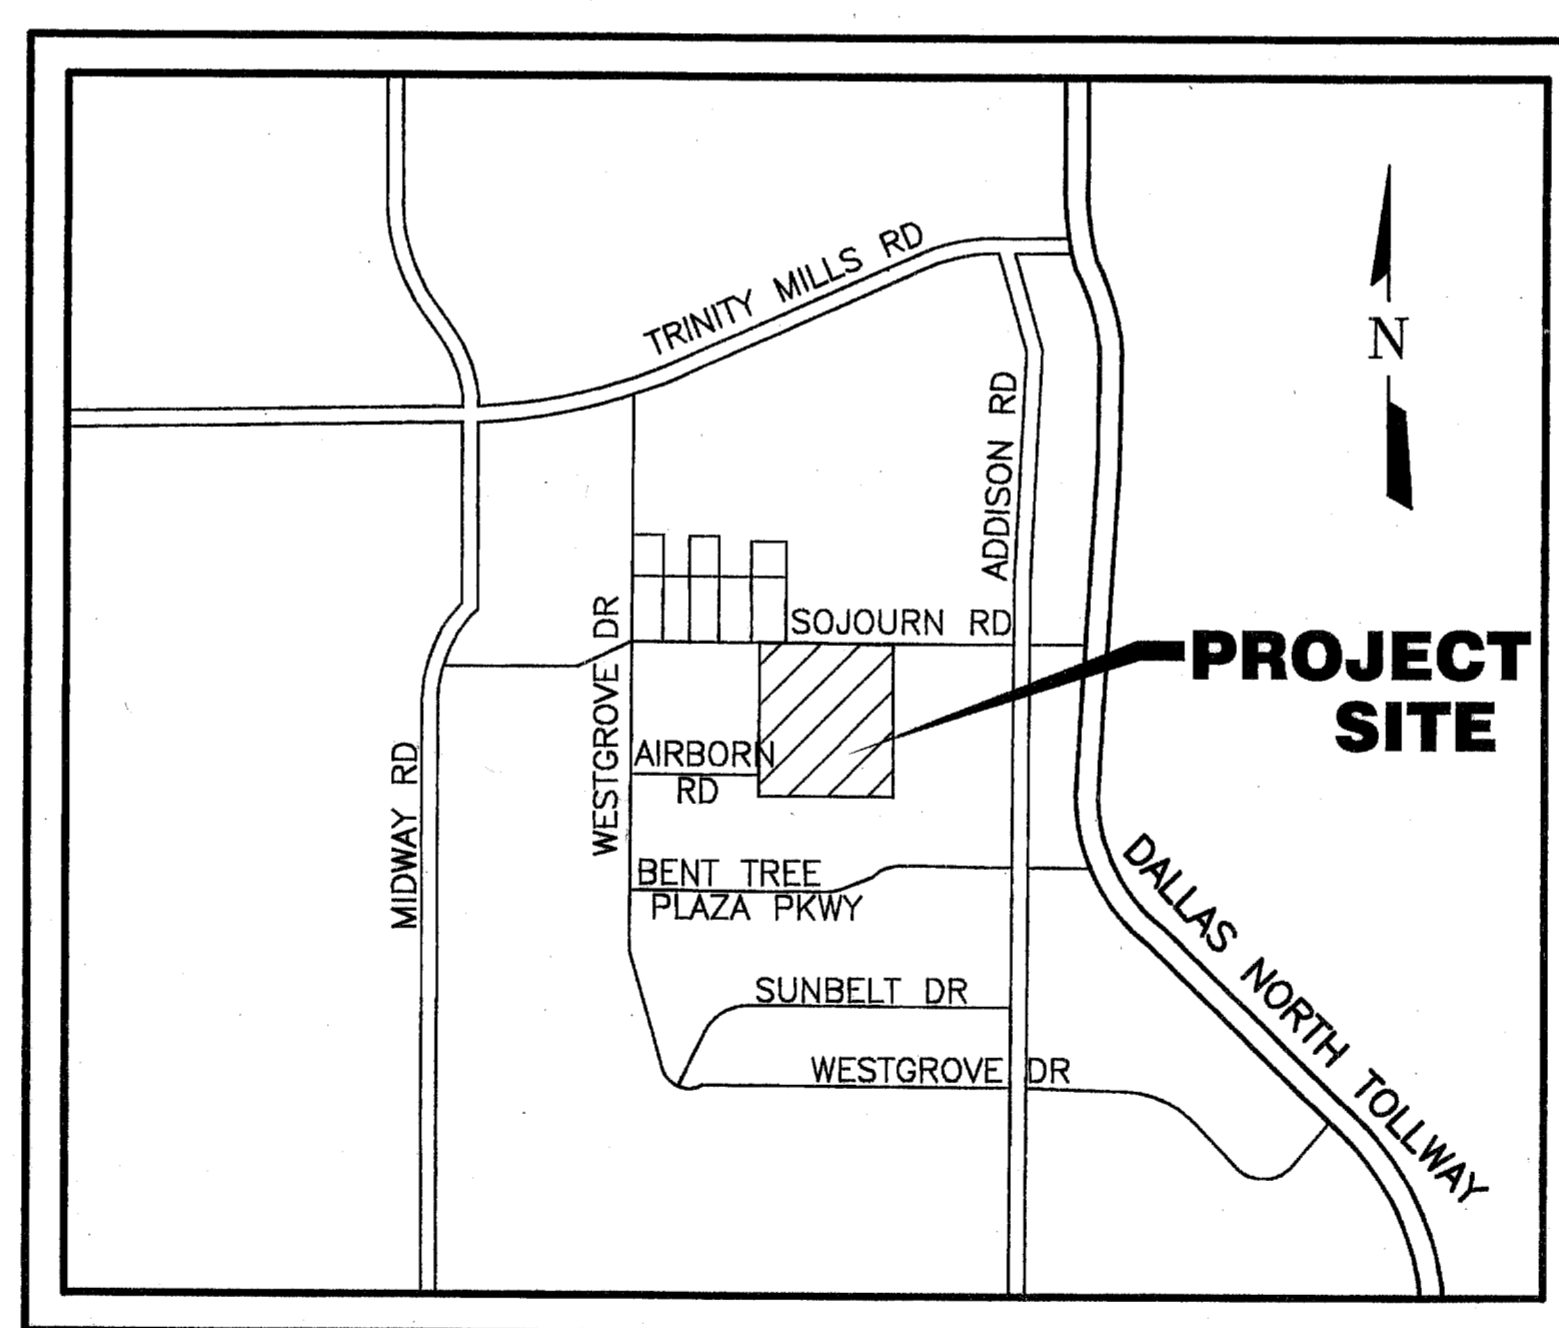

VICINITY MAP
N.T.S.

JULY, 1999

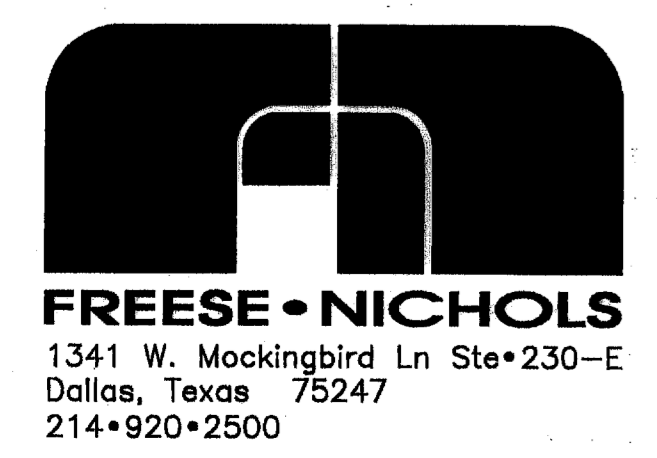

RECORD DRAWING
BASED ON THE INFORMATION
SUPPLIED BY THE CONTRACTOR
DATE: 9-5-00 TO: THH

THE SEAL APPEARING ON THIS DOCUMENT
WAS FORGED, SEALED AND DATED BY
ENGINEER: TRICIA H. HATLEY
TEXAS REGISTRATION NO: 83282
DATE: OCT. 6, 1999

