


RECORD DRAWING
 PREPARED BY THE CONTRACTOR
 DATE: 3-5-00 TO: THH

THE SEAL APPEARING ON THIS DOCUMENT IS THE PROPERTY OF
 ENGINEER TRICIA H. HATLEY
 TEXAS REGISTRATION NO: 83282
 DATE: OCT. 6, 1998

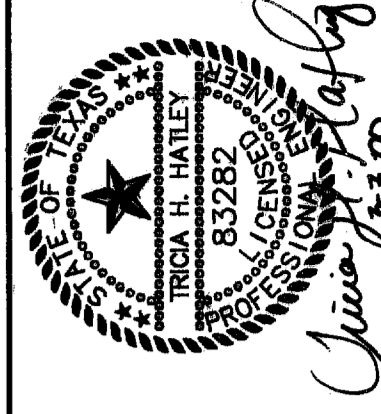

BENCHMARK:


SQUARE CUT ON INLET AT S.W. CORNER OF SOJOURN DR. AND ADDISON RD. ELEV. 641.95

LEGEND

EXISTING	
PROPERTY LINE	---
SANITARY SEWER	8" SS
WATER	8" W
STORM DRAIN	36" RCP
FIRE HYDRANT	⊕
WATER METER	⊙ WM
WATER VALVE	⊙ WV
POWER POLE	⊙ PP
SEWER MANHOLE	⊙ SMH
STORM DRAIN MANHOLE	⊙ SMH
SIGN POST	
TRAFFIC SIGN	
ELEC. JUNCTION BOX	⊙ EJC
ELEC. GUY WIRE	⊙
GAS	⊙
BOUNDARY POINT	⊙
CURB INLET	⊙
TREES	⊙

NOTES

- UNDERGROUND UTILITIES SHOWN ON THESE PLANS ARE BASED ON INFORMATION PROVIDED BY THE TOWN OF ADDISON AND GARCIA & ASSOCIATES.
- COORDINATES ARE BASED ON THE SURVEY PROVIDED BY GARCIA & ASSOCIATES, 6850 MANHATTAN BLVD., SUITE 300, FORT WORTH, TX. (817) 446-1800

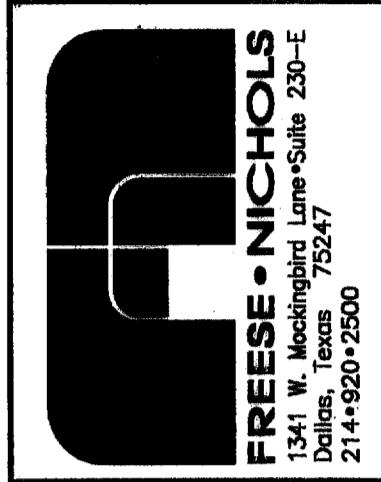

OMNIPLAN ARCHITECTS
SOJOURN OFFICE CENTER
 ADDISON, TEXAS

SITWORK PLANS
EXISTING TOPOGRAPHIC & UTILITY MAP

DALLAS GYMNASTICS CENTER
 LOT 1, BLOCK A
 VOL. 98073, PG. 25,
 D.R.D.C.T.

REMAINDER OF
 CALLED 18.258 ACRES
 VOL. 69216, PG. 1560,
 D.R.D.C.T.

CALLED 13.8607 ACRES
 PALMETTO CORNERS, LTD.
 VOL. 97248, PG. 523,
 D.R.D.C.T.

NO. REVISION	BY	DATE	F&N JOB NO.
1	MDW	4/20/99	OMP99206
PER CONTRACTOR REF. 1 AND 2		FILE	206EX-Topo
		DATE	7-26-99
		DESIGNED	MDW
		DRAWN	MDW
		CHECKED	THH
VERIFY SCALE		Bar is one inch on original drawing. If not one inch on this sheet, adjust scale.	
SHEET		C-1	
SEQ.		4 OF 16	

"AS-BUILTS"