


BENCHMARK:
SQUARE CUT ON INLET AT S.W. CORNER OF SOJOURN DR. AND ADDISON RD. ELEV. 641.95

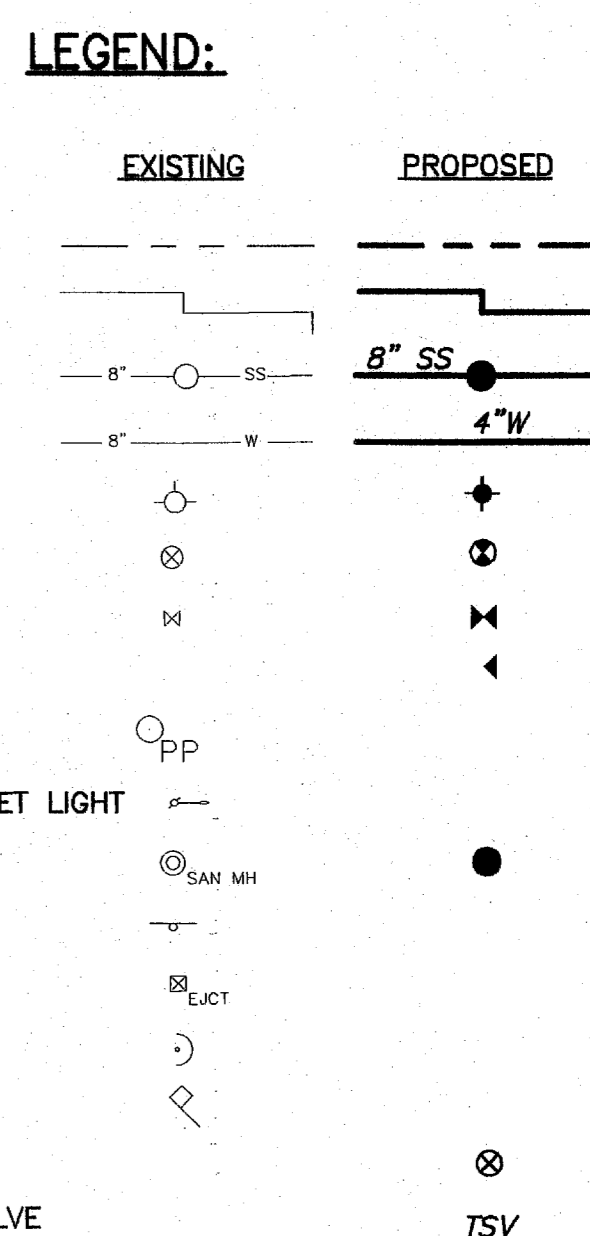

RECORD DRAWING
BASED ON THE INFORMATION
SUPPLIED BY THE CONTRACTOR
DATE: 3-5-99

THE SEAL AND SIGNATURE OF THE LICENSED PROFESSIONAL ENGINEER:
TRICIA H. HATLEY
TEXAS REGISTRATION NO. 83282
DATE: OCT. 6, 1989

FREESE-NICHOLS
1341 W. Montclair Lane, Suite 230-E
Dallas, Texas 75247
214-920-2500

OMNIPLAN ARCHITECTS
SOJOURN OFFICE CENTER
ADDISON, TEXAS

STEWORCK PLANS
UTILITY PLAN

NO.	REVISION	DATE	BY	FOR
1	PER CONTRACTOR RFT "Y" AND "B"	4/30/99	MW	
2	REVISED PER RASING FT. 1 FOOT	5/3/99	MW	
3	REVISED PER CITY COMMENTS	7/29/99	MG	
4	PER NORTH PL. MOVING 4' SOUTH	8/23/99	MW	

DESIGNED: MW
DRAWN: GWH
CHECKED: THH

Bar is one inch on original drawing. If not one inch on this sheet, adjust scale.

VERIFY SCALE: 0

SHEET **C-10**

SEQ. 13 OF 16

"AS-BUILTS"