


- NOTES:
- CONTRACTOR SHALL FIELD VERIFY HORIZ. AND VERT. LOCATION OF EXISTING UTILITY LINE.
  - NOTIFY ENGINEER TO ALLOW FOR ANY ADJUSTMENTS TO PROPOSED DESIGN, BASED ON FIELD VERIFICATION.
  - DO NOT CONSTRUCT ADJUSTMENT UNTIL APPROVAL IS GIVEN BY ENGINEER.
  - VERTICAL PI'S SHALL BE CONSTRUCTED USING STANDARD BENDS AND OR BY PROVIDING JOINT DEFLECTIONS NOT TO EXCEED 75% OF PIPE MANUFACTURER'S MAXIMUM RECOMMENDATIONS.

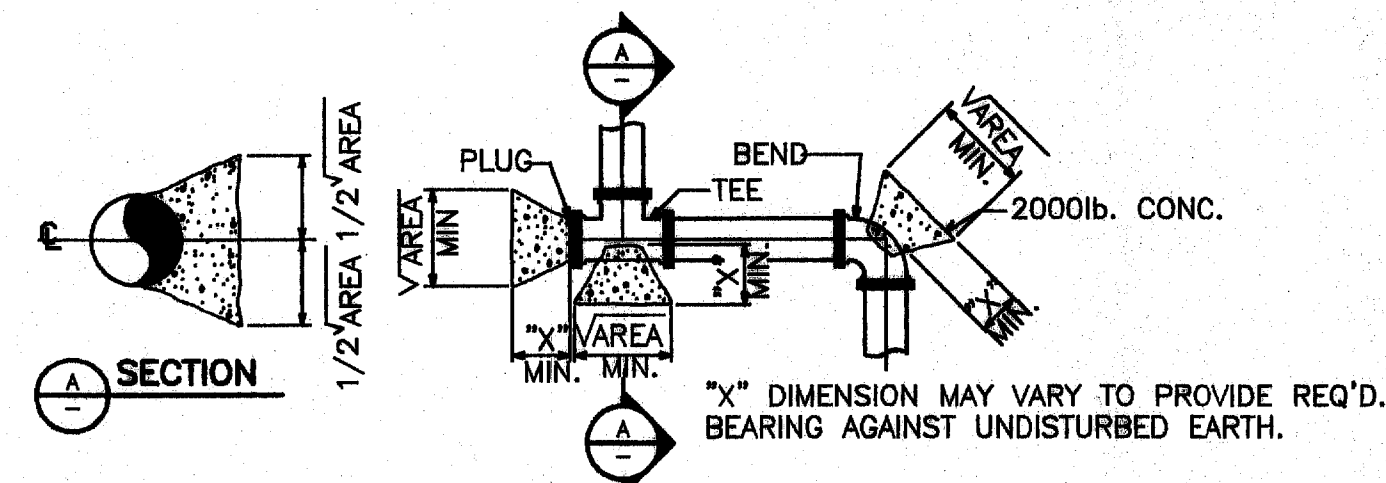


HORIZONTAL BLOCKING TABLE									
DEPTH OF COVER TO TOP OF PIPE (FT) : 3.5			BLOCKING (SQUARE FEET) THRUST (POUNDS-FORCE)						
PIPE SIZE (IN)	DEPTH OF COVER TO PIPE (FT)	TEST PRESSURE (LBS)	DEAD END AND TEE	90 BEND	45 BEND	22.5 BEND	11.25 BEND	5 DEFLECT.	"X"-DIM. (FT)
8	3.8	150	7.87	11.13	6.02	3.07	1.54	0.69	1.00
			7,540	10,663	5,771	2,942	1,478	658	
12	4.0	150	16.96	23.99	12.98	6.62	3.33	1.48	1.25
			16,965	23,992	12,984	6,619	3,326	1,480	
16	4.2	150	28.95	40.95	22.16	11.30	5.88	2.53	1.50
			30,159	42,652	23,083	11,768	5,912	2,631	

- NOTES:
- THRUST BLOCK AREAS SHOWN ARE BASED ON TEST PRESSURES OF 150 P.S.I. AND 250 P.S.F. PER VERTICAL FOOT OF SOIL COVER MEASURED TO CENTERLINE OF PIPE.
  - MINIMUM AREAS SHOWN ARE IN SQUARE FEET AND ARE BASED UPON MIN 3.5 FEET OF COVER TO TOP OF PIPE. BEARING MUST BE ON UNDISTURBED EARTH.
  - ADJUST THRUST BLOCK AREAS ACCORDINGLY IF PRESSURES, DEPTH OF COVER AND/OR SOIL BEARING VALUE VARIES.


BENDS		90°	45°	22 1/2°	11 1/4°
* VOL. REQ'D.	C.F.	28.27	22.61	11.33	5.65
6	A	1.75	1.5	1.0	0.75
	B	4.0	3.88	3.36	2.75
	C	4.0	3.88	3.36	2.75
* VOL. REQ'D.	C.F.	50.27	40.21	20.11	10.05
8	A	2.0	1.75	1.5	1.0
	B	5.0	4.8	3.66	3.2
	C	5.0	4.8	3.66	3.2
* VOL. REQ'D.	C.F.	78.54	62.83	31.41	15.71
10	A	2.25	2.0	1.75	1.5
	B	5.9	5.6	4.25	3.25
	C	5.9	5.6	4.25	3.25
* VOL. REQ'D.	C.F.	153.94	123.15	61.57	30.79
12	A	4.0	3.5	2.0	1.75
	B	6.2	6.0	5.54	4.2
	C	6.2	6.0	5.54	4.2

\* VOLUME CALCULATED ON THE BASIS OF CONCRETE REACTING THRUST ON THE RESPECTIVE BENDS UNDER AN INTERNAL PRESSURE OF 150 PSIG AT THE RATE OF 150 LB. WT. PER CU.FT. OF CONCRETE.

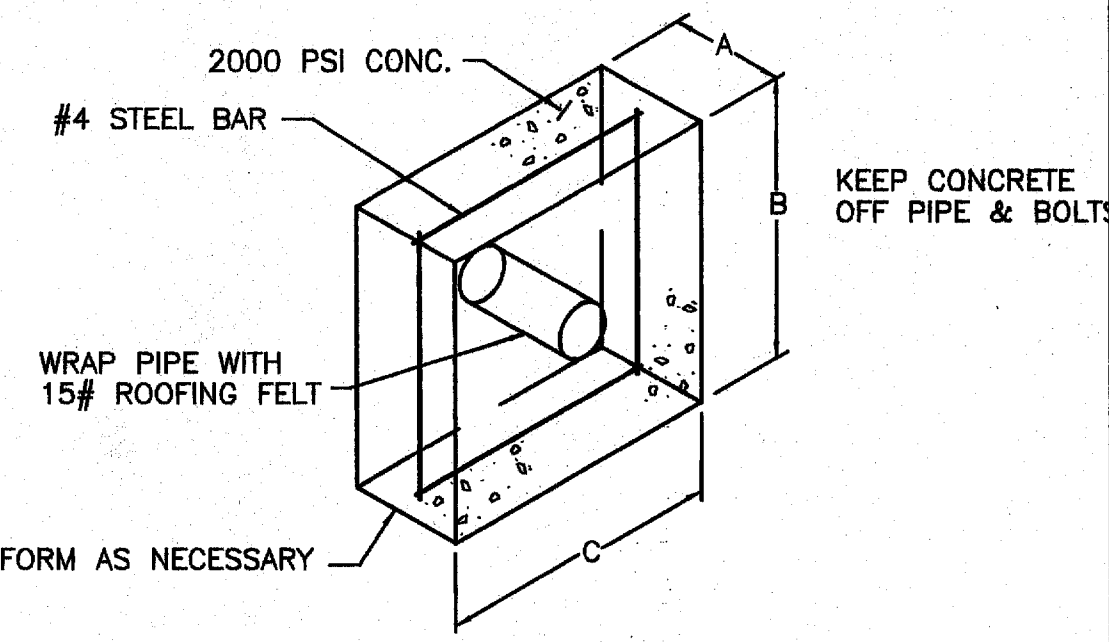


RECORD DRAWING  
BASED ON THE INFORMATION SUPPLIED BY THE CONTRACTOR  
DATE: 3-4-99 TO: THH

THE SEAL, APPROVED OF THE PROJECT OF ENGINEER: TRICHA H. HATLEY TEXAS REGISTRATION NO. 63282 DATE: OCT. 6, 1999

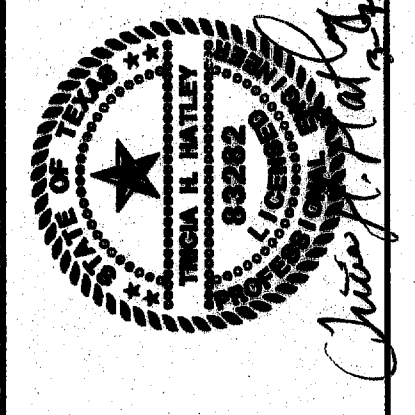


**FREESE-NICHOLS**  
1341 W. Washington Lane Suite 230-E  
Dallas, Texas 75247  
214-920-2500


1 TYPICAL VERTICAL WATERLINE ADJUSTMENT  
NOT TO SCALE

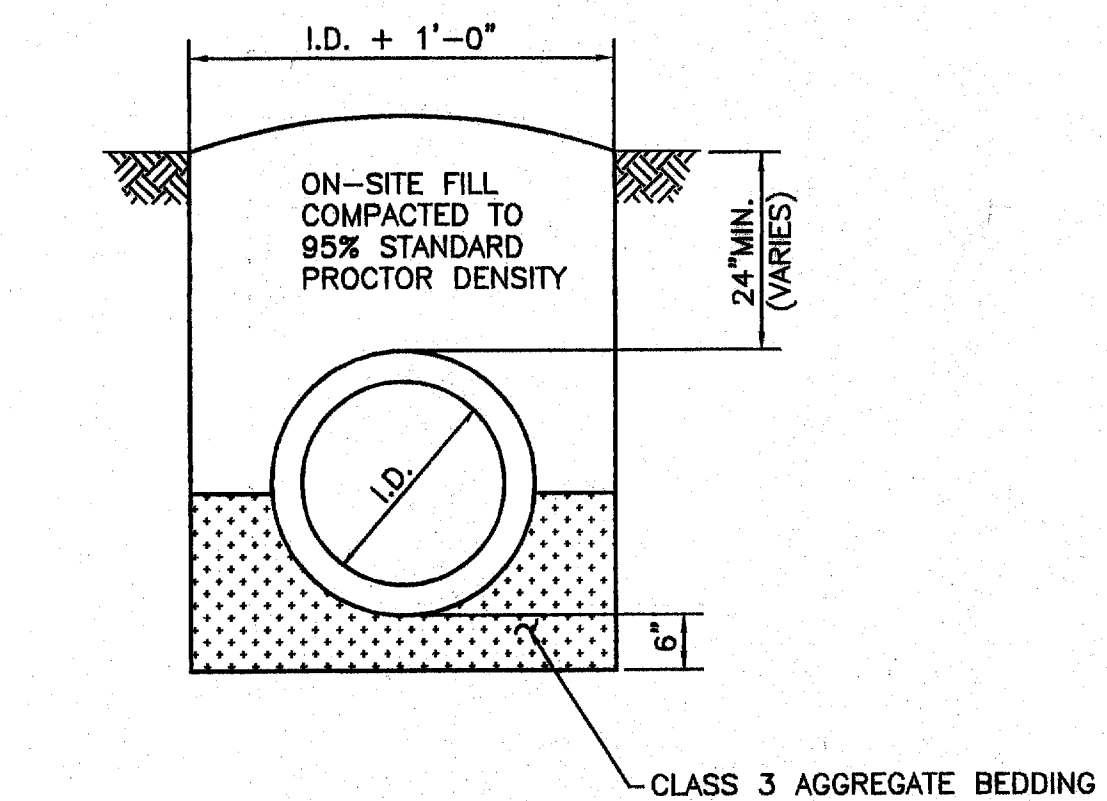

4 STORM DRAIN TRENCH  
NOT TO SCALE

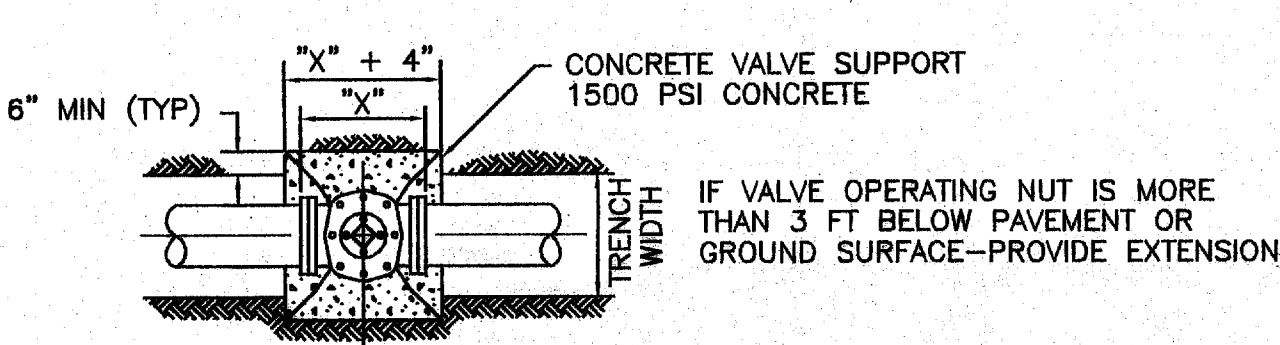


2 TYPICAL BLOCKING DETAIL  
NOT TO SCALE

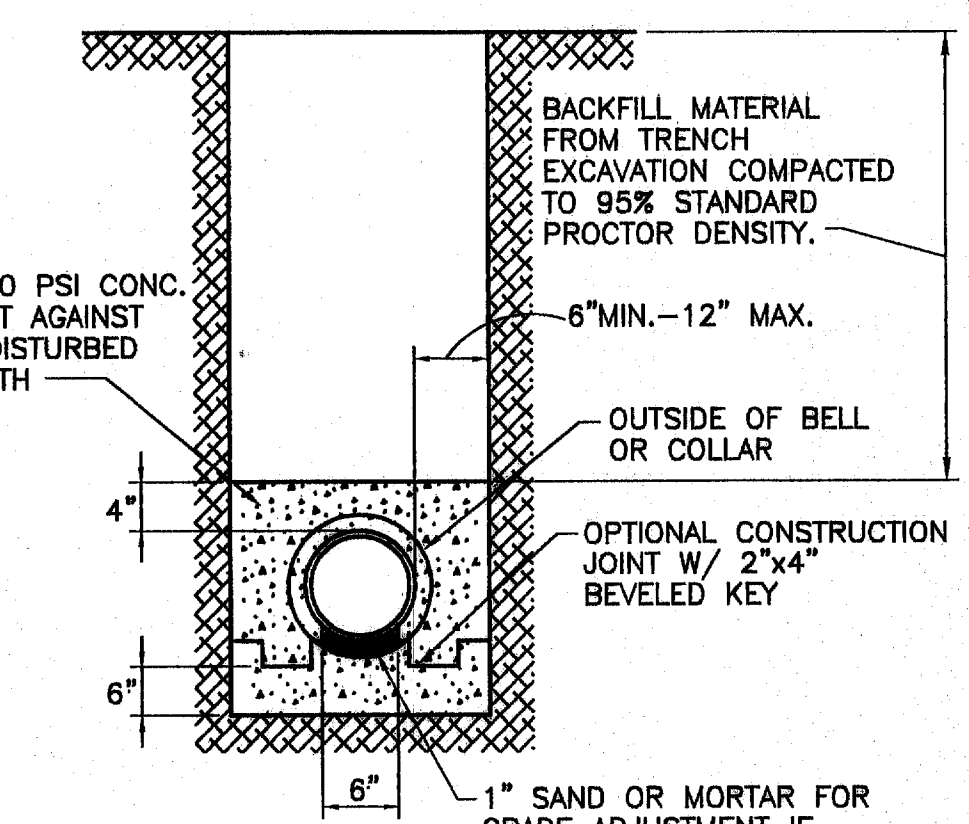


6 TYPICAL PVC LINE TRENCH DETAIL  
NOT TO SCALE

3 VERTICAL TIE-DOWN BLOCK DETAIL  
NOT TO SCALE

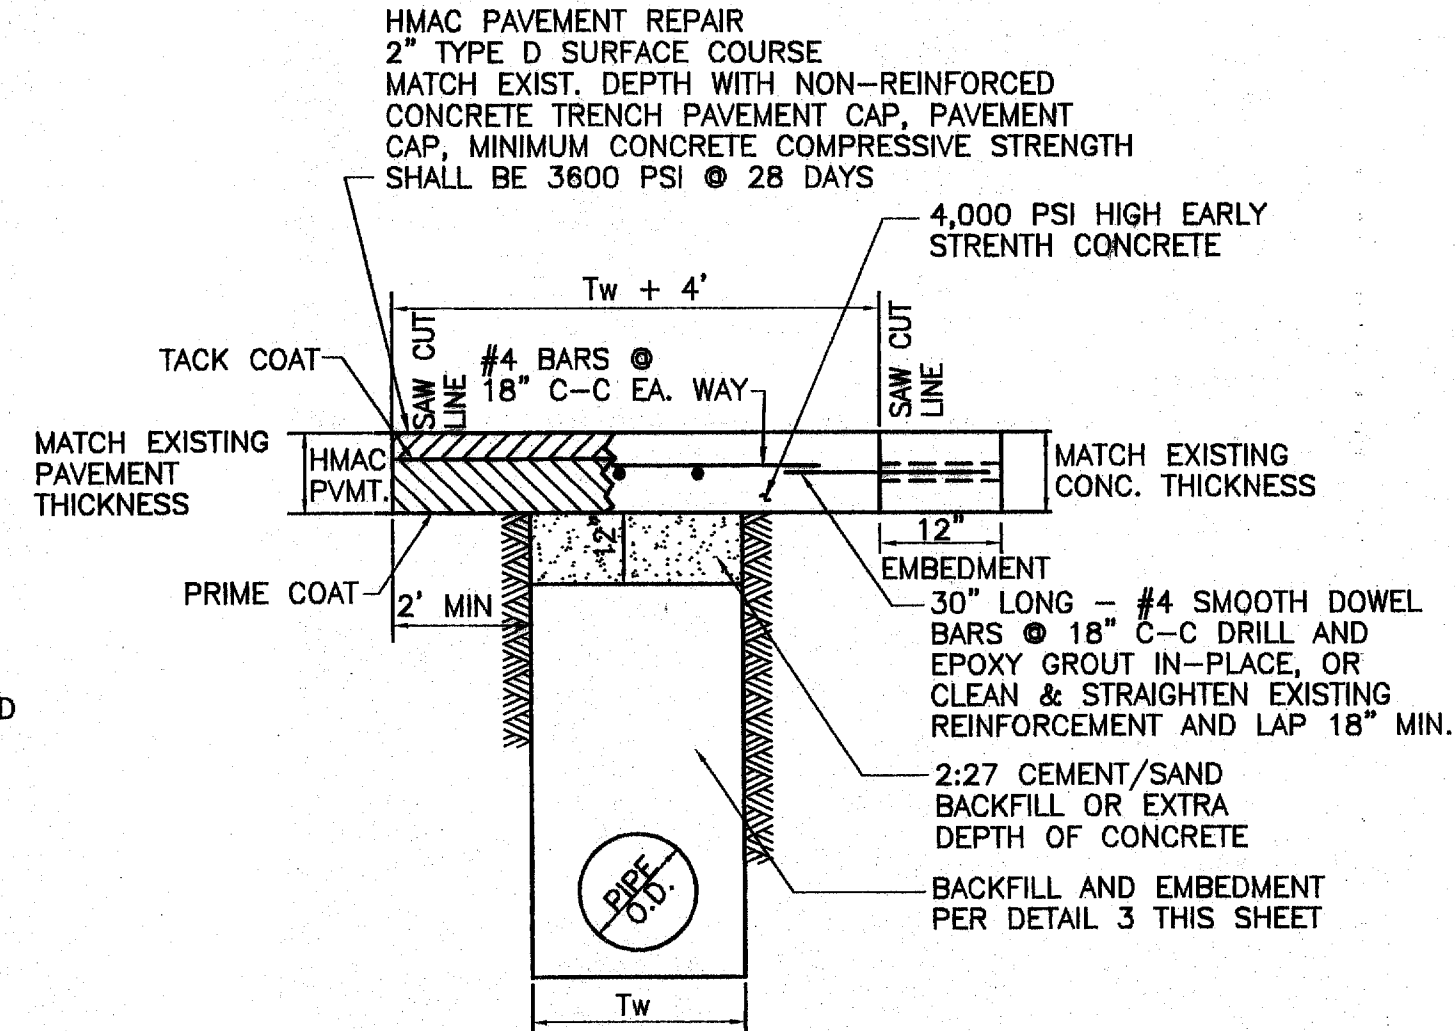


7 TYPICAL PAVEMENT REPAIR TRENCH DETAIL  
NOT TO SCALE


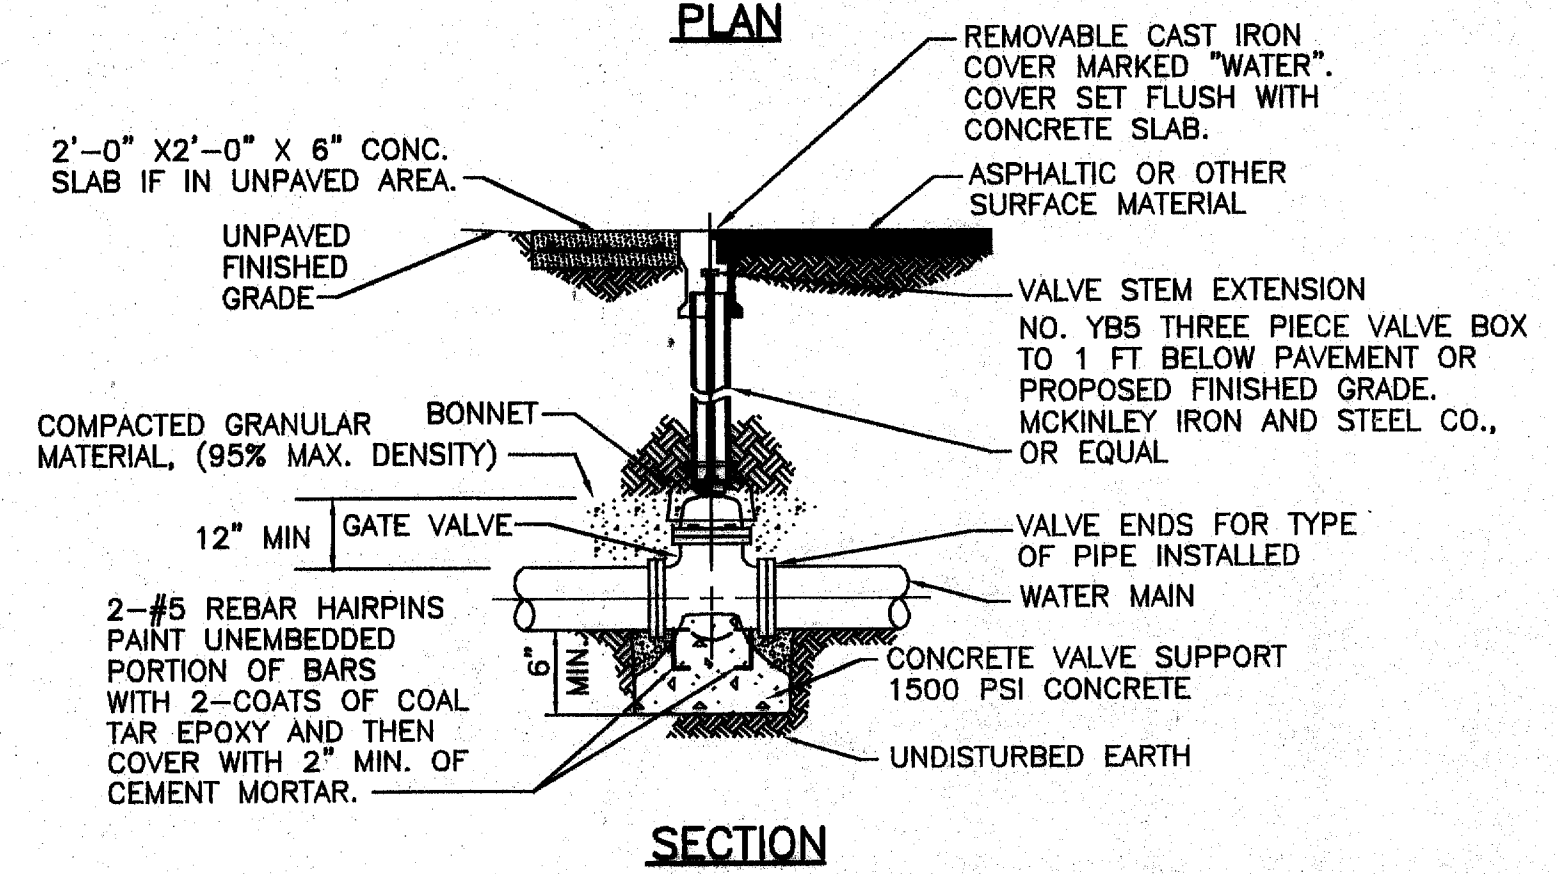


- NOTES:
- ALL BURIED VALVES SHALL BE PROVIDED W/EXTENSION STEM OPERATOR W/ 2" SQ. AWWA NUT WITHIN 1' BELOW FINISHED GRADE. NUT IS TO INDICATE DIRECTION OF ROTATION TO OPEN VALVE.
  - COAT BURIED PIPE & VALVE BOX PER SPECIFICATIONS. WRAP WITH 8 MIL. POLYETHYLENE.
  - CLEAN VALVE BOX OF ALL DEBRIS AND SOIL.
  - VALVE SIZE & TYPE AS SHOWN ON PLANS.

8 TYP. VALVE, VALVE BOX, AND EXTENSION INSTALLATION DETAIL  
NOT TO SCALE

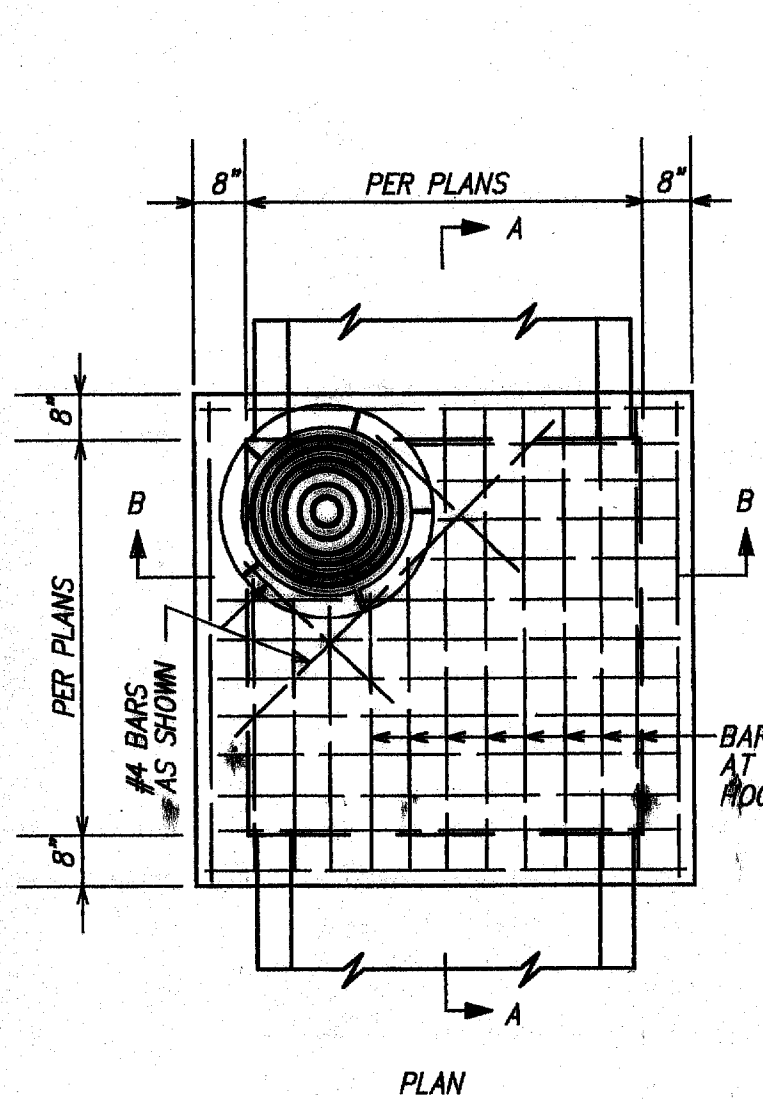

9 STORM DRAIN MANHOLE  
NOT TO SCALE

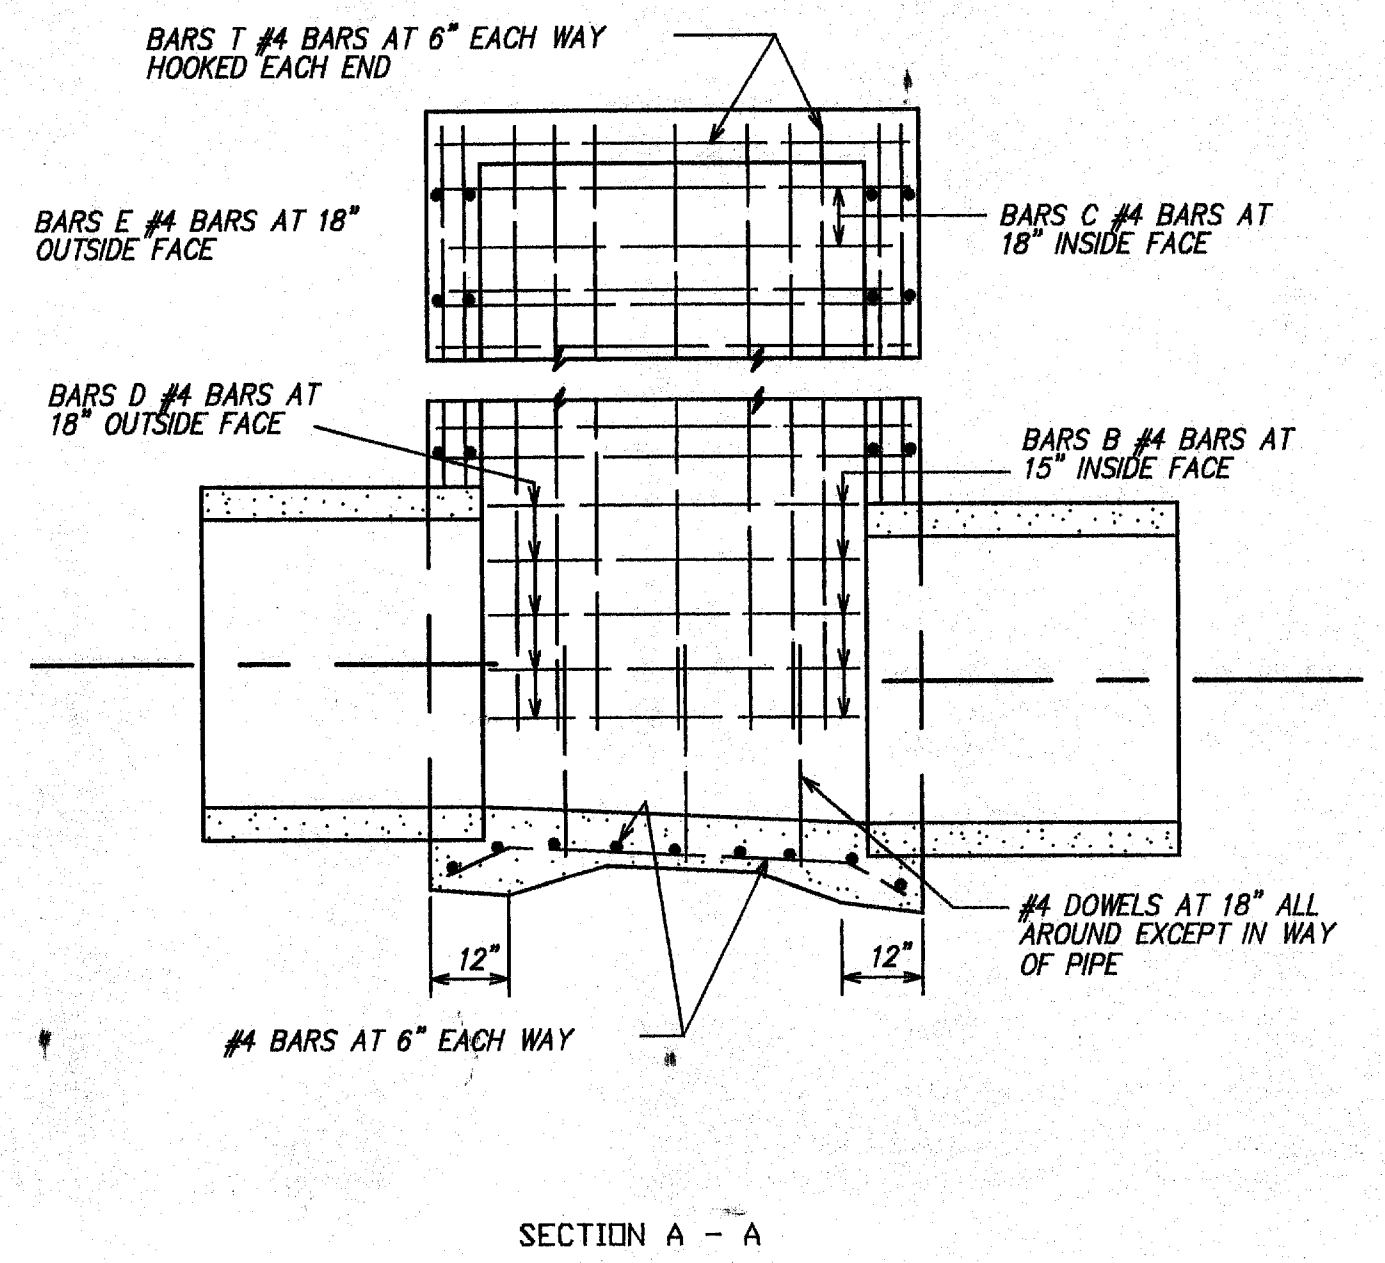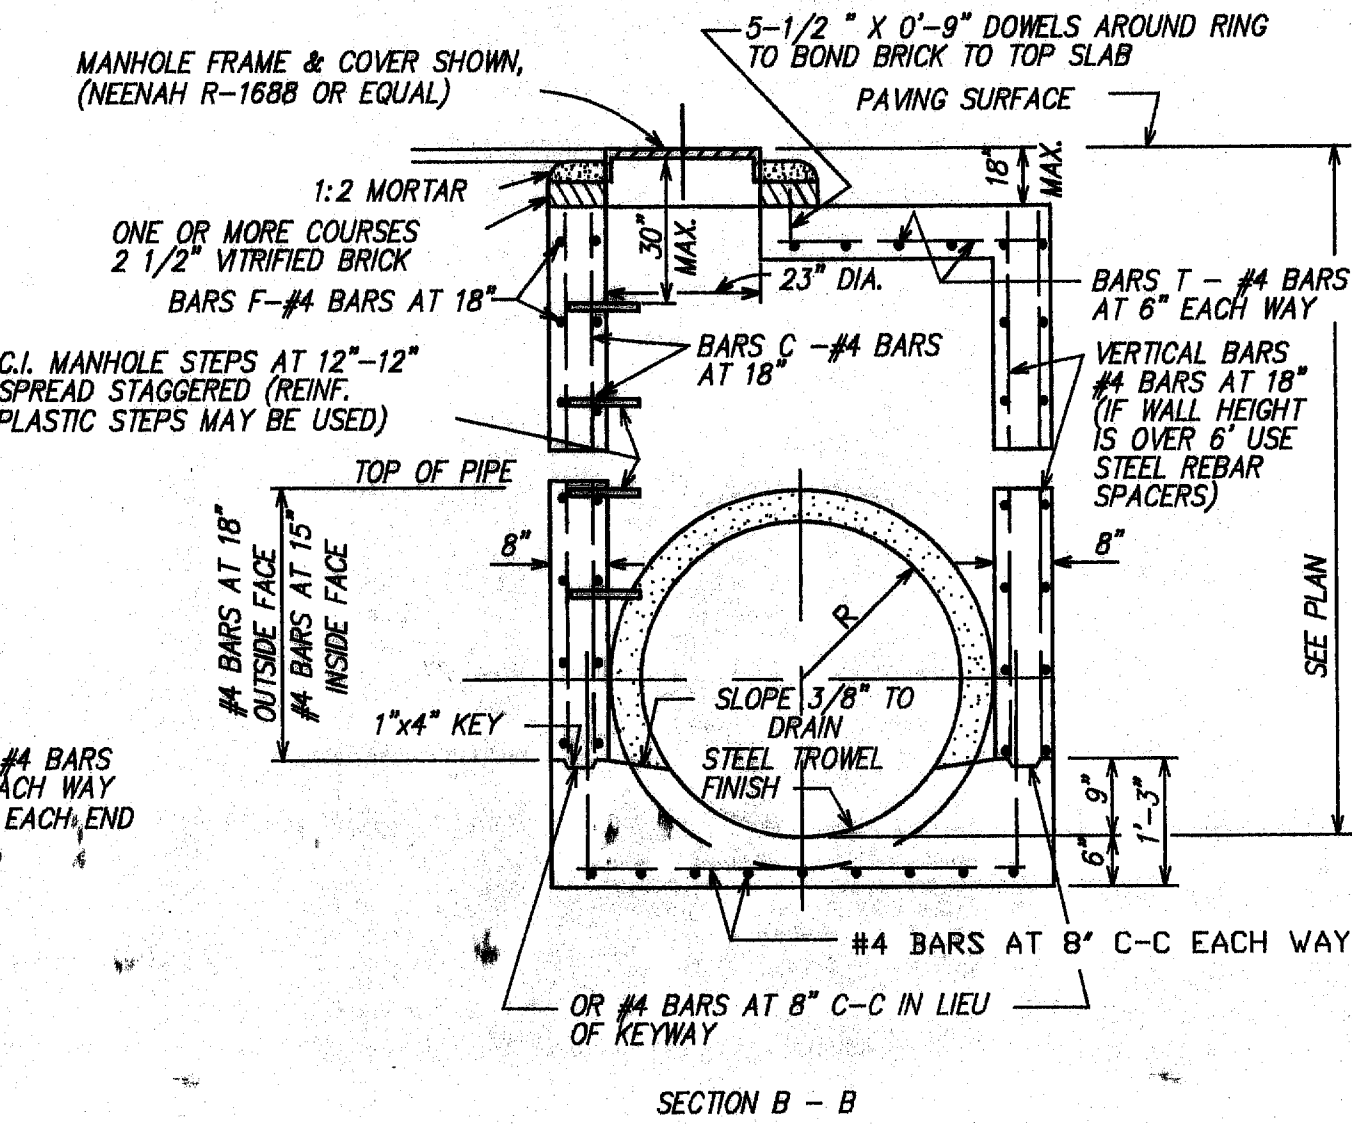

TYPICAL CORNER DETAIL  
PLAN VIEW

OMNIPLAN ARCHITECTS  
**SOJOURN OFFICE CENTER**  
ADDISON, TEXAS

SITWORK PLANS  
UTILITY DETAILS

NO. REVISION	DATE	BY	DATE	FILE	DATE	DESIGNED	DRAWN	REVISED	CHECKED	THH
		MDW	4/20/99	206DET-UTIL	7-26-99					

PER CONTRACTOR REF. 1" AND 3"

VERIFY SCALE: Bar is one inch on original drawing. If not one inch on this sheet, adjust scale.

SHEET C-11

SEQ. 14 OF 16

"AS-BUILTS"