



NOTES:


1. MAXIMUM SLOPE ON BARRIER FREE RAMPS MUST NOT EXCEED 1" PER 1' IN ANY DIRECTION.
2. GROOVES MUST BE CLEAN AND STRAIGHT FOR CLEAR DETECTION BY TOUCH WITH A CANE AND PARALLEL TO CROSSWALKS.
3. RAMP 6' LONG W/1:12 SLOPE AND GROOVES 1/8"x1/4" @ 2" C-C

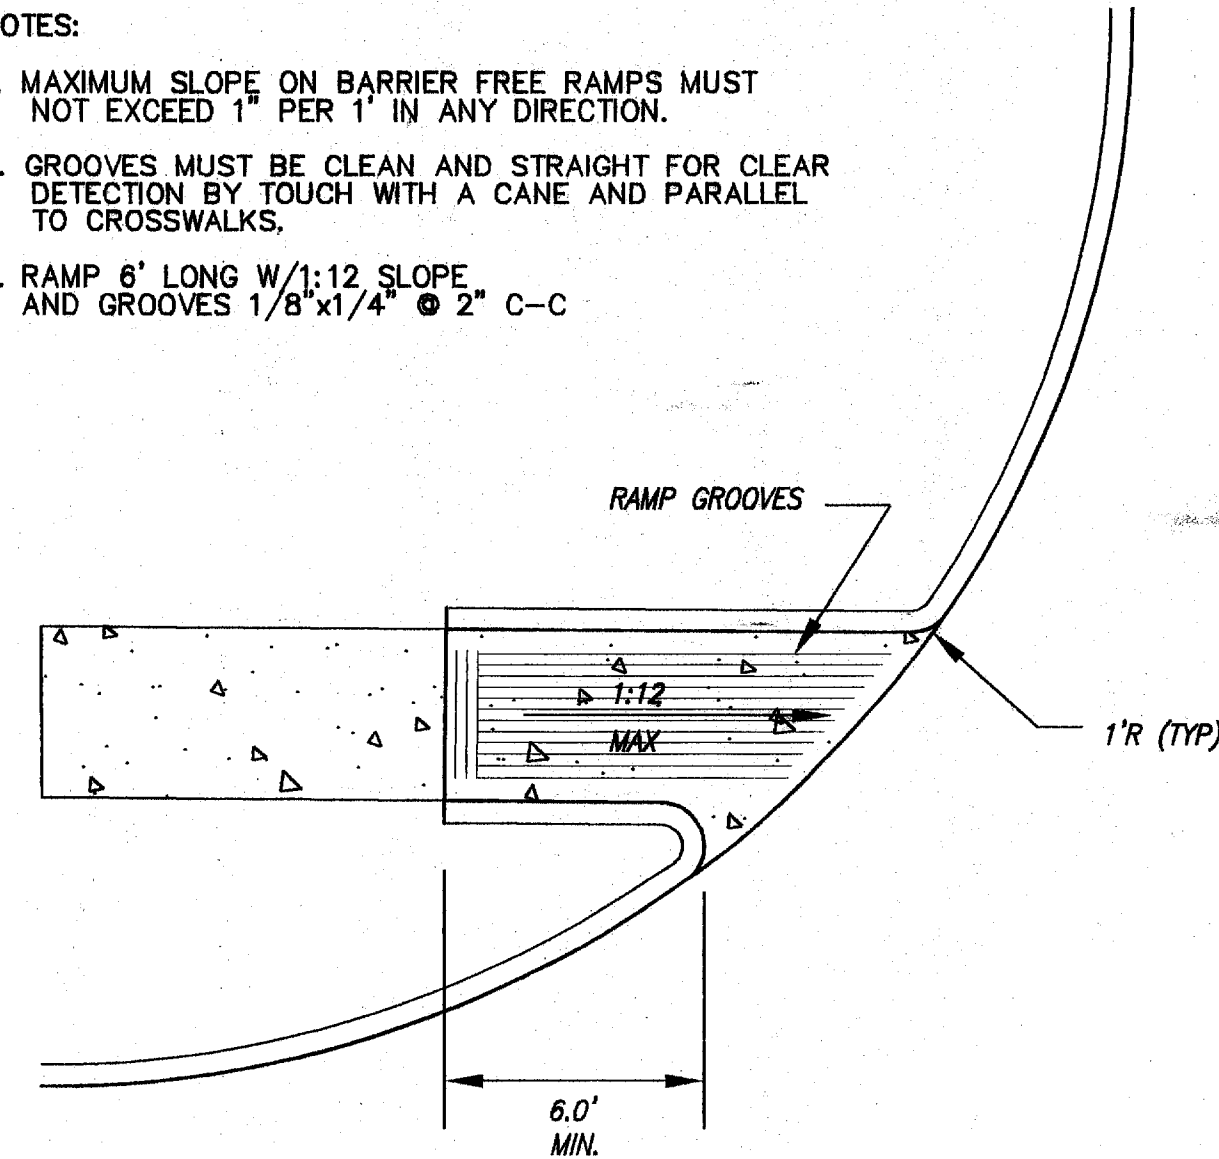


1 CURB RAMP DETAIL
NOT TO SCALE

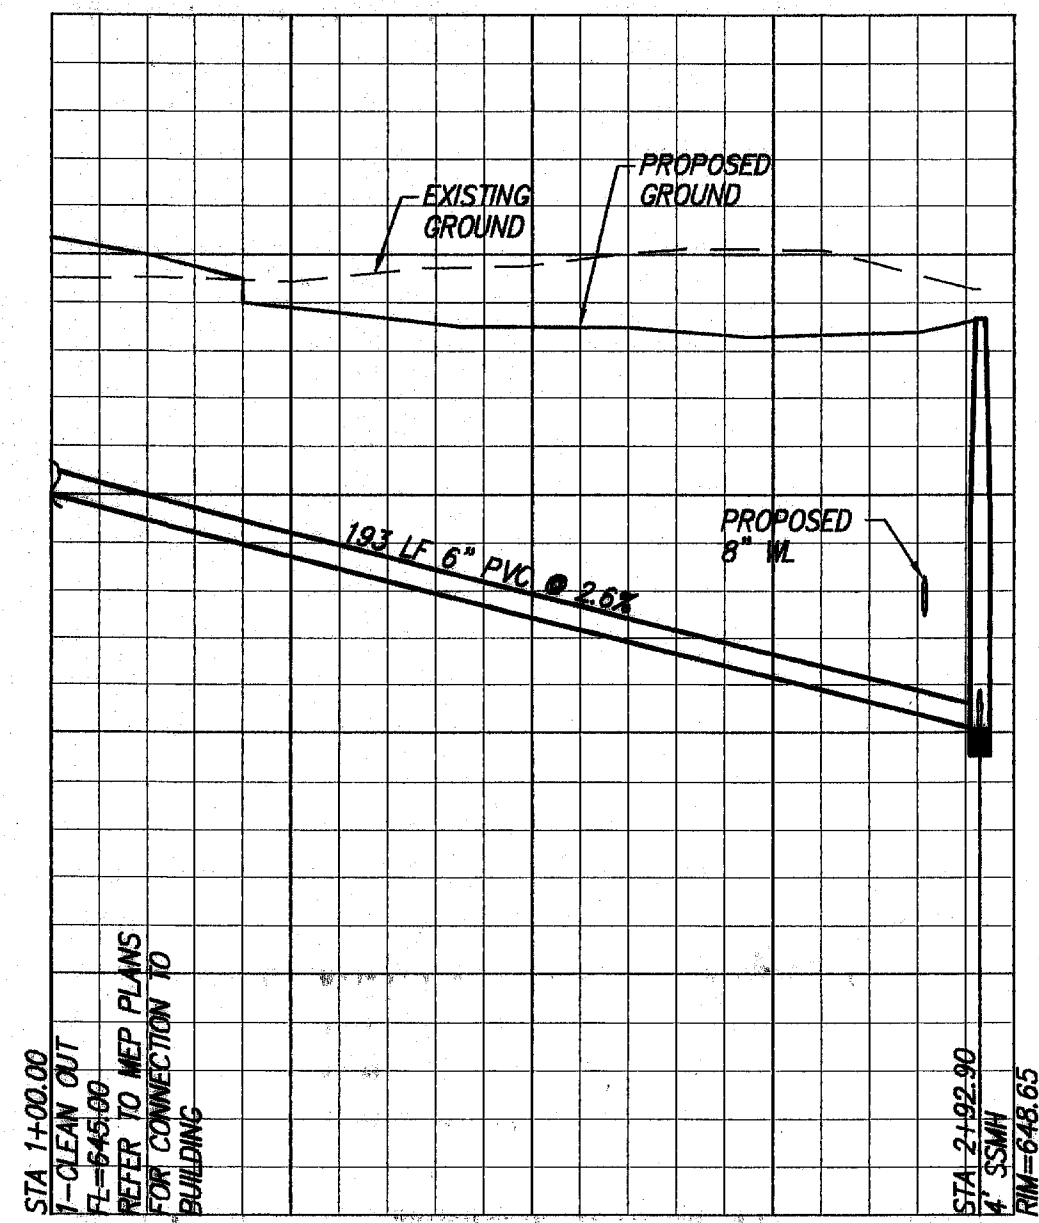

SANITARY SEWER PROFILE - LINE A
SCALE: 1"=40' HORIZ.
1"=4' VERT.

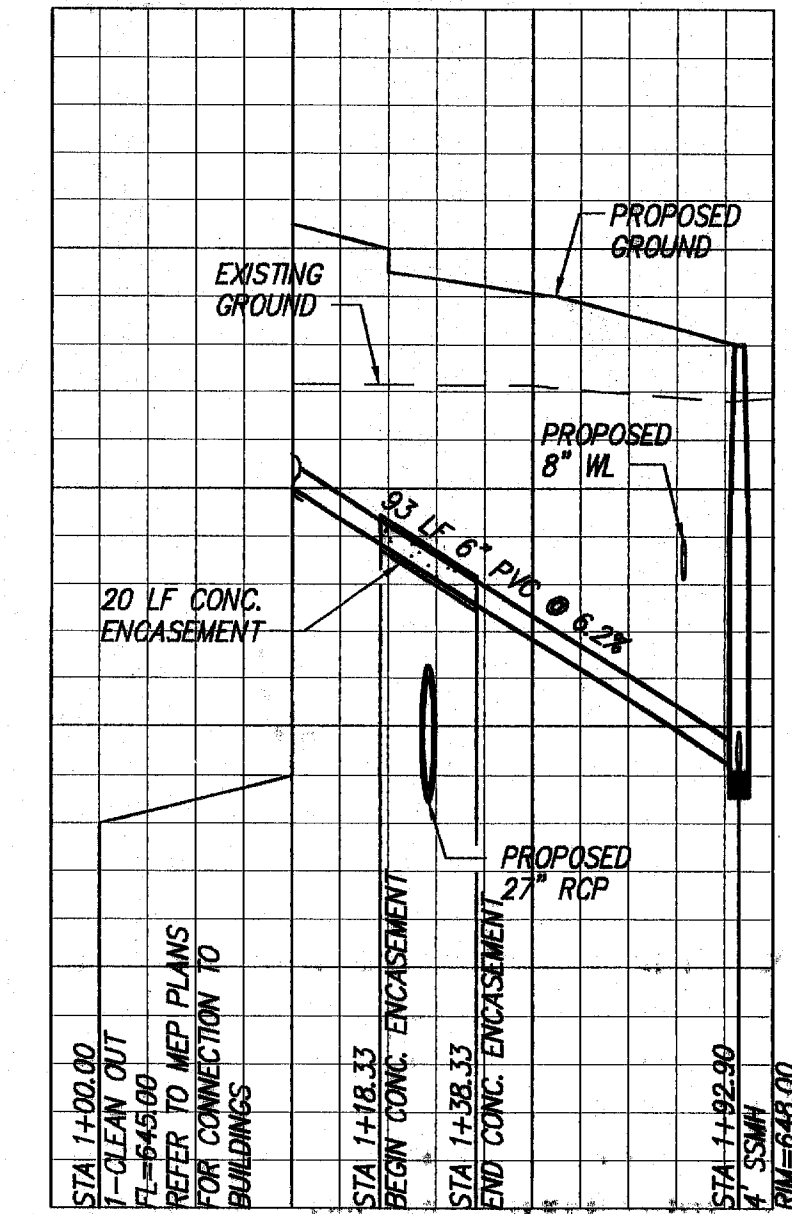


SANITARY SEWER PROFILE - LINE B
SCALE: 1"=40' HORIZ.
1"=4' VERT.

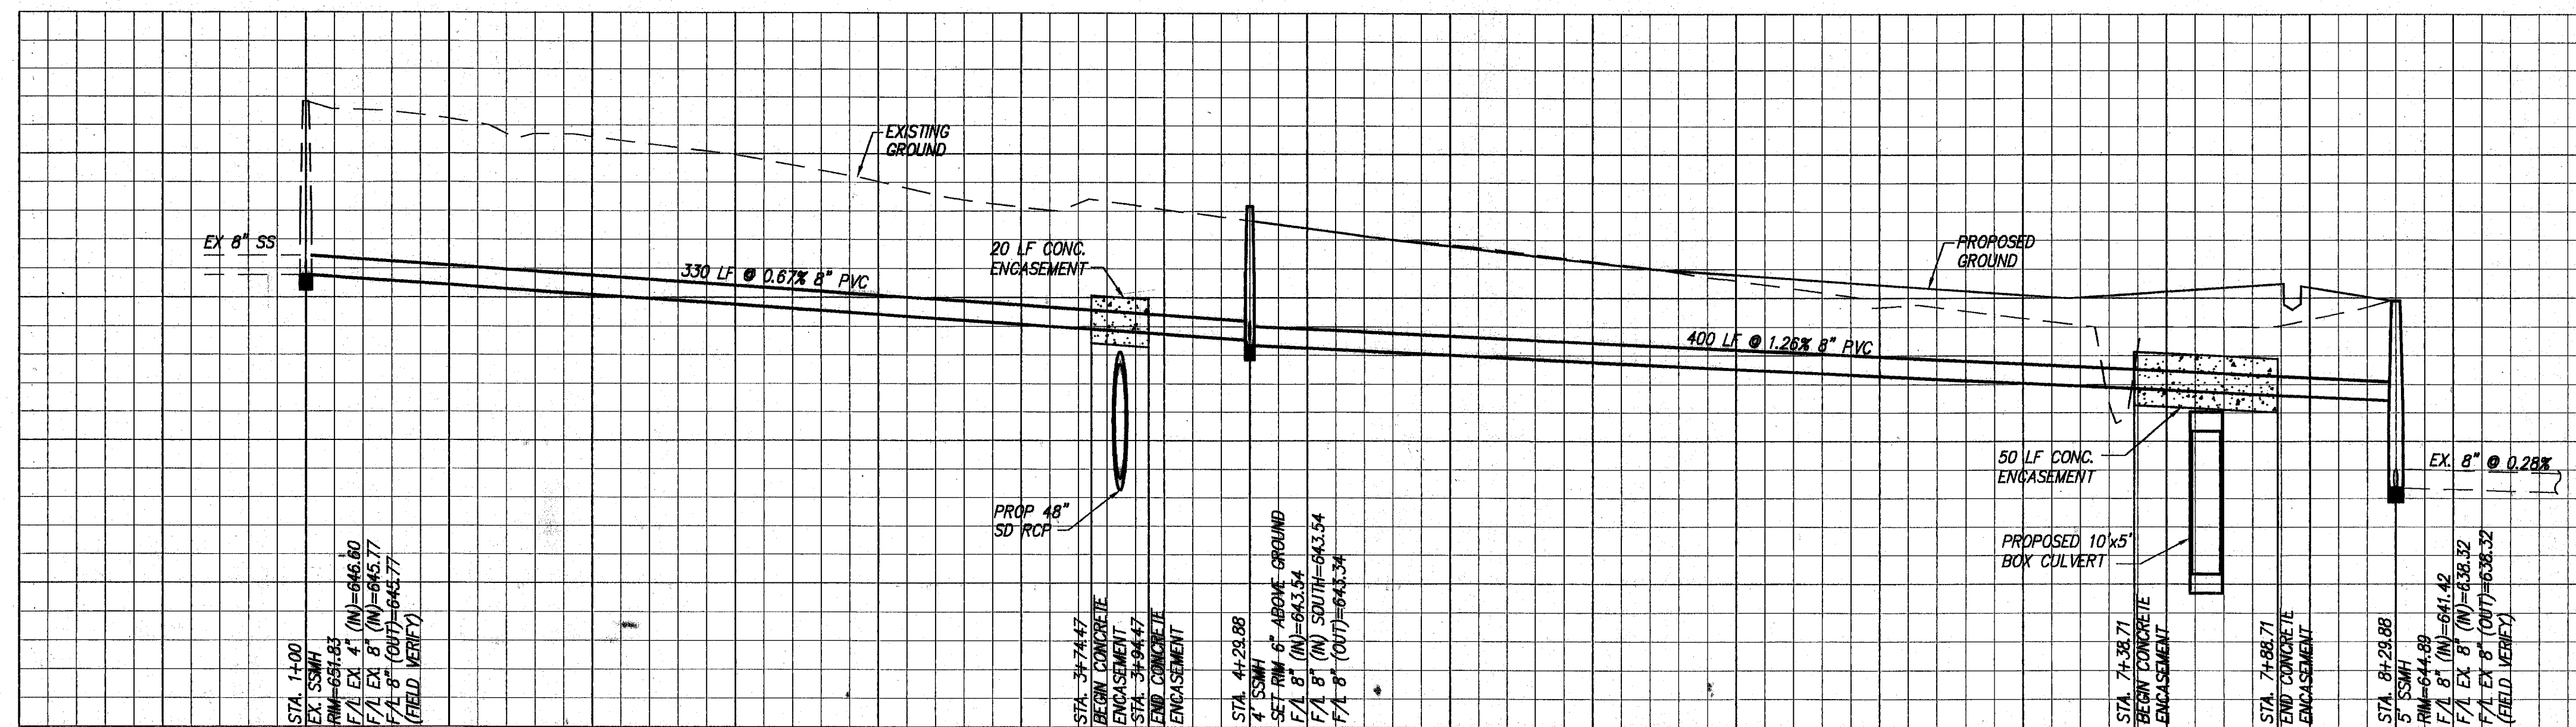

SANITARY SEWER PROFILE - LINE C
SCALE: 1"=40' HORIZ.
1"=4' VERT.

RECORD DRAWING
DRAWN BY THE CONTRACTOR
DATE: 3-5-00 TOR: THH

THE SEAL, SIGNATURE ON THIS DOCUMENT
SHALL BE VALID AND AUTHORITY OF
ENGINEER. REGISTRATION NO. 83282
TEXAS REGISTRATION NO. 83282
DATE: OCT. 6, 1999

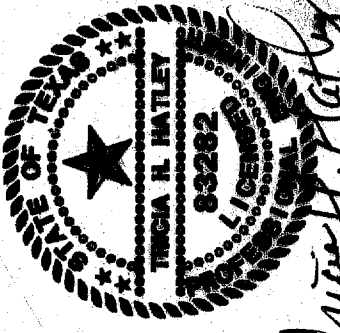

OMNIPLAN ARCHITECTS
SOJOURN OFFICE CENTER
ADDISON, TEXAS

SITWORK PLANS
MISCELLANEOUS DETAILS & SEWER PROFILES

NO. REVISION	DATE	BY	PER CONTRACTOR RFI "1" AND "2"	FILE	DATE	DESIGNED	DRAWN	REVISION	CHECKED
1	4/20/09	MW		206DET-MISC	7-26-99	MJM	GAH		THH
2	5/3/09	MW	REVISED PER RASING-11 FOOT						
3	7/29/09	GC	REVISED PER CITY COMMENTS						

VERIFY SCALE
0 1 2
Bar is one inch on original drawing. If not one inch on this sheet, adjust scale.

SHEET C-13
SEP. 16 OF 16

"AS-BUILTS"