


RECORD DRAWING
 BASED ON THE INFORMATION
 SUPPLIED BY THE CONTRACTOR
 DATE: 3-5-00 TD: THH

THE SEAL APPROVES OF THIS DOCUMENT
 ENGINEER: TRICIA H. HATLEY
 TEXAS REGISTRATION NO: 63282
 DATE: OCT. 6, 1999

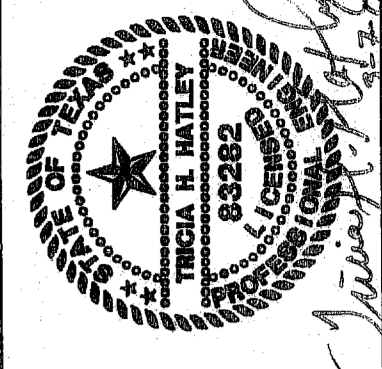

OMNIPLAN ARCHITECTS
SOJOURN OFFICE CENTER
 ADDISON, TEXAS

SITWORK PLANS
ONSITE DRAINAGE AREA MAP

FREESSE • NICHOLS
 1341 W. MacArthur Lane-Suite 230-E
 Dallas, Texas 75247
 214-920-2500

LEGEND

- DRAINAGE AREA BOUNDARY
- DESIGN POINT
- DRAINAGE AREA NUMBER/ACREAGE
- DIRECTION OF RUNOFF
- EXISTING CONTOURS
- PROPOSED CONTOURS

NOTES

1. DRAINAGE CALCULATIONS HAVE BEEN BASED ON CITY OF CARROLLTON STORM DRAINAGE DESIGN MANUAL.
2. REFER TO SHEET C-6, C-7 AND C-8 FOR SD PLAN AND PROFILES

SYSTEM DRAINAGE CALCULATIONS										
Design Point	Drainage Area	RFB (acres)	Runoff Coef.	Inc. OA (acres)	Accum. CA (acres)	Storm Frequency (min)	To Intensity (in/hr)	Flow (cfs)	Comments	
SD LINE A										
OA1	OA1	24.00	0.83	20.02	20.02	100	12.50	8.17	184.87	NORTH CONDOS, ATHLETIC CENTER, AND SOJOURN
A1	CA1+OA1	0.93	1.00	0.93	20.95	100	12.82	8.14	171.86	GRATE INLET
OA2-B	OA2+OA3+OA1	3.00	1.00	3.00	23.95	100	13.01	8.04	184.09	OFFSITE WYE INLET
A2	CA2+OA4+OA2-B	6.68	1.00	6.68	29.63	100	13.67	7.87	234.77	CURB INLET + OFFSITE WYE INLET
A3	CA3+OA5+OA2	1.52	1.00	1.52	31.15	100	14.02	7.77	243.84	CURB INLET + OFFSITE SHEET FLOW
A4	CA4+A3	0.49	1.00	0.49	31.62	100	14.14	7.74	246.85	CURB INLET
A6	CA5+OA6+OA7a+OA7b+OA8+A4	11.21	1.00	11.21	42.83	100	14.90	7.54	325.74	CURB INLET + AIRBORN DRIVE + FUTURE DEVELOPMENT
A7	A6	0.00	1.00	0.00	42.83	100	15.81	7.42	320.51	OUTLET TO DETENTION POND
SD LINE B										
CB1	B1	1.17	1.00	1.17	1.00	100	0.93	8.82	10.40	CURB INLET
B2	B2 + B1	1.36	1.00	1.36	2.53	100	10.97	8.59	21.92	CURB INLET
B3	B2	0.00	1.00	0.00	2.53	100	11.88	8.34	21.10	OUTLET TO DETENTION POND

On-Site Inlet Calculations								
Area Designation	Design Point	Area (acres)	Tc (min)	Cp	CpCA (acres)	I ₁₀₀ (in/hr)	Q ₁₀₀ (cfs)	Comments
SD Line A								
A1	CA1	0.93	10	1.00	0.93	8.82	8.27	GRATE INLET
A2	CA2	1.56	10	1.00	1.56	8.82	13.87	CURB INLET
A3	CA3	1.52	10	1.00	1.52	8.82	13.81	CURB INLET
A4	CA4	0.49	10	1.00	0.49	8.82	4.38	CURB INLET
A5	CA5	1.81	10	1.00	1.81	8.82	14.31	CURB INLET
SD Line B								
B1	CB1	1.17	10	1.00	1.17	8.82	10.40	CURB INLET
B2	CB2	1.36	10	1.00	1.36	8.82	12.09	CURB INLET
Sheet-Flow to Pond								
C	C	1.27	10	1.00	1.27	8.82	11.20	FLUME TO POND
Flow to Sojourn Drive								
D	OA1	0.01	10	1.00	0.01	8.82	0.09	FLOW TO SOJOURN DR.
E	OA1	0.04	10	1.00	0.04	8.82	0.35	FLOW TO SOJOURN DR.

NO. REVISION	DATE	BY	DESIGNED	DRAWN	CHECKED
1	4/25/99	MW	MW	MW	THH
2	6/3/99	MW			

PER CONTRACTOR SET "1" AND "2"
 REVISIONS PER RASING FT 1 FOOT

VERIFY SCALE
 Bar is one inch on original drawing. If not one inch on this sheet, adjust scale.

SEQ. **C-5**
 8 OF 16

"AS-BUILTS"