

SNK DEVELOPMENT INC.


CONSTRUCTION PLANS FOR MIXED USE DEVELOPMENT

TOWN OF ADDISON

PW#: 2006-002

SHEET NO. DESCRIPTION

- 1 GENERAL NOTES & DETAILS
- 2-3 FINAL PLAN
- 4 DIMENSIONAL CONTROL
- 5 EROSION CONTROL PLAN
- 6 DRAINAGE AREA MAP & CALCULATIONS
- 7 STORM SEWER PLAN
- 7A STORM SEWER PROFILES
- 8 WATER & SANITARY SEWER PLAN
- 9 12" WATER & SANITARY SEWER PROFILES
- 10 PAVING & GRADING PLAN
- 11 PAVING PLAN/PROFILE

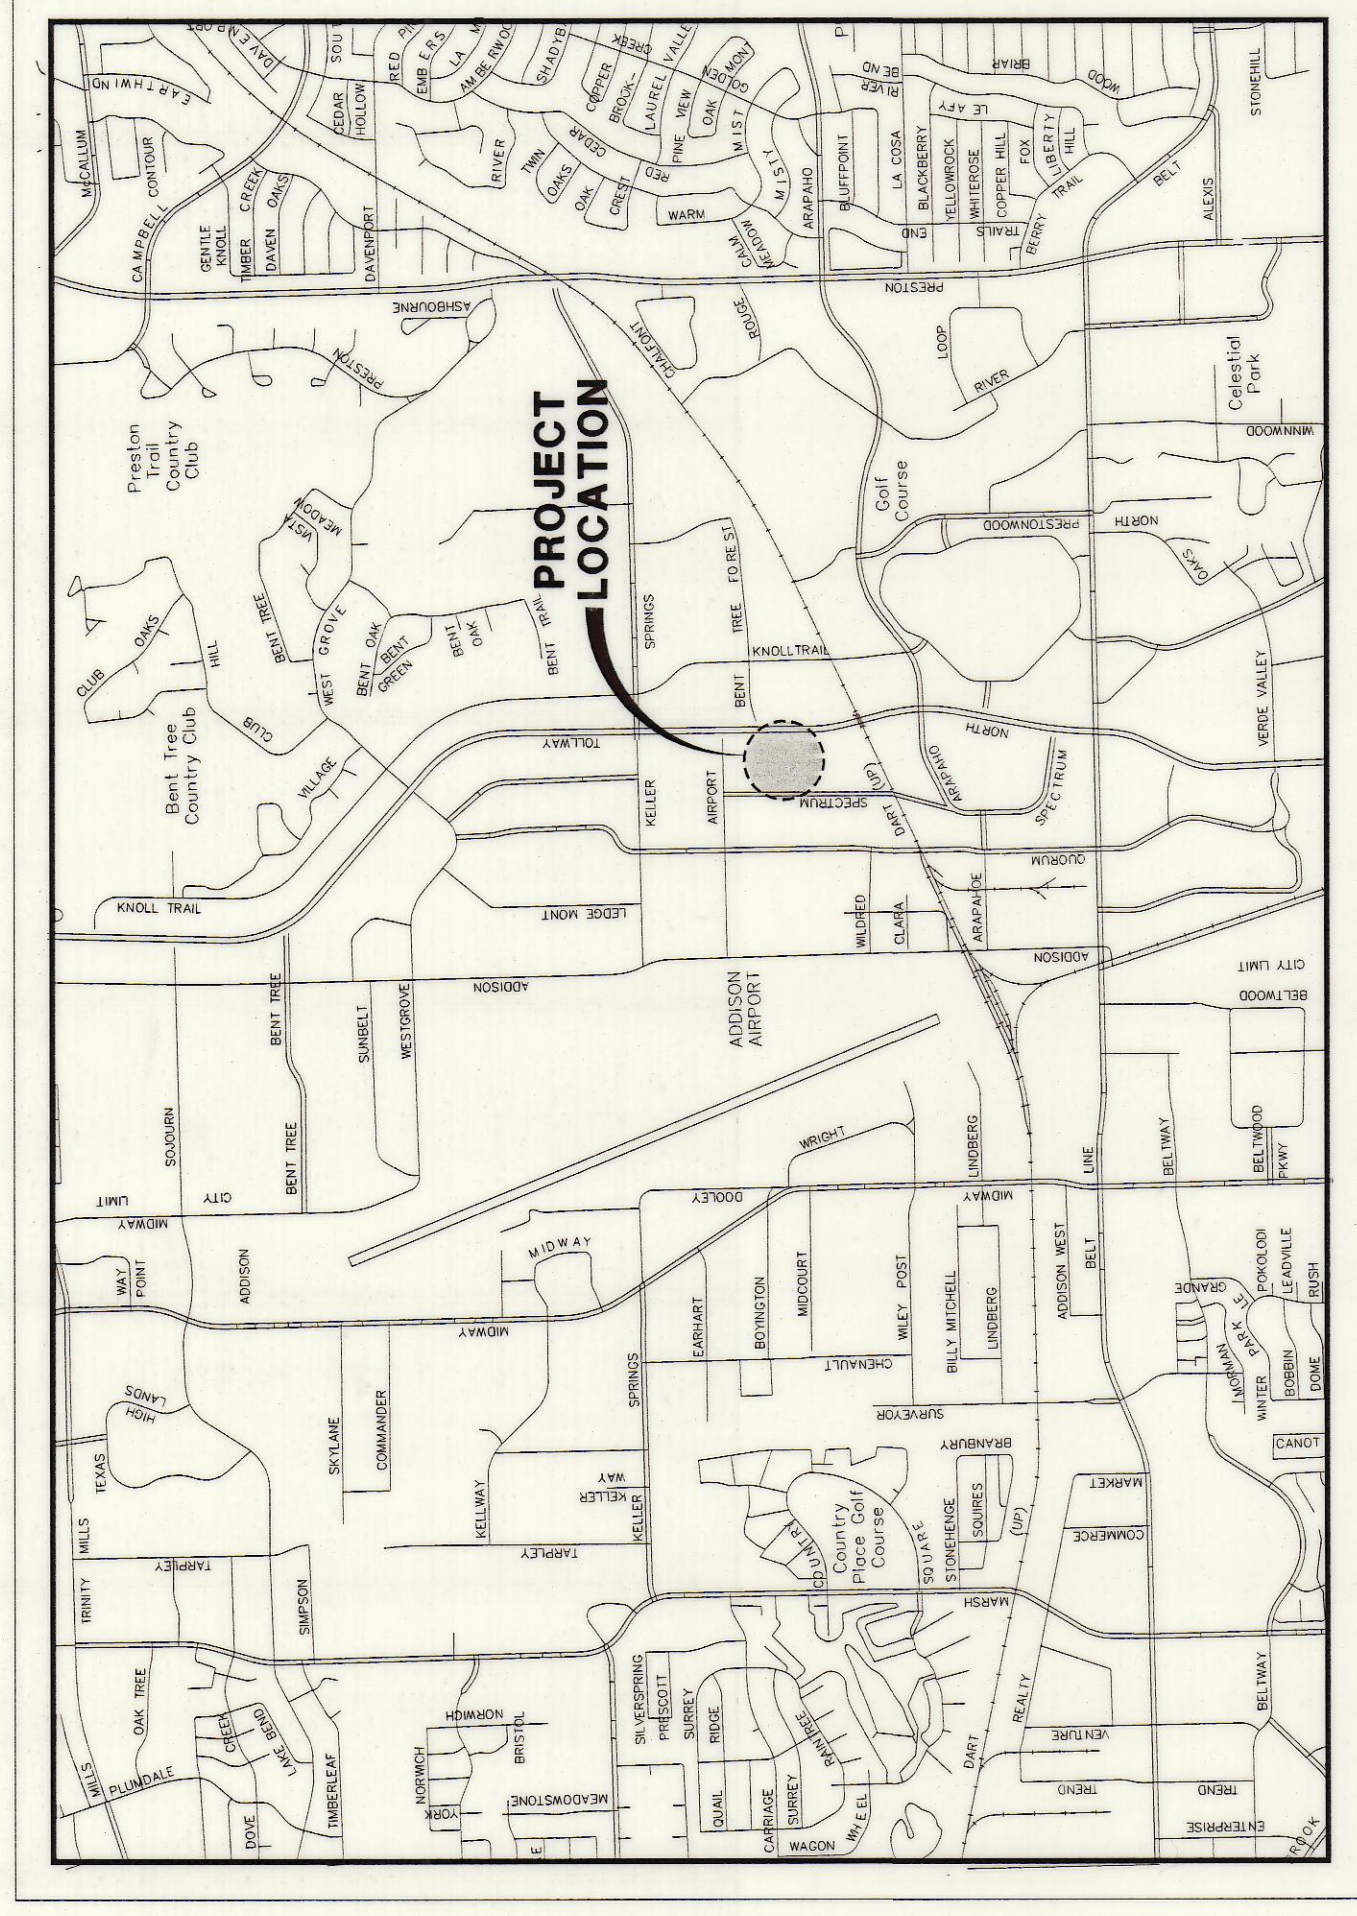

RECORD DRAWING
BASED ON CONTRACTOR MARKUPS
NOT FIELD SURVEY

OWNER & APPLICANT:

SNK DEVELOPMENT INC.
2522 MCKINNEY AVENUE
SUITE 201
DALLAS, TX. 75201
(214) 550-8005

ENGINEER:

g&a Grantham & Associates
Civil Engineering
1919 S. SHILOH ROAD
SUITE 440, L.B. 8
GARLAND, TEXAS 75042

GRANTHAM & ASSOCIATES
F-005438



IF SEEN AND SIGNING ON THIS DOCUMENT WAS DRAWING BY: BRUCE R. GRANTHAM ON 11/10/09 ALTERATION OF A SEALED DOCUMENT WITHOUT PROPER PERMISSION IS UNLAWFUL. NO ENGINEER IS AN OFFENSE UNDER THE TEXAS ENGINEERING PRACTICE ACT.

LOCATION MAP

G&A JOB NO. 1057-06

APRIL 2007

MIXED USE DEVELOPMENT

FF-7