

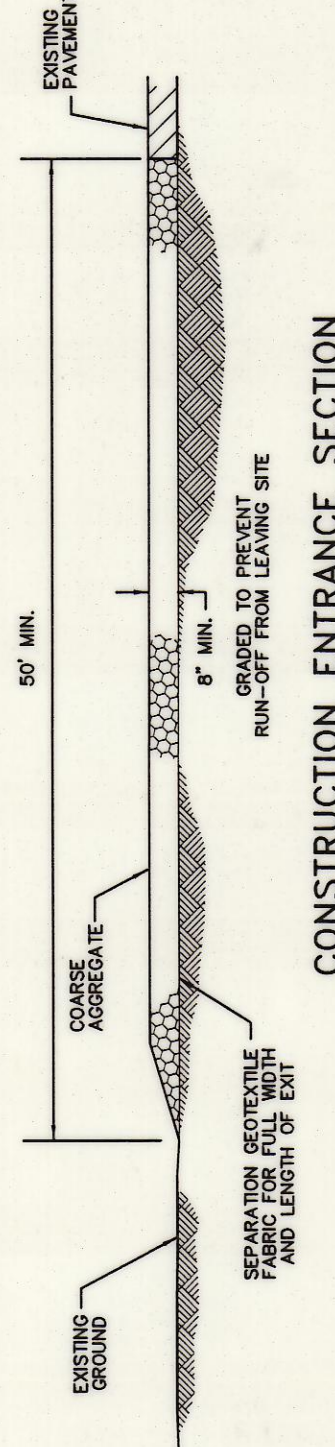


NO.	DATE	REVISION	APPROV.
1			
2			
3			

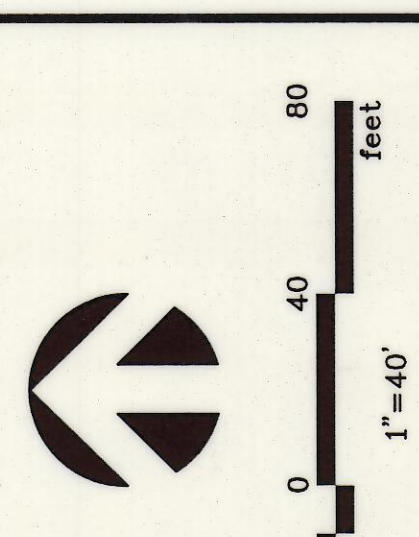


CONSTRUCTION ENTRANCE SECTION

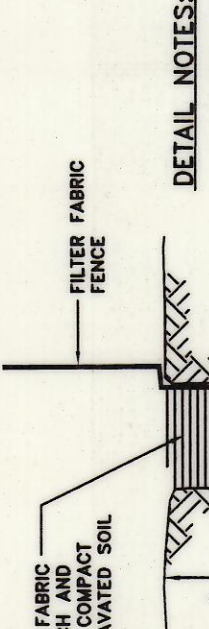

DETAIL "A"


- DETAIL NOTES:**
1. IF FACTORY PREASSEMBLED FENCE WITH SUPPORT NETTING IS USED, SPACING OF POSTS MAY INCREASE TO 6' MAXIMUM.
  2. FILTER FABRIC SHALL BE AS PER ASTM D4832.
  3. WHEN TWO SECTIONS OF FILTER FABRIC ADJOIN EACH OTHER, PROVIDE 6" OF OVERLAP AT THE JOINT AND FOLD.

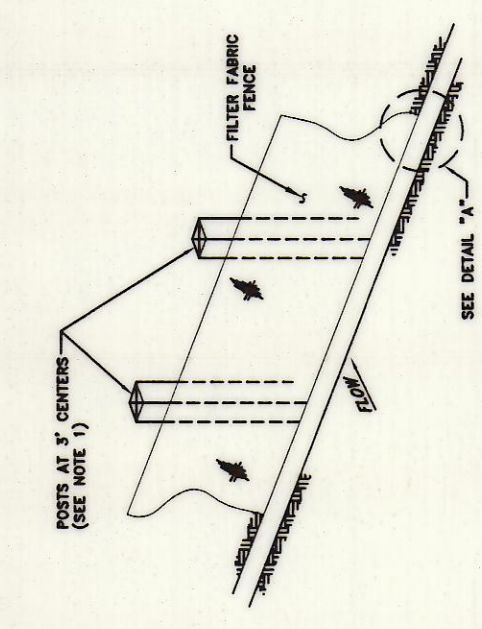

FILTER FABRIC FENCE

**GENERAL NOTES:**

1. EROSION CONTROL DEVICES AS SHOWN ON THE EROSION CONTROL PLAN FOR THE PROJECT SHALL BE INSTALLED PRIOR TO THE START OF LAND DISTURBING ACTIVITIES ON THE PROJECT.
2. ALL EROSION CONTROL DEVICES ARE TO BE INSTALLED IN ACCORDANCE WITH THE APPROVED PLANS AND SPECIFICATIONS AND SHALL BE MAINTAINED THROUGHOUT CONSTRUCTION BY THE DESIGN ENGINEER AND THE TOWN OF ADDISON ENGINEERING DIVISION.
3. IF THE EROSION CONTROL PLANS AS APPROVED CANNOT CONTROL EROSION AND OFF-SITE SEDIMENTATION FROM THE PROJECT THE EROSION CONTROL PLAN WILL BE REQUIRED TO BE REVISED AND/OR ADDITIONAL EROSION CONTROL DEVICES WILL BE REQUIRED ON SITE.
4. IF OFF-SITE SOIL BORROW OR SPOIL SITES ARE USED IN CONJUNCTION WITH THIS PROJECT, THIS INFORMATION SHALL BE DISCLOSED AND SHOWN ON THE EROSION CONTROL PLAN. OFF-SITE BORROW AND SPOIL AREAS ARE CONSIDERED A PART OF THE PROJECT SITE AND THEREFORE SHALL COMPLY WITH THE EROSION CONTROL PLAN. EROSION CONTROL DEVICES SHALL BE STABILIZED WITH PERMANENT GROUND COVER PRIOR TO FINAL APPROVAL OF THE PROJECT.
5. CONTRACTOR TO PREPARE AND IMPLEMENT SWPPP. CONSTRUCTION SITE NOTICE, NOTICE OF INTENT, NOTICE OF TERMINATION, ETC. AS REQUIRED BY TCEQ.

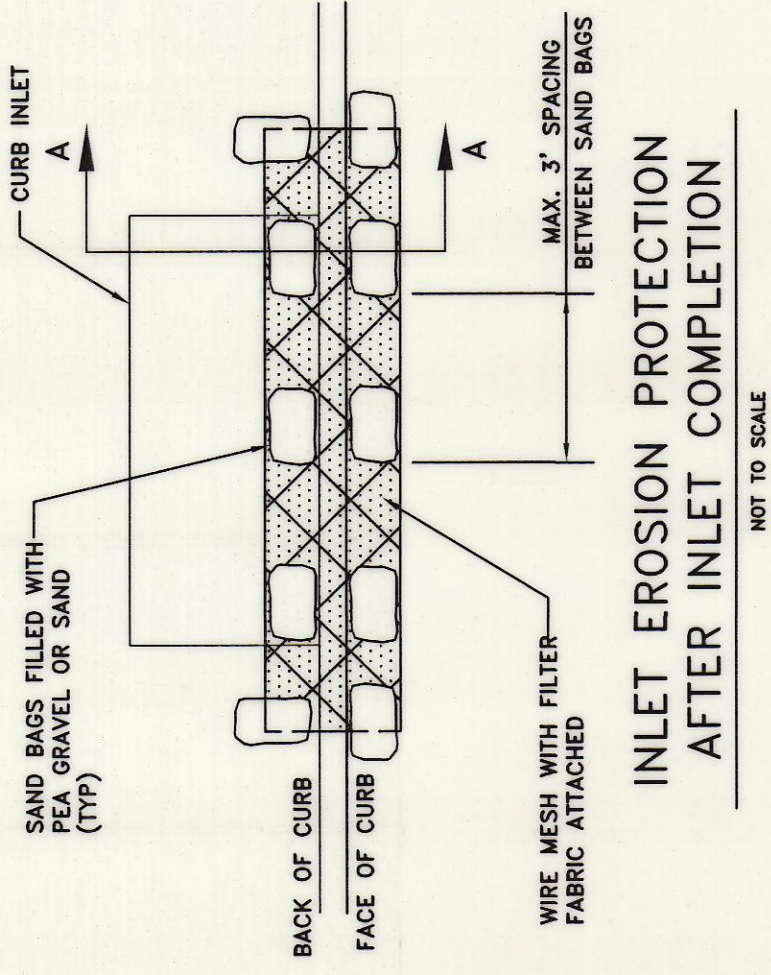


INLET EROSION PROTECTION AFTER INLET COMPLETION

**INLET PROTECTION NOTES:**

1. WIRE MESH PER ASTM D4832 W/OPENING NOT TO EXCEED 1".
2. FILTER FABRIC SHALL BE AS PER ASTM D4832. FILTER FABRIC TO BE SECURED TO WIRE MESH WITH WIRE OR PLASTIC CABLE TIES.
3. SAND BAGS SHALL BE POLYETHYLENE OR COTTON BURLAP FABRIC FILLED WITH PEA GRAVEL OR COARSE GRADE SAND TO APPROXIMATELY 40 POUNDS.

**LEGEND**

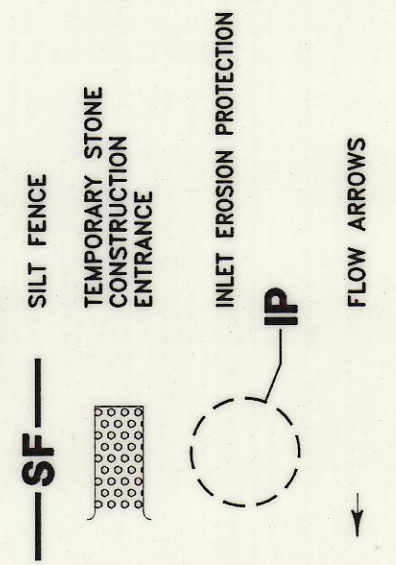

**RECORD DRAWING**  
 BASED ON CONTRACTOR MARKUPS  
 NOT FIELD SURVEY

DATE: FEBRUARY 2009	SCALE: 1"=40'	JOB NO.: 1057-06
DRAWN: G&A DESIGN	BRG REVIEWED: BRG	DWG: 1057EROSION
<b>MIXED USE DEVELOPMENT</b> <b>TOWN OF ADDISON</b> <b>EROSION CONTROL PLAN</b>		




**SNK DEVELOPMENT INC.**

**g&a** Grantham & Associates  
 Civil Engineering

SHT. 5  
 OF 11

1919 S. SHILOH ROAD, SUITE 440, LB. 8  
 GARLAND, TEXAS 75042  
 (972) 864-2333 (TEL)  
 (972) 864-2334 (FAX)

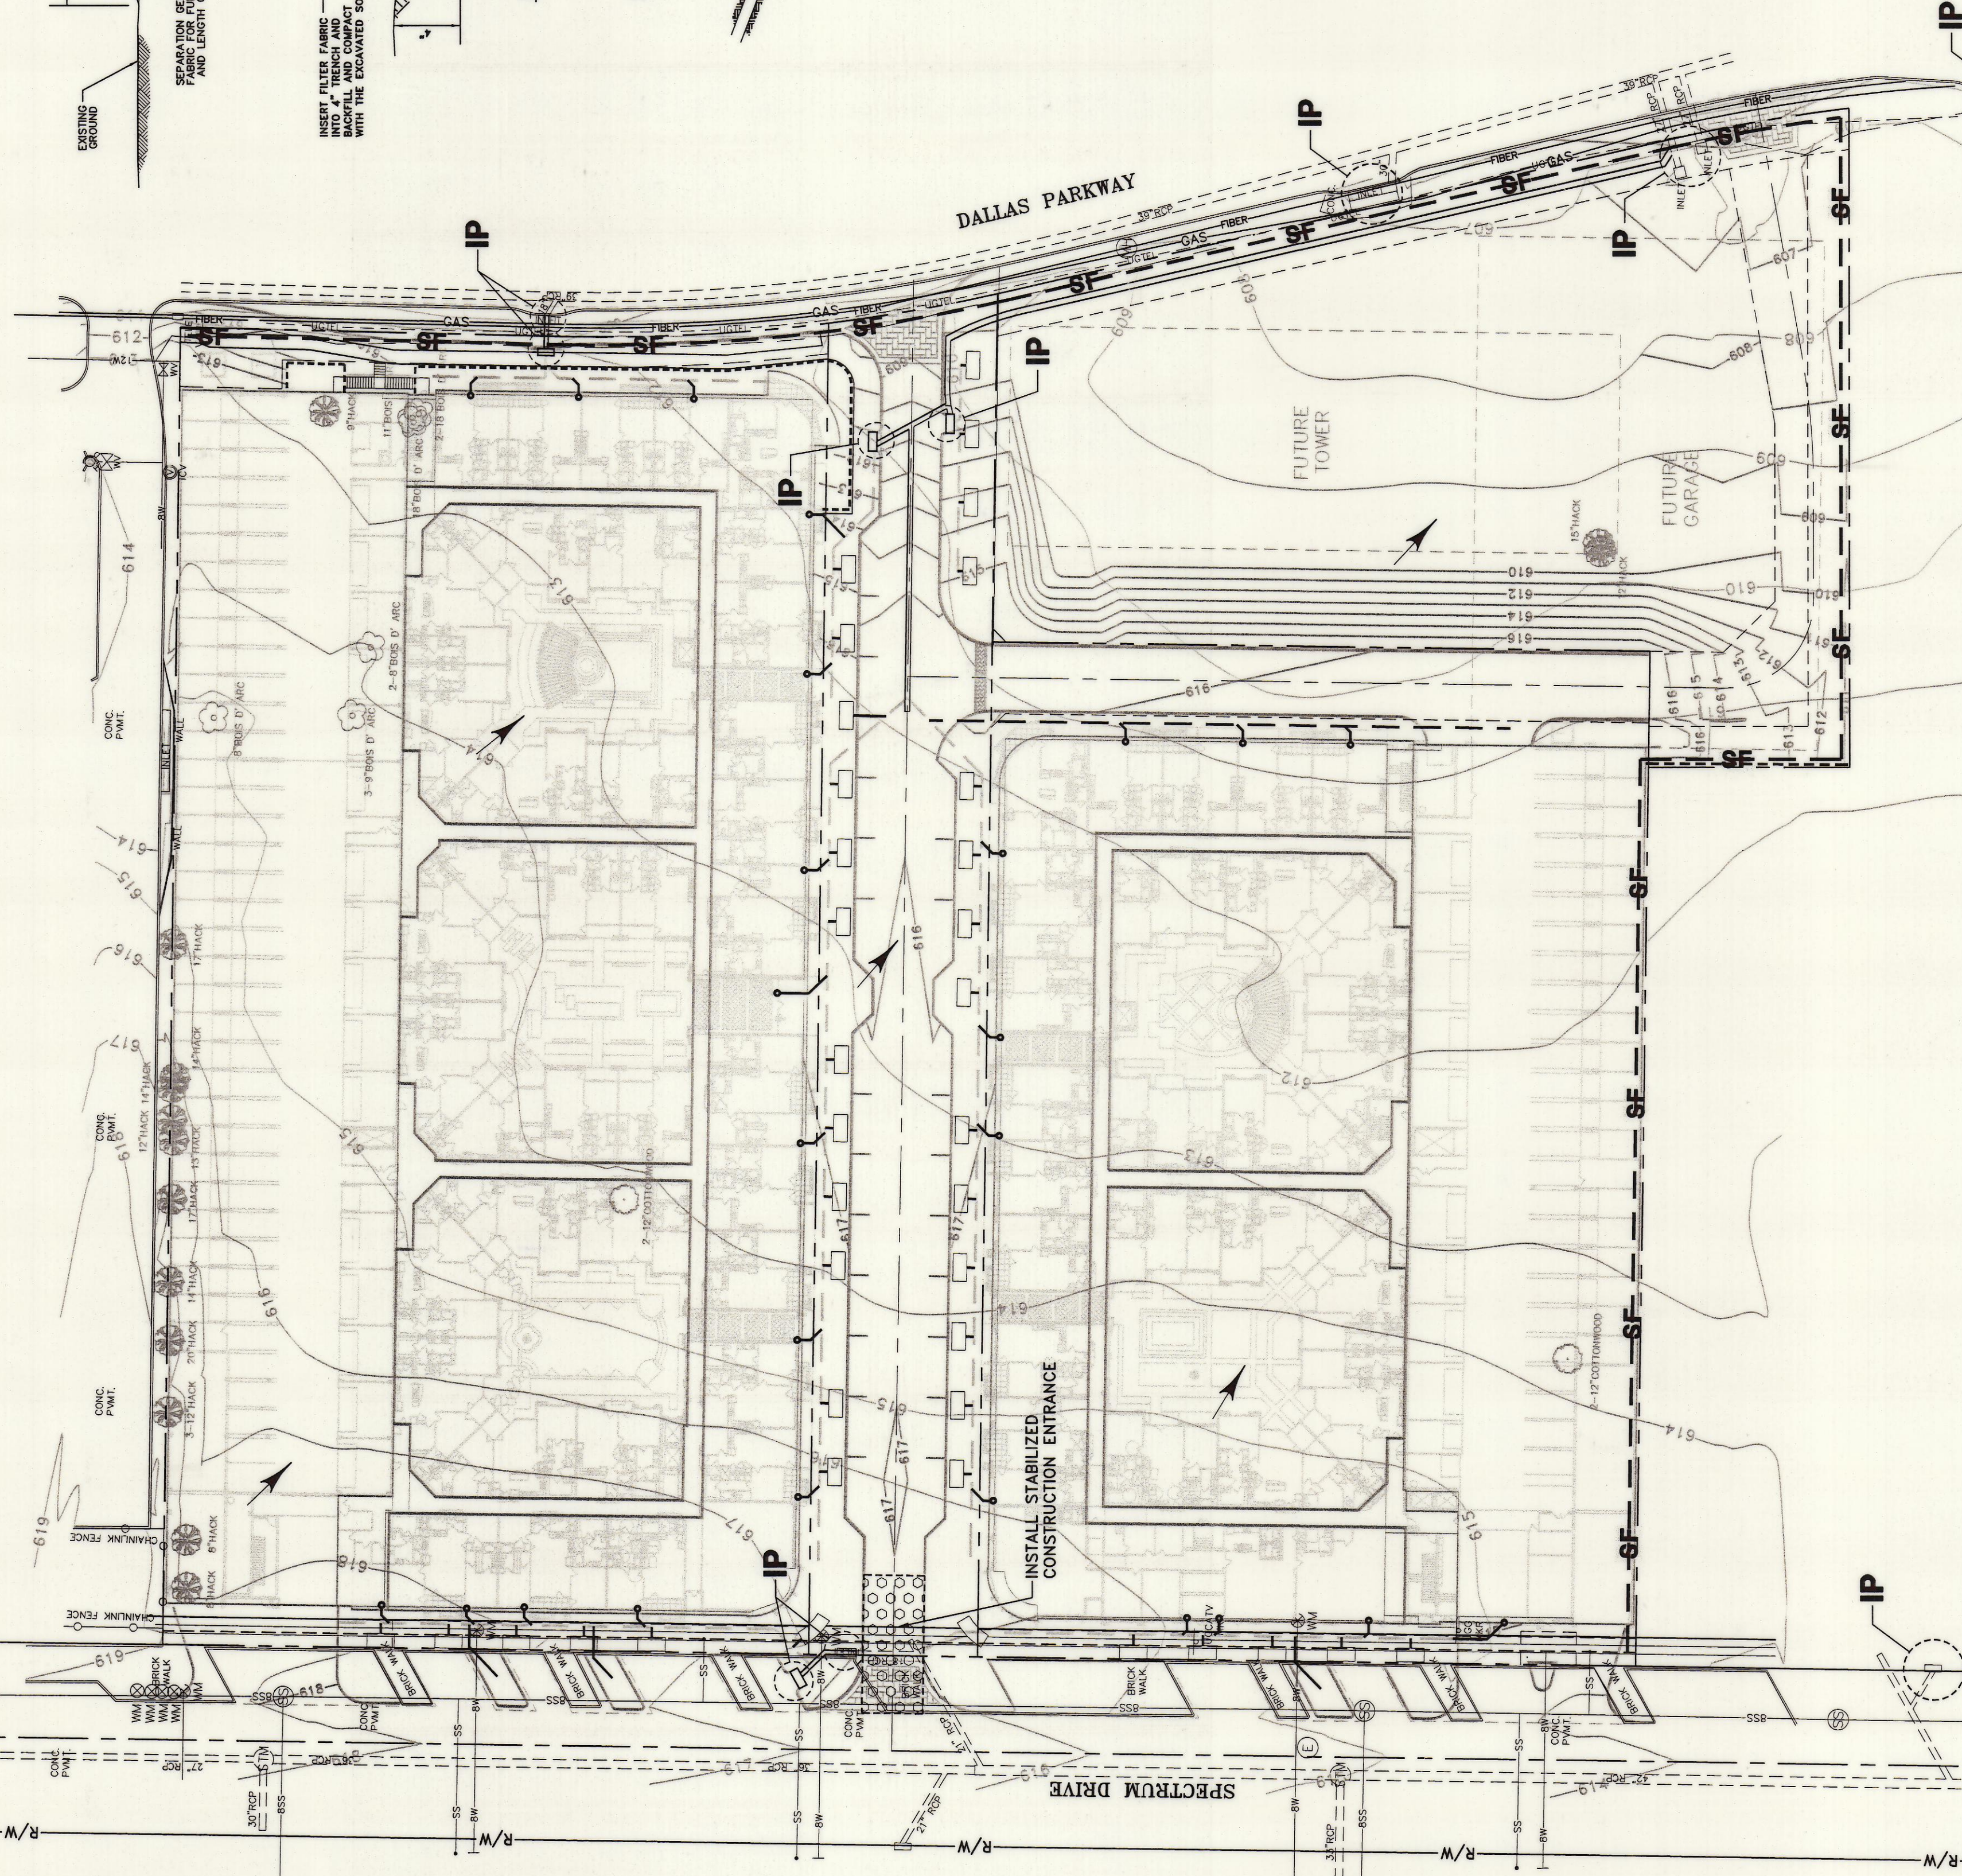

THE SEAL APPEARING ON THIS DOCUMENT WAS AUTHORIZED BY: BRUCE R. GRANTHAM ON 11/10/09. ALL INFORMATION IS UNLESS NOTED OTHERWISE, IS AN OFFENSE UNDER PRACTICE ACT.