


# SNK DEVELOPMENT INC.

## CONSTRUCTION PLANS FOR MIXED USE DEVELOPMENT

### TOWN OF ADDISON

PW#: 2006-002

SHEET NO.	DESCRIPTION
1	GENERAL NOTES & DETAILS
2-3	FINAL PLAT
4	DIMENSIONAL CONTROL
5	EROSION CONTROL PLAN
6	DRAINAGE AREA MAP & CALCULATIONS
7	STORM SEWER PLAN
7A	STORM SEWER PROFILES
8	WATER & SANITARY SEWER PLAN
9	12" WATER & SANITARY SEWER PROFILES
10	PAVING & GRADING PLAN
11	PAVING PLAN/PROFILE

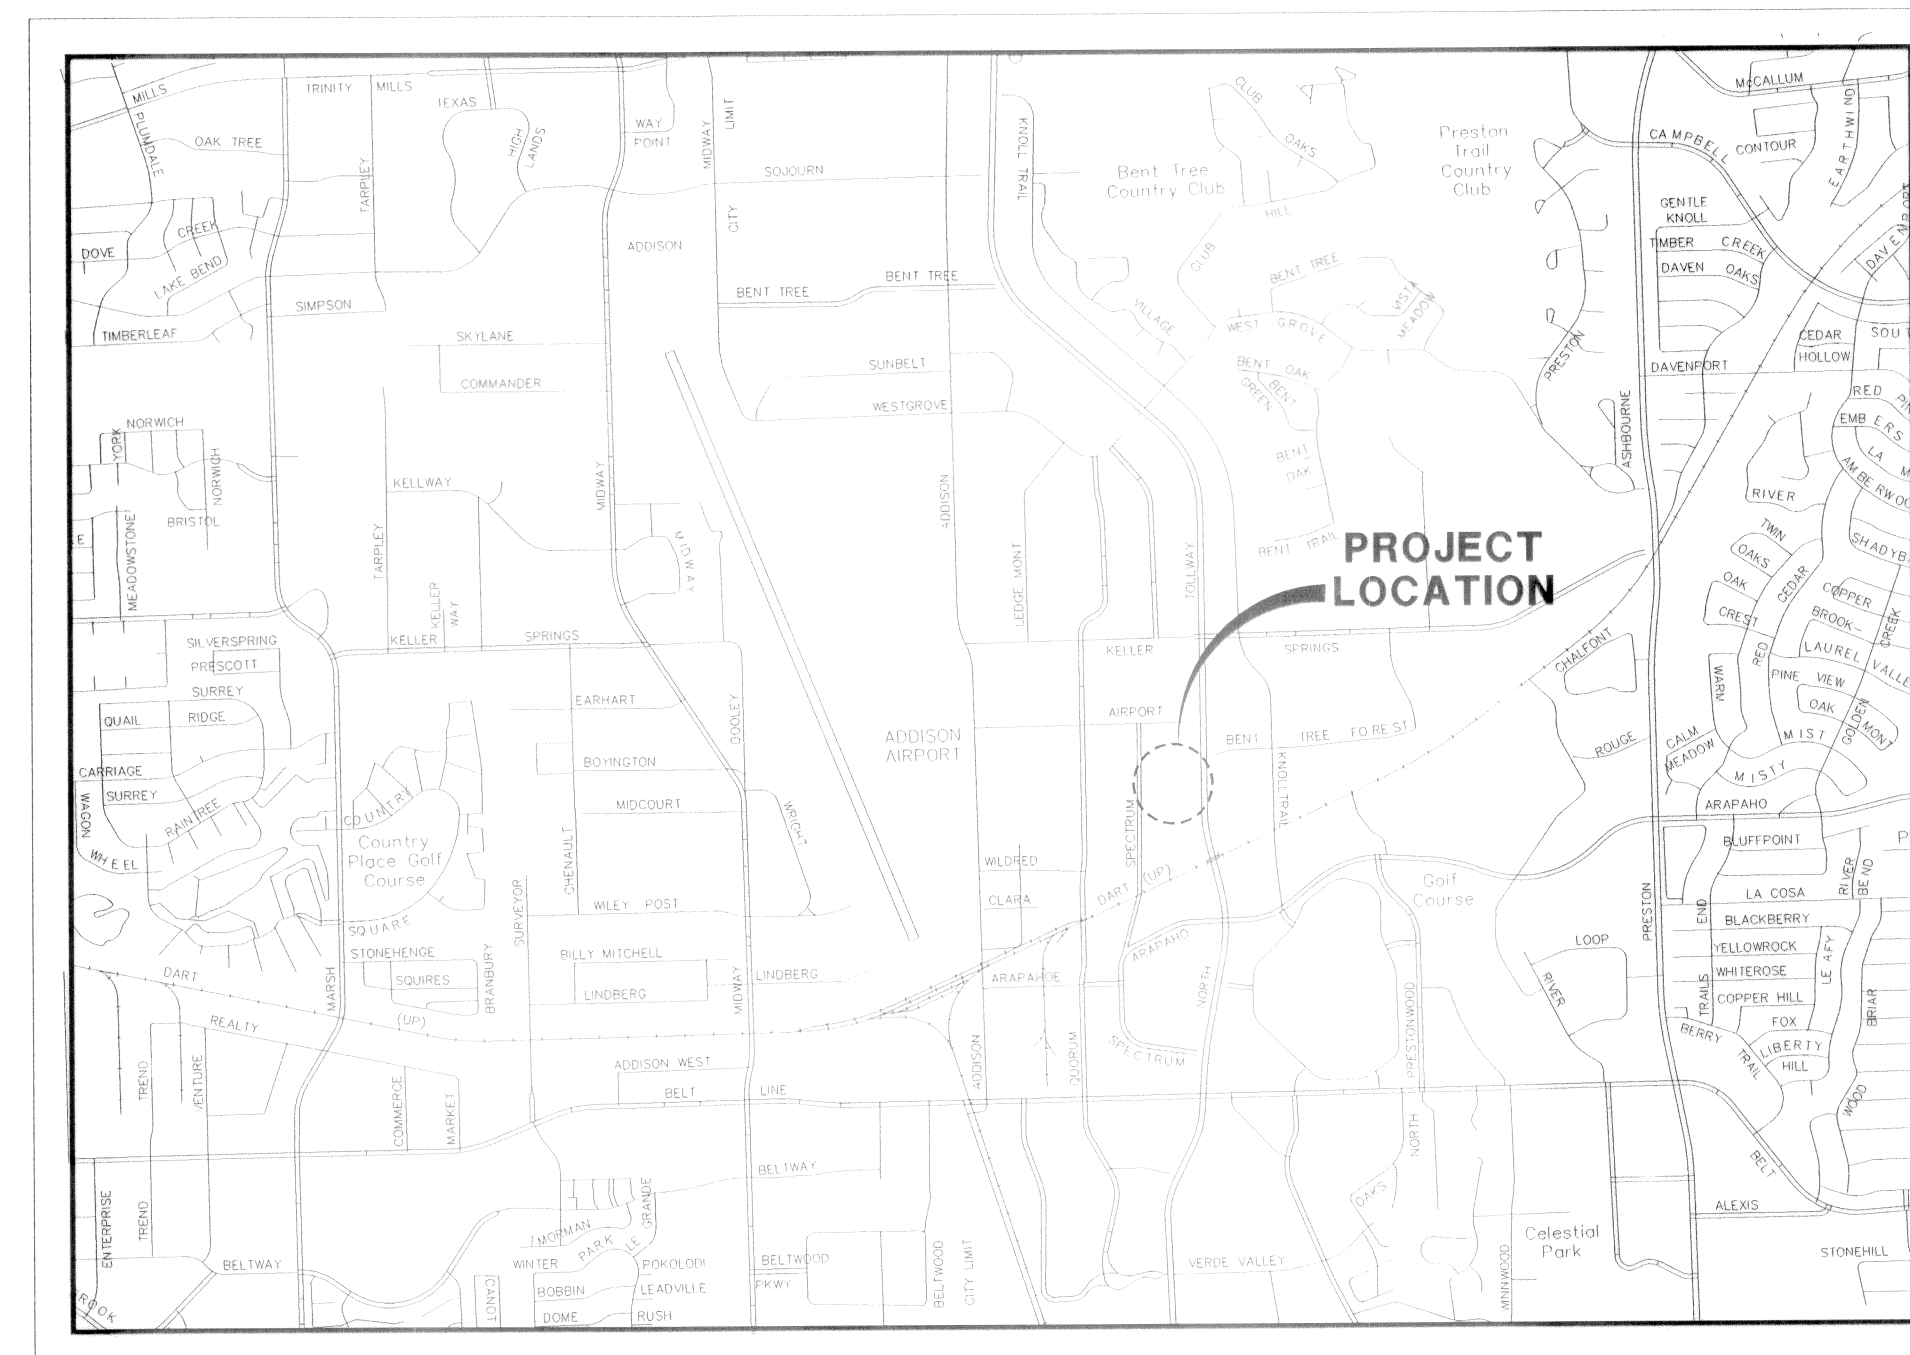

LOCATION MAP

G&A JOB NO. 1057-06

APRIL 2007

**RECORD DRAWING**  
BASED ON CONTRACTOR MARKUPS  
NOT FIELD SURVEY



THE SEAL APPEARING ON THIS DOCUMENT WAS AUTHORIZED BY: BRUCE R. GRANTHAM ON 11/10/09 ALTERATION OF A SEALED DOCUMENT WITHOUT PROPER NOTIFICATION TO THE RESPONSIBLE ENGINEER IS AN OFFENSE UNDER THE TEXAS ENGINEERING PRACTICE ACT.

**OWNER & APPLICANT:**

SNK DEVELOPMENT INC.  
2522 MCKINNEY AVENUE  
SUITE 201  
DALLAS, TX. 75201  
(214) 550-8005

**ENGINEER:**

**g&a** Grantham & Associates  
Civil Engineering

1919 S. SHILOH ROAD  
SUITE 440, L.B. 8  
GARLAND, TEXAS 75042