

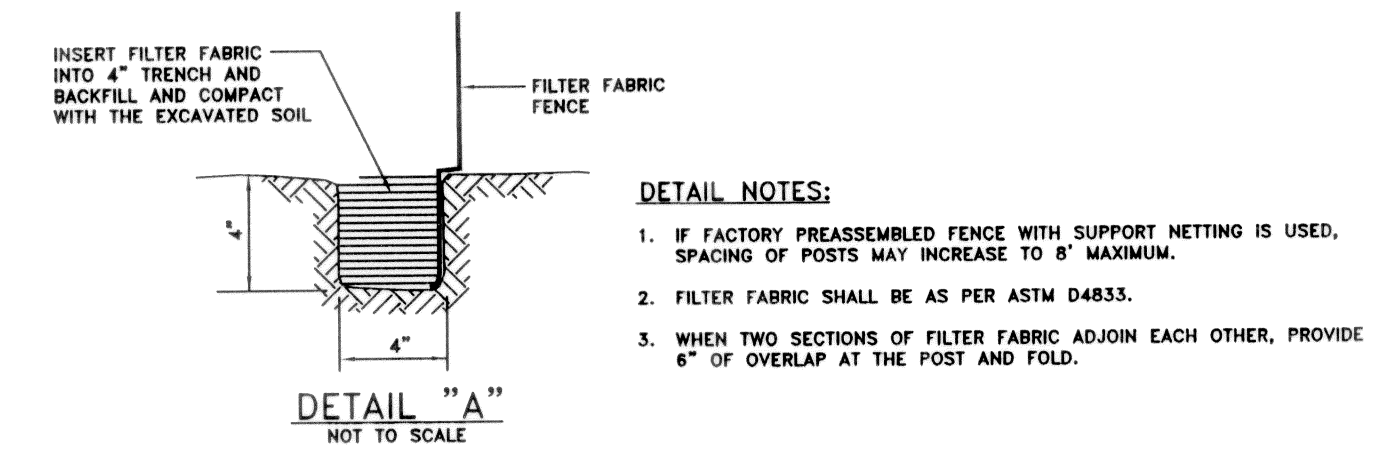
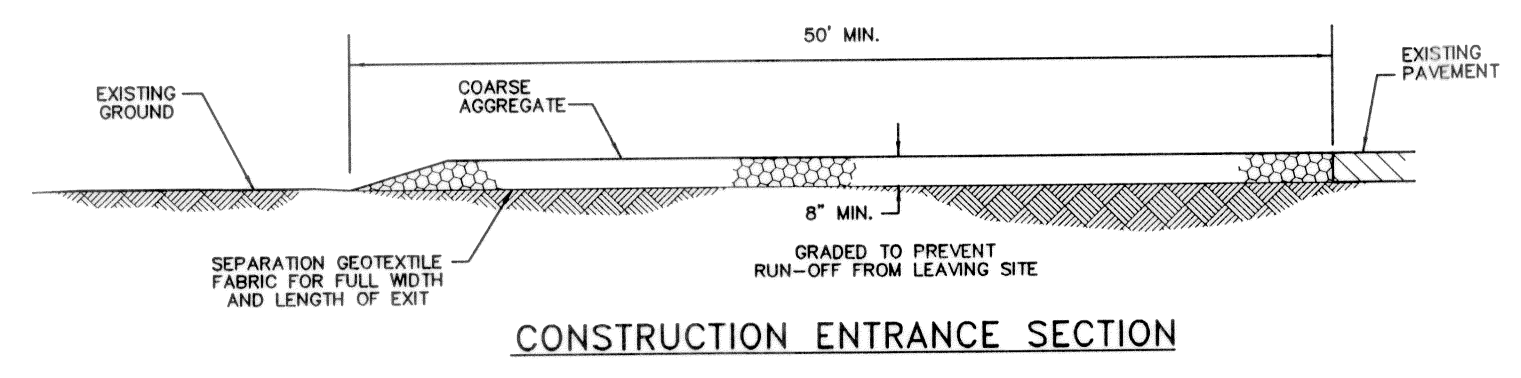
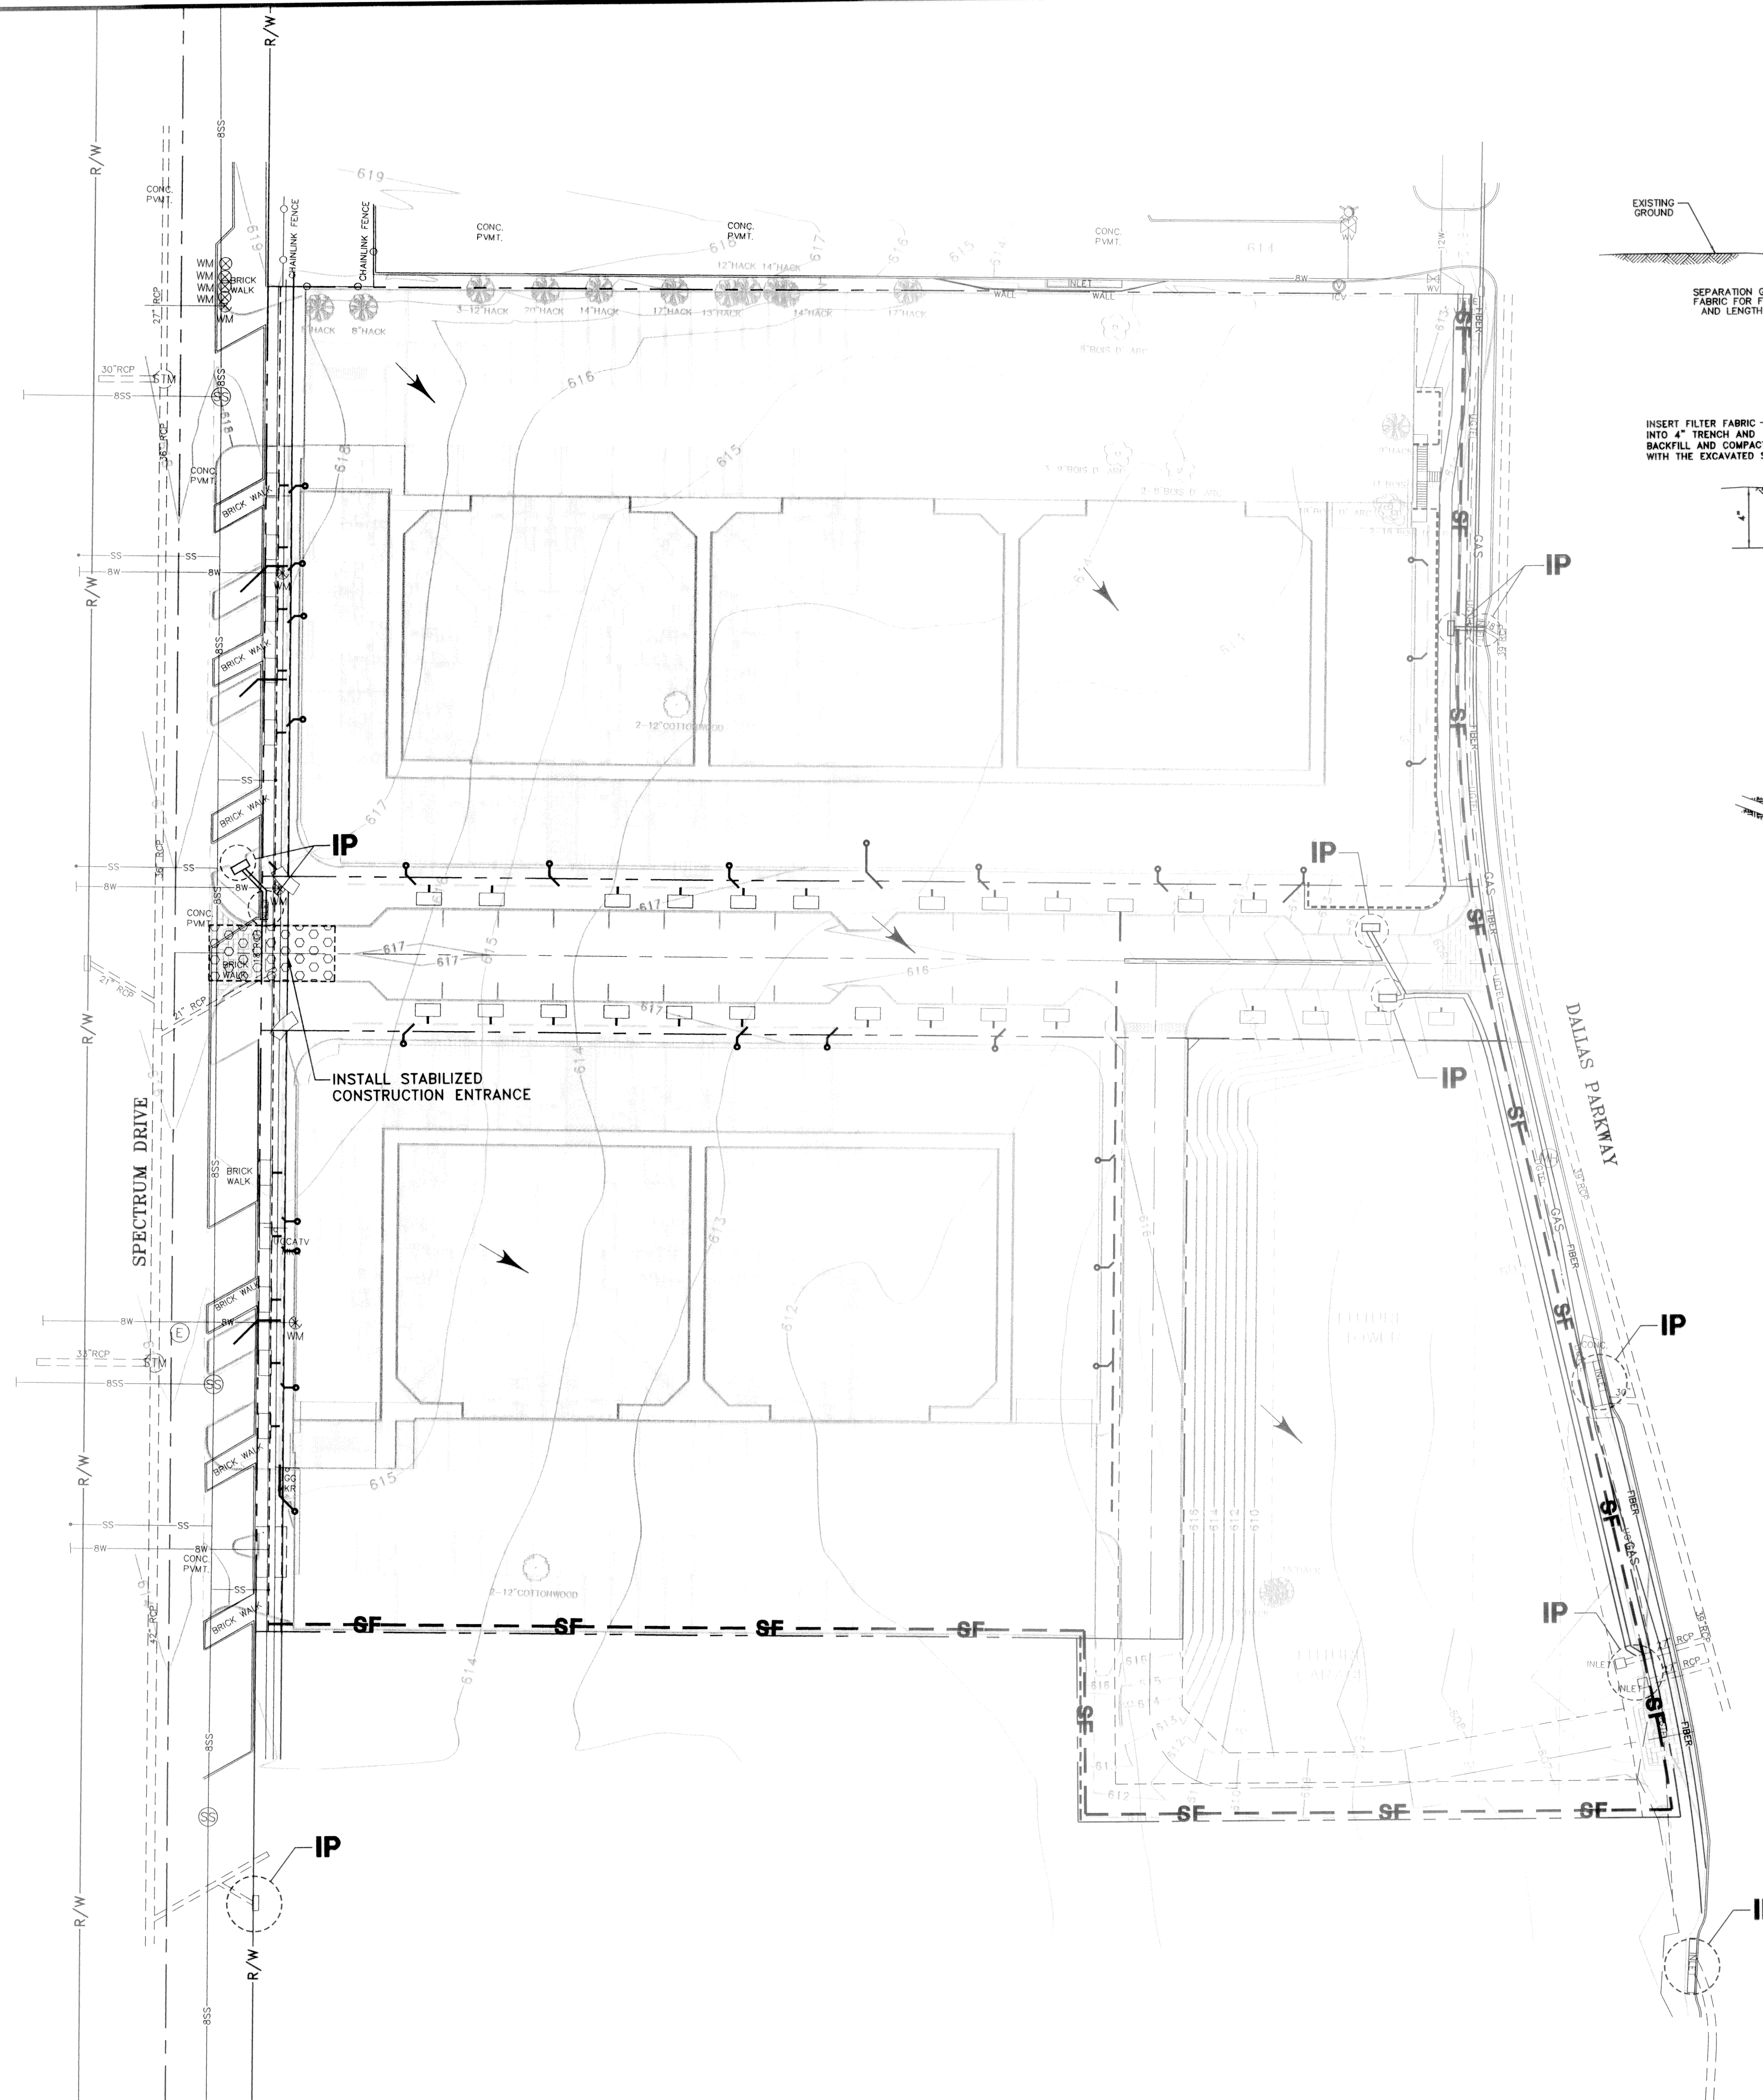


NO.	DATE	REVISION	APPROV.
1			
2			
3			


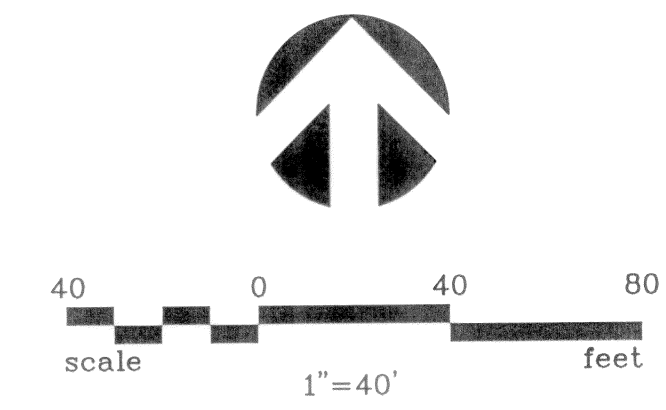


- DETAIL NOTES:**
- IF FACTORY PREASSEMBLED FENCE WITH SUPPORT NETTING IS USED, SPACING OF POSTS MAY INCREASE TO 8' MAXIMUM.
  - FILTER FABRIC SHALL BE AS PER ASTM D4833.
  - WHEN TWO SECTIONS OF FILTER FABRIC ADJOIN EACH OTHER, PROVIDE 6" OF OVERLAP AT THE POST AND FOLD.

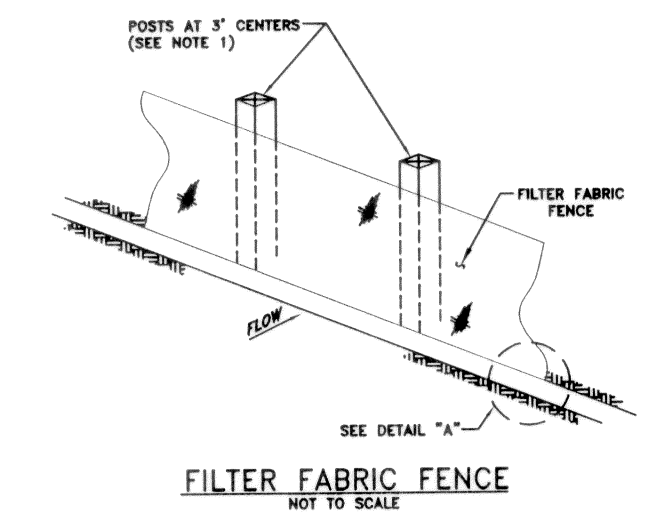

**GENERAL NOTES:**


- EROSION CONTROL DEVICES AS SHOWN ON THE EROSION CONTROL PLAN FOR THE PROJECT SHALL BE INSTALLED PRIOR TO THE START OF LAND DISTURBING ACTIVITIES ON THE PROJECT.
- ALL EROSION CONTROL DEVICES ARE TO BE INSTALLED IN ACCORDANCE WITH THE APPROVED PLANS AND SPECIFICATIONS FOR THE PROJECT. CHANGES ARE TO BE APPROVED BEFORE CONSTRUCTION BY THE DESIGN ENGINEER AND THE TOWN OF ADDISON ENGINEERING DIVISION.
- IF THE EROSION CONTROL PLANS AS APPROVED CANNOT CONTROL EROSION AND OFF-SITE SEDIMENTATION FROM THE PROJECT THE EROSION CONTROL PLAN WILL BE REQUIRED TO BE REVISED AND/OR ADDITIONAL EROSION CONTROL DEVICES WILL BE REQUIRED ON SITE.
- IF OFF-SITE SOIL BORROW OR SPOIL SITES ARE USED IN CONJUNCTION WITH THIS PROJECT, THIS INFORMATION SHALL BE DISCLOSED AND SHOWN ON THE EROSION CONTROL PLAN. OFF-SITE BORROW AND SPOIL AREAS ARE CONSIDERED A PART OF THE PROJECT SITE AND THEREFORE SHALL COMPLY WITH THE TOWN OF ADDISON EROSION CONTROL REQUIREMENTS. THESE AREAS SHALL BE STABILIZED WITH PERMANENT GROUND COVER PRIOR TO FINAL APPROVAL OF THE PROJECT.
- CONTRACTOR TO PREPARE AND IMPLEMENT SWPPP, CONSTRUCTION SITE NOTICE, NOTICE OF INTENT, NOTICE OF TERMINATION, ETC. AS REQUIRED BY TCEQ.

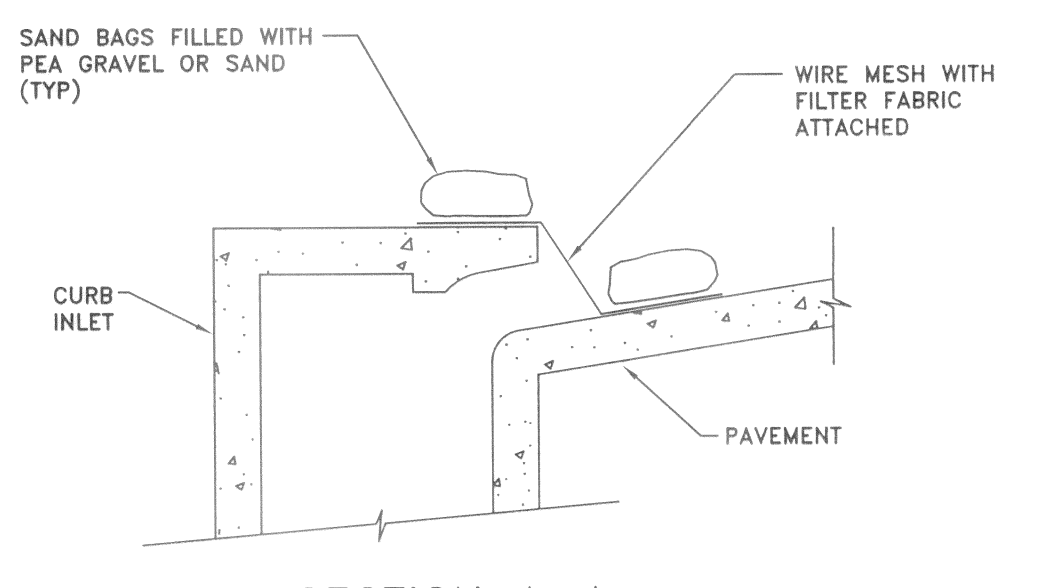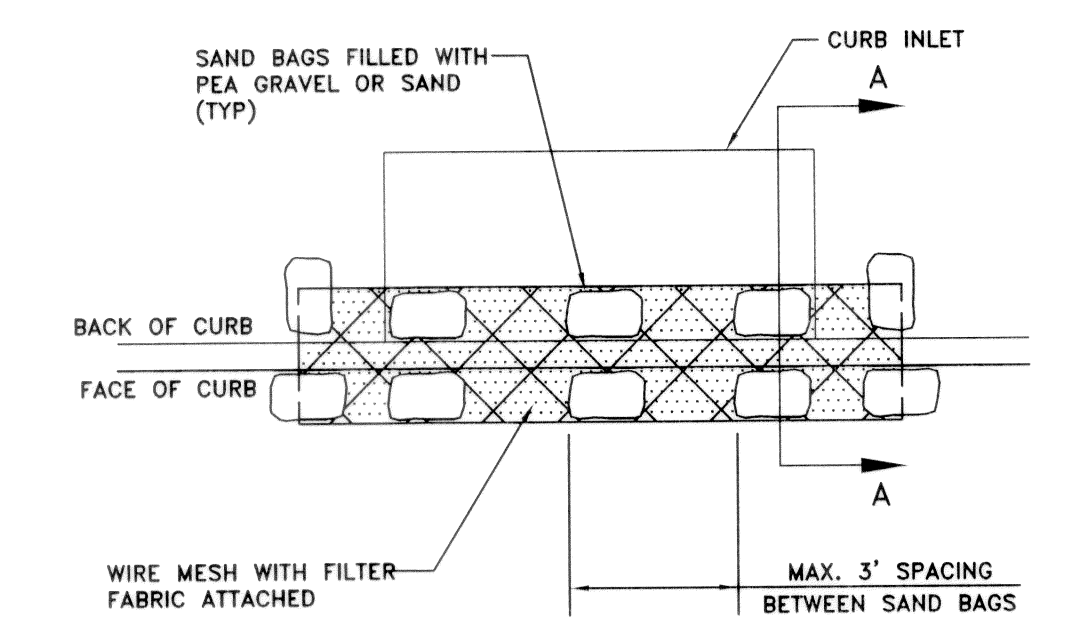

**INLET EROSION PROTECTION AFTER INLET COMPLETION**  
NOT TO SCALE

**INLET PROTECTION NOTES:**

- WIRE MESH PER ASTM D4632 W/OPENING NOT TO EXCEED 1".
- FILTER FABRIC SHALL BE AS PER ASTM D4833. FILTER FABRIC TO BE SECURED TO WIRE MESH WITH WIRE OR PLASTIC CABLE TIES.
- SAND BAGS SHALL BE POLYETHYLENE OR COTTON BURLAP FABRIC 24" TO 30" IN LENGTH AND 15" TO 18" IN WIDTH. BAGS TO BE FILLED WITH PEA GRAVEL OR COARSE GRADE SAND TO APPROXIMATELY 40 POUNDS.

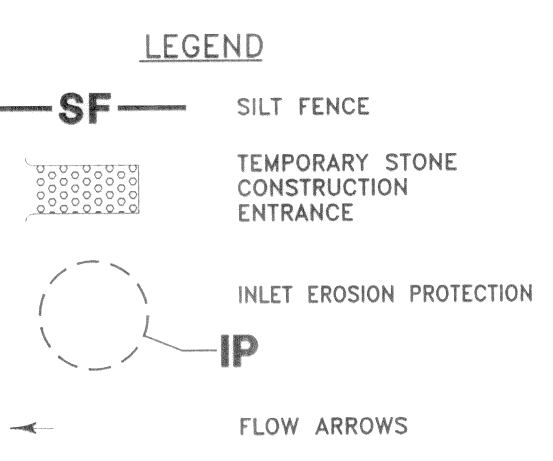

**RECORD DRAWING**  
BASED ON CONTRACTOR MARKUPS  
NOT FIELD SURVEY

<p>THE SEAL APPEARING ON THIS DOCUMENT WAS AUTHORIZED BY: BRUCE R. GRANTHAM ON 11/10/09 ALTERATION OF A SEALED DOCUMENT WITHOUT PROPER NOTIFICATION TO THE RESPONSIBLE ENGINEER IS AN OFFENSE UNDER THE TEXAS ENGINEERING PRACTICE ACT</p>	DATE: FEBRUARY 2009 DRAWN: G&A DESIGN: BRG REVIEWED: BRG DWG: 1057EROSION	SCALE: 1"=40' JOB NO.: 1057-06
	MIXED USE DEVELOPMENT TOWN OF ADDISON EROSION CONTROL PLAN <b>SNK DEVELOPMENT INC.</b> <b>g&amp;a</b> Grantham & Associates Civil Engineering 1919 S. SHILOH ROAD, SUITE 440, L.B. 8 GARLAND, TEXAS 75042 (972) 864-2333 (TEL) (972) 864-2334 (FAX)	
		SHT. 5 OF 11