

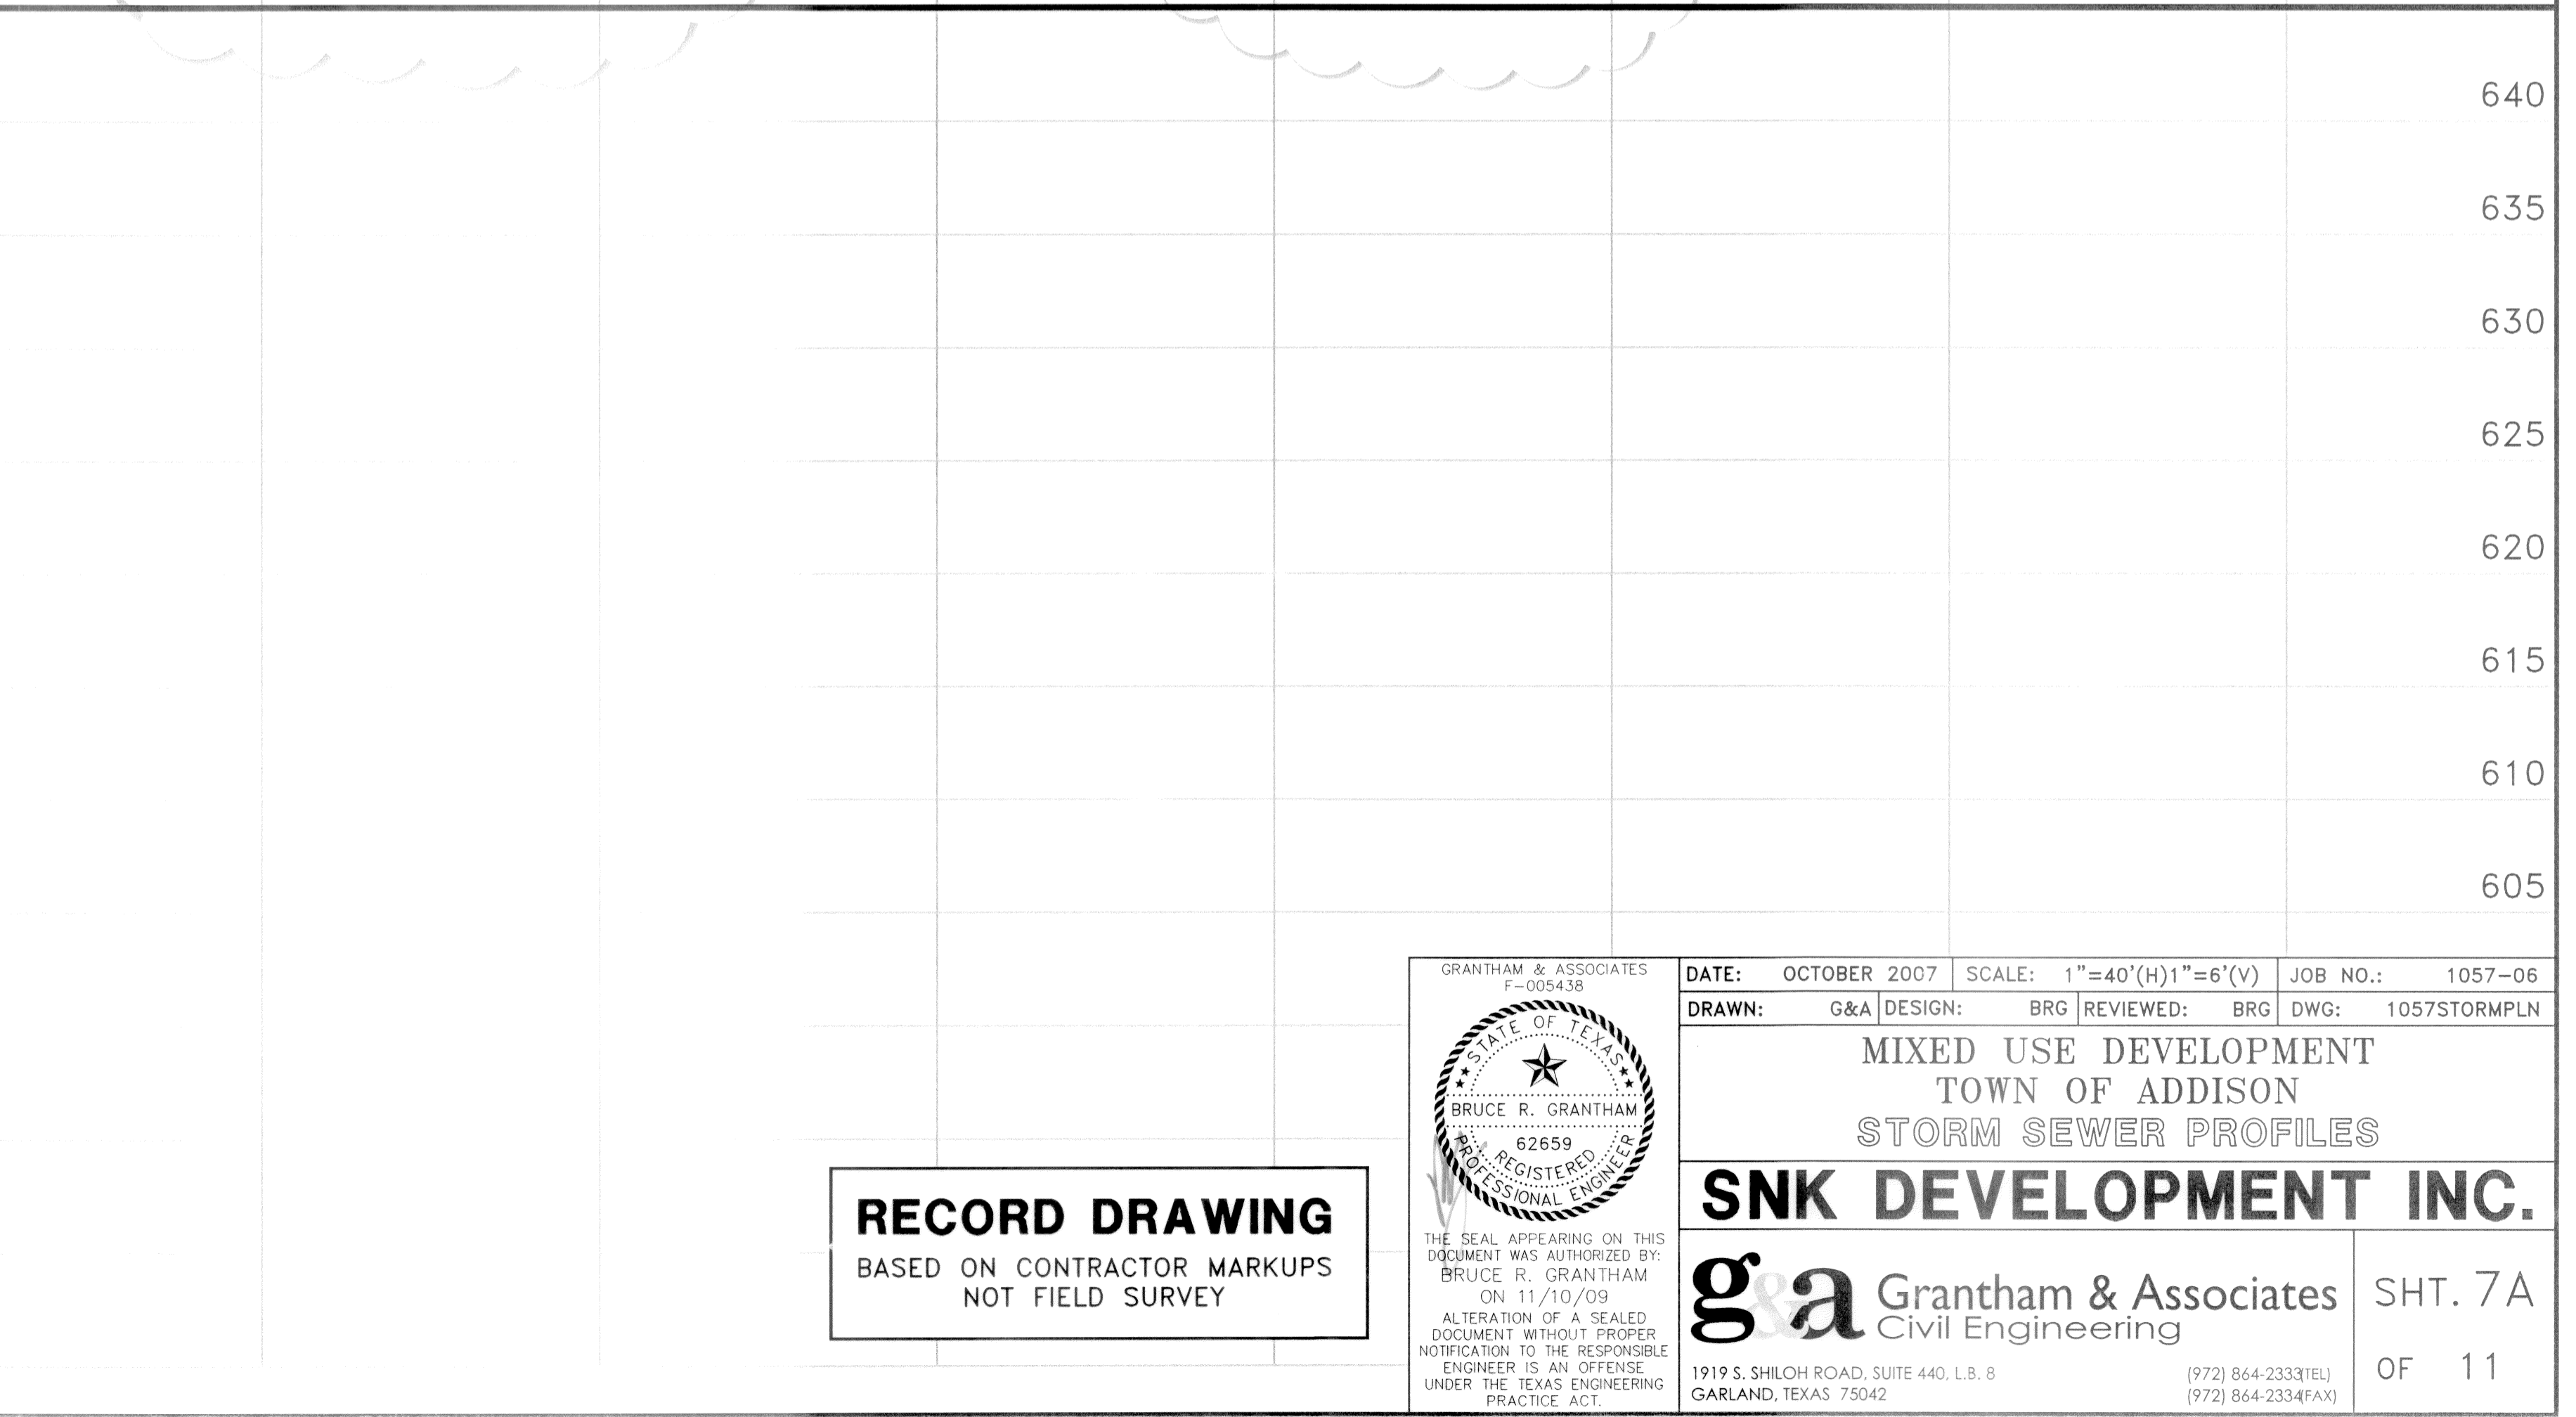
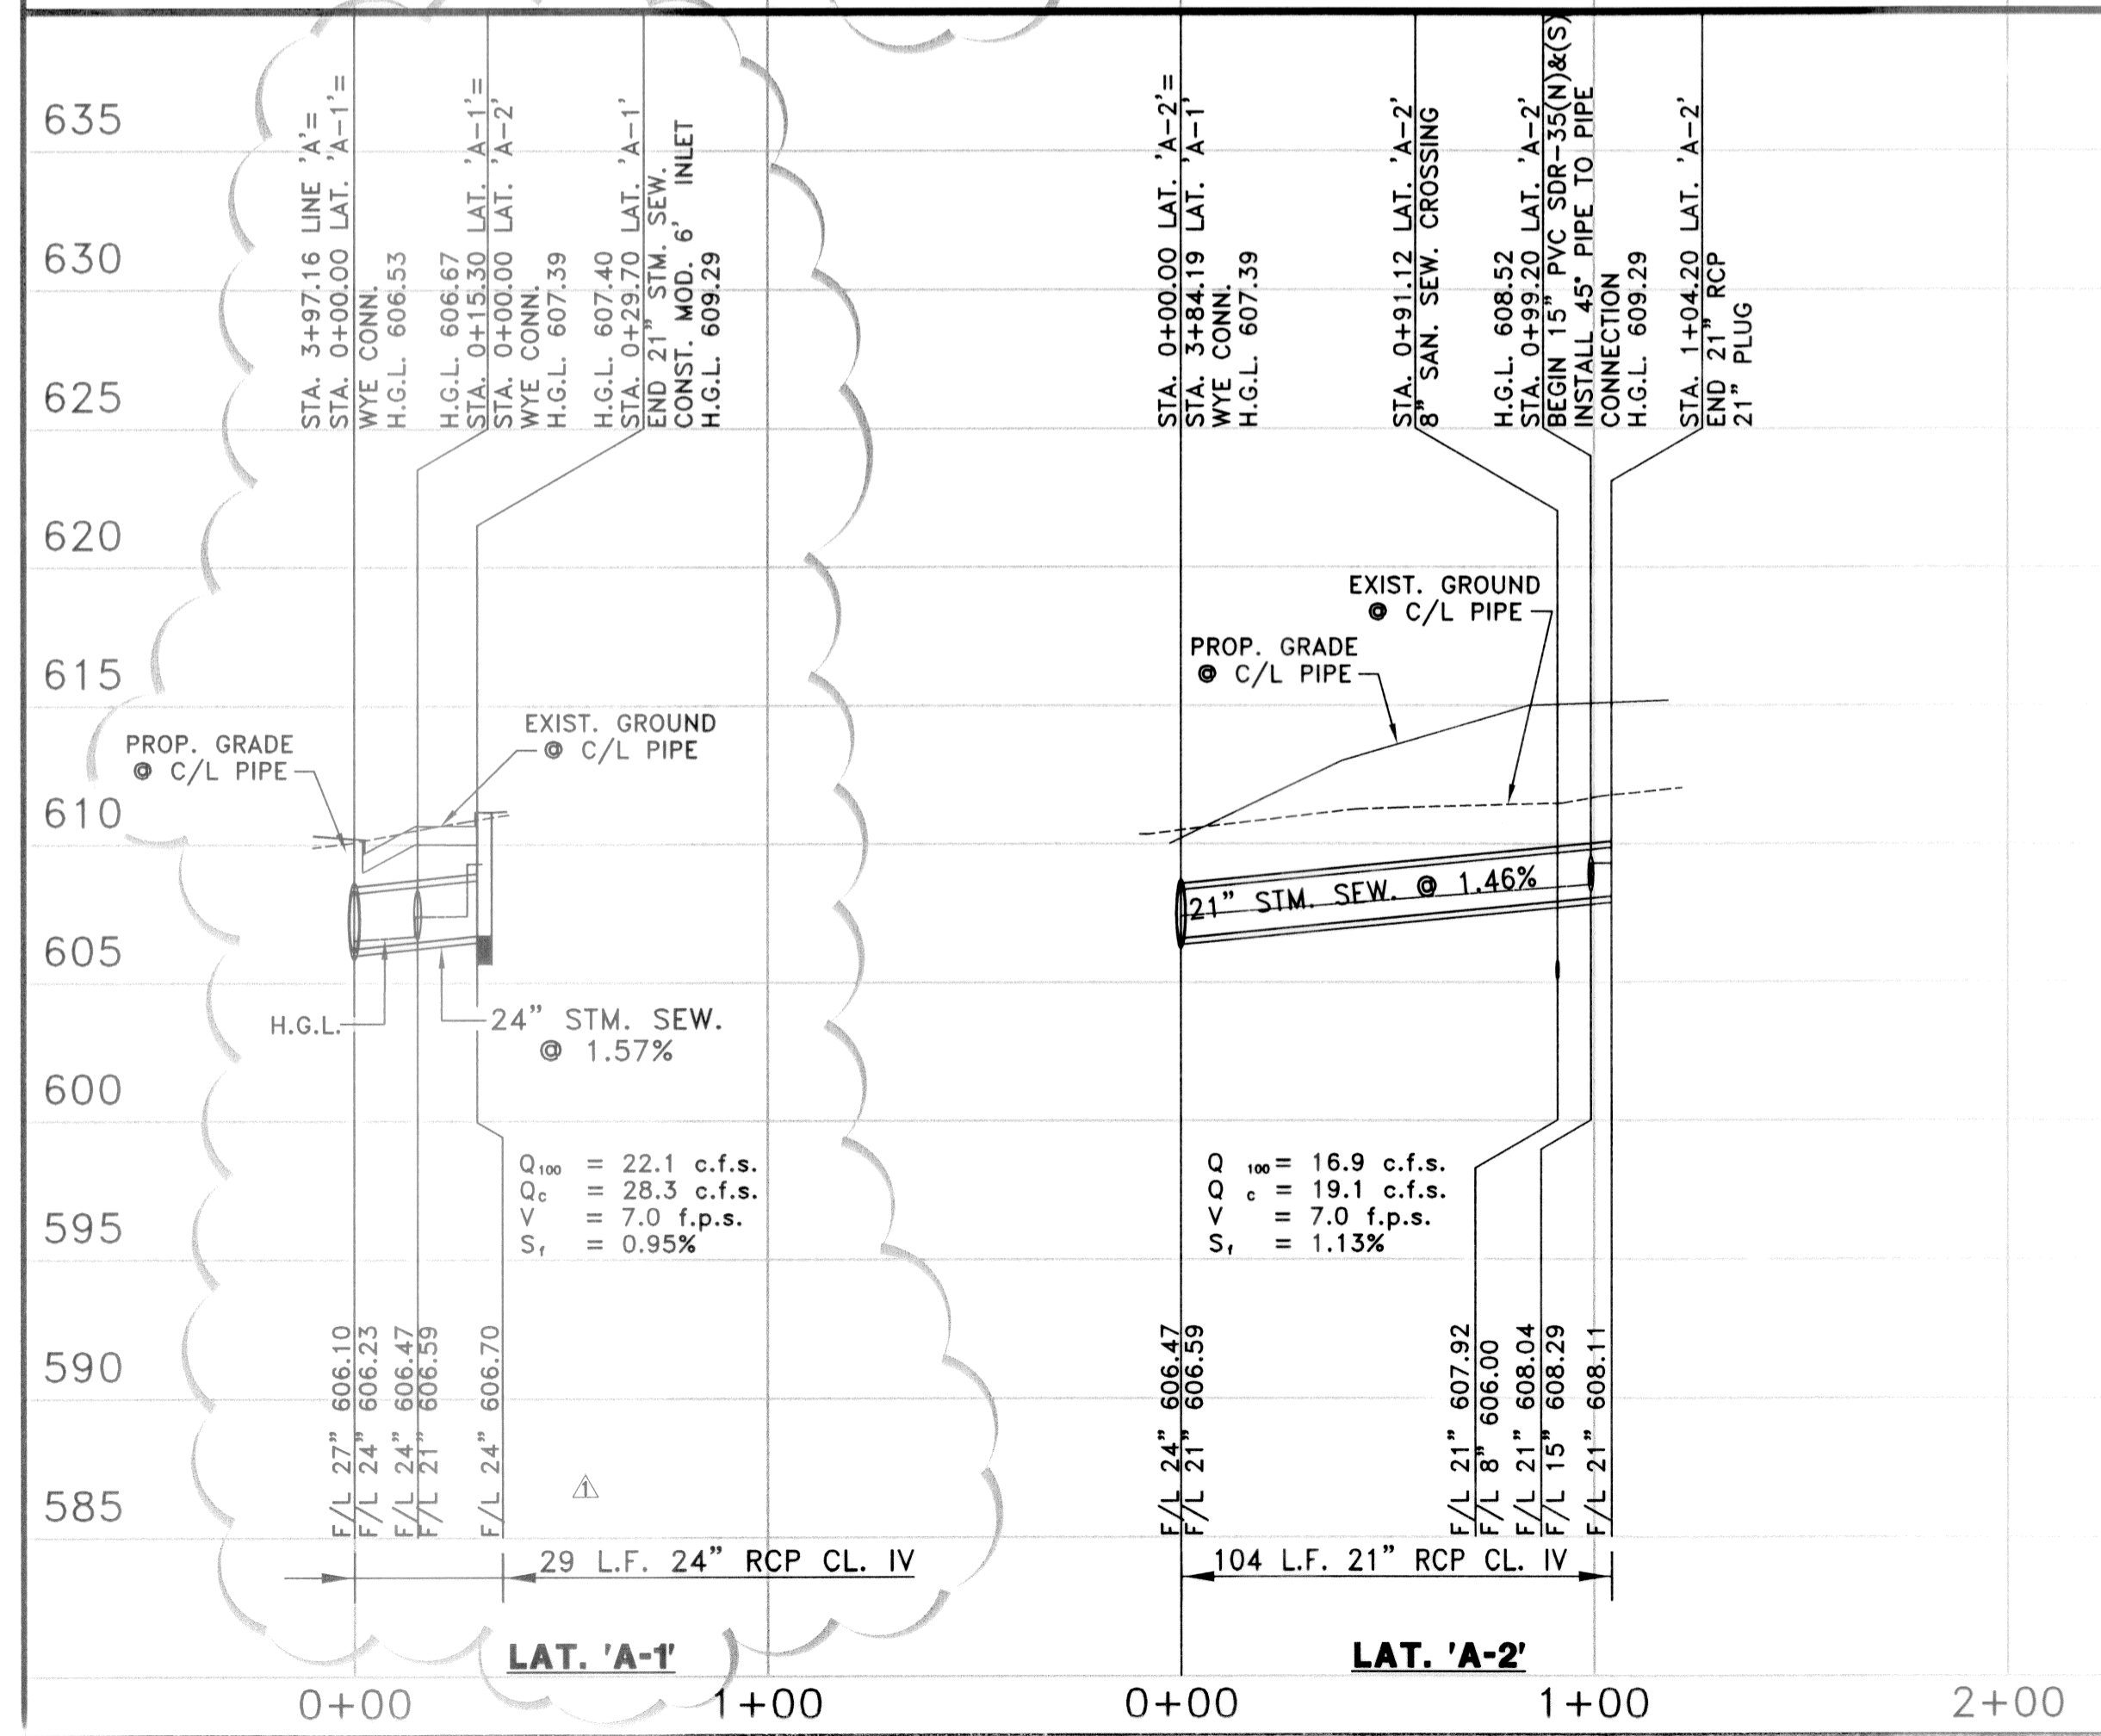
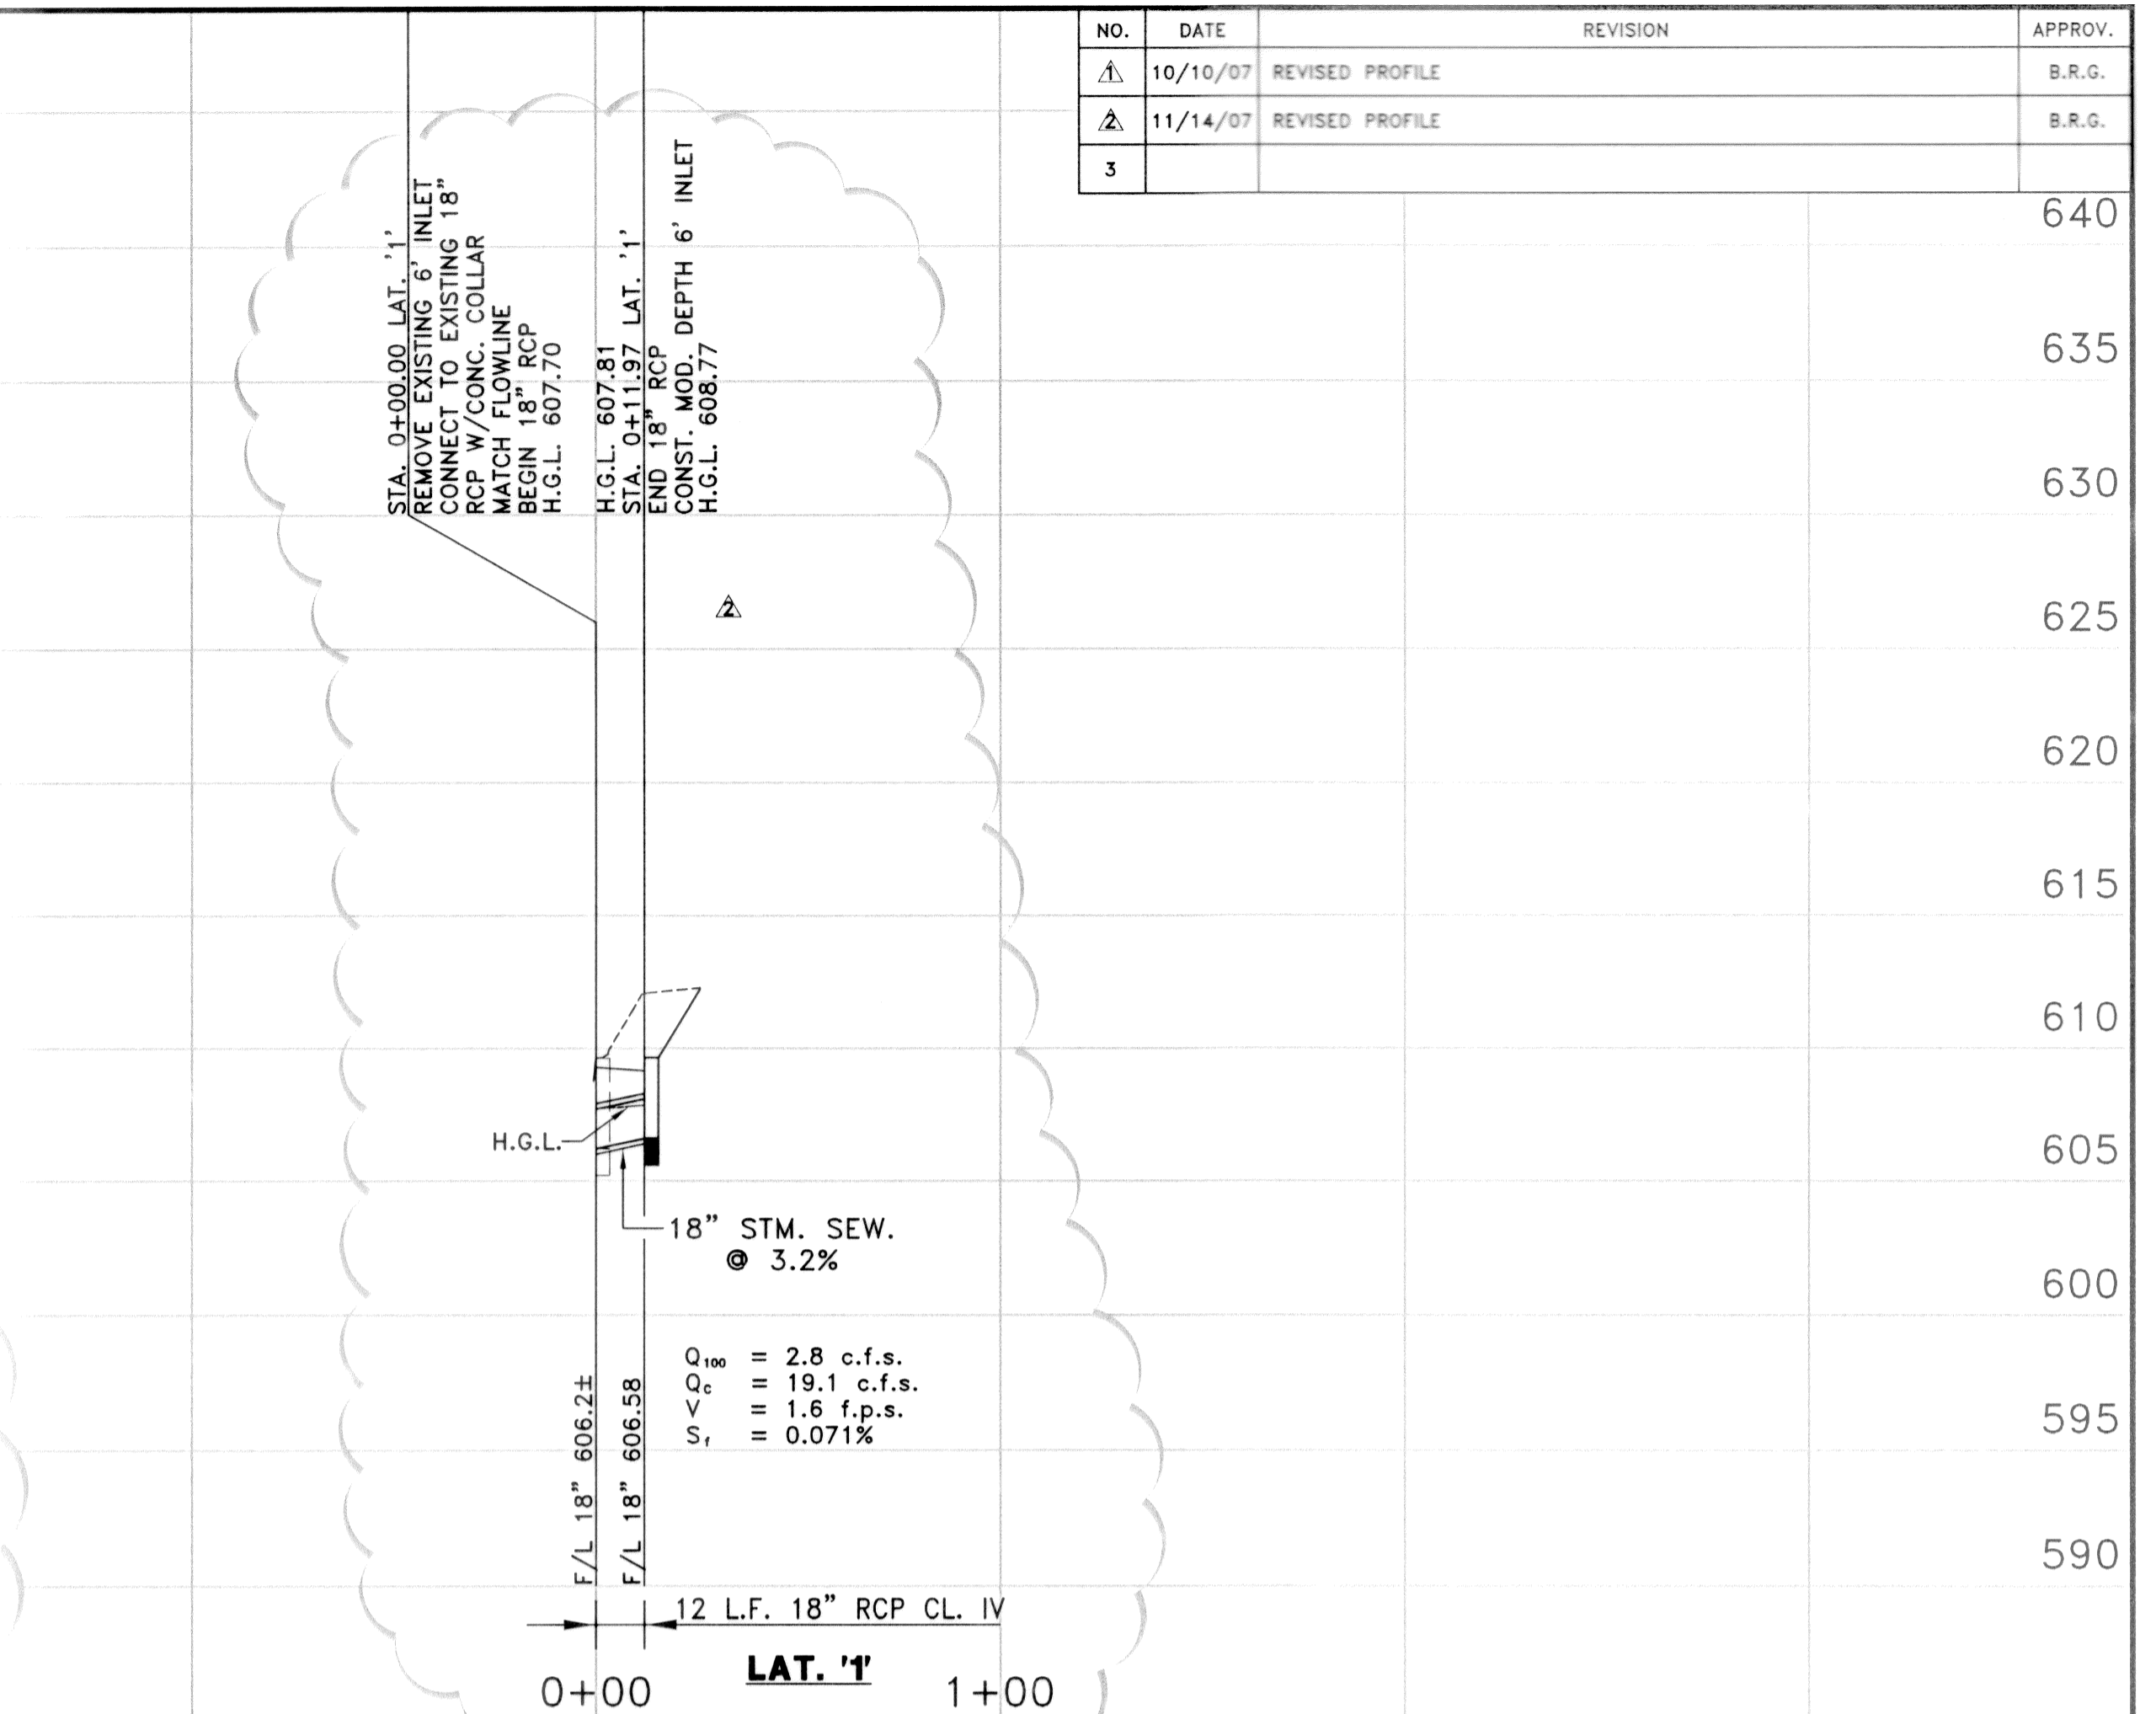
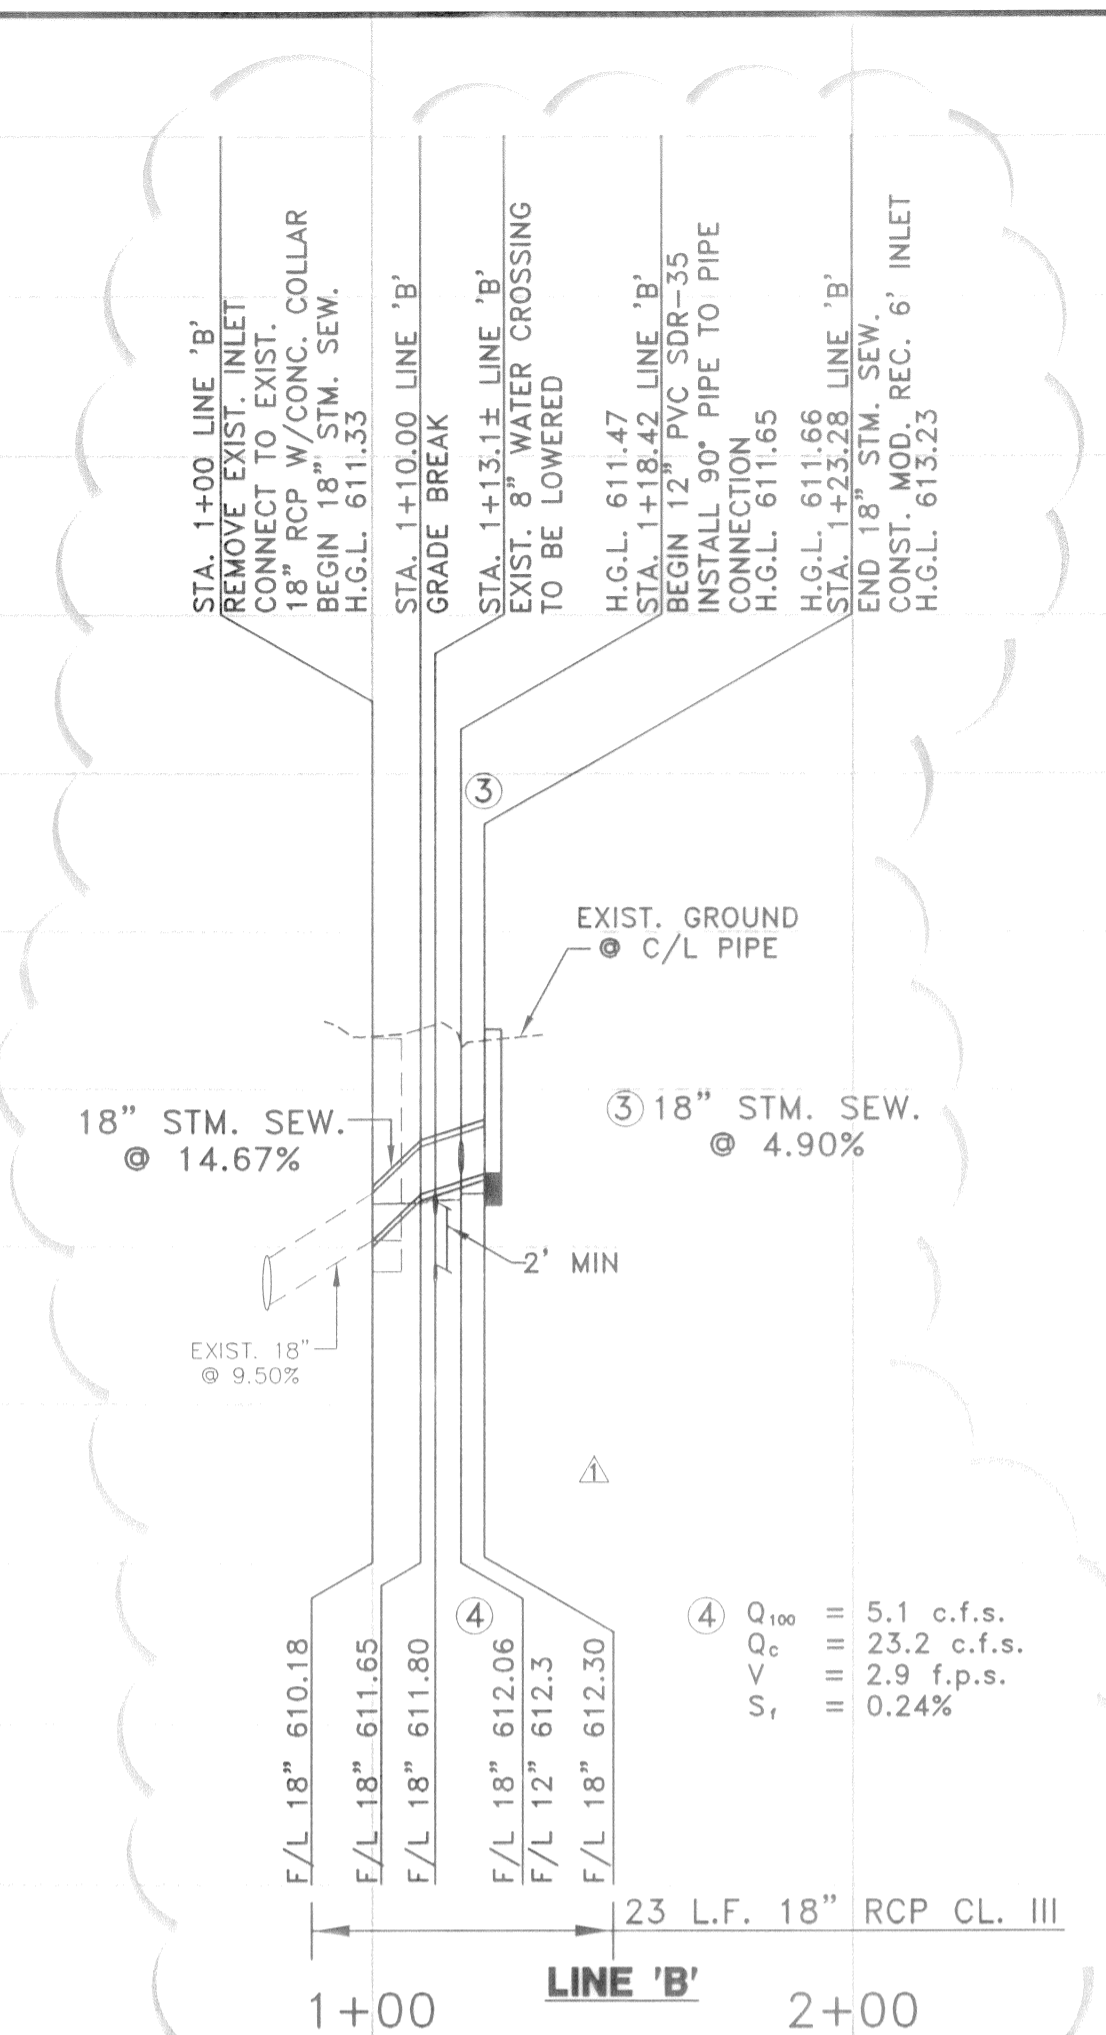


NO.	DATE	REVISION	APPROV.
1	10/10/07	REVISED PROFILE	B.R.G.
2	11/14/07	REVISED PROFILE	B.R.G.
3			

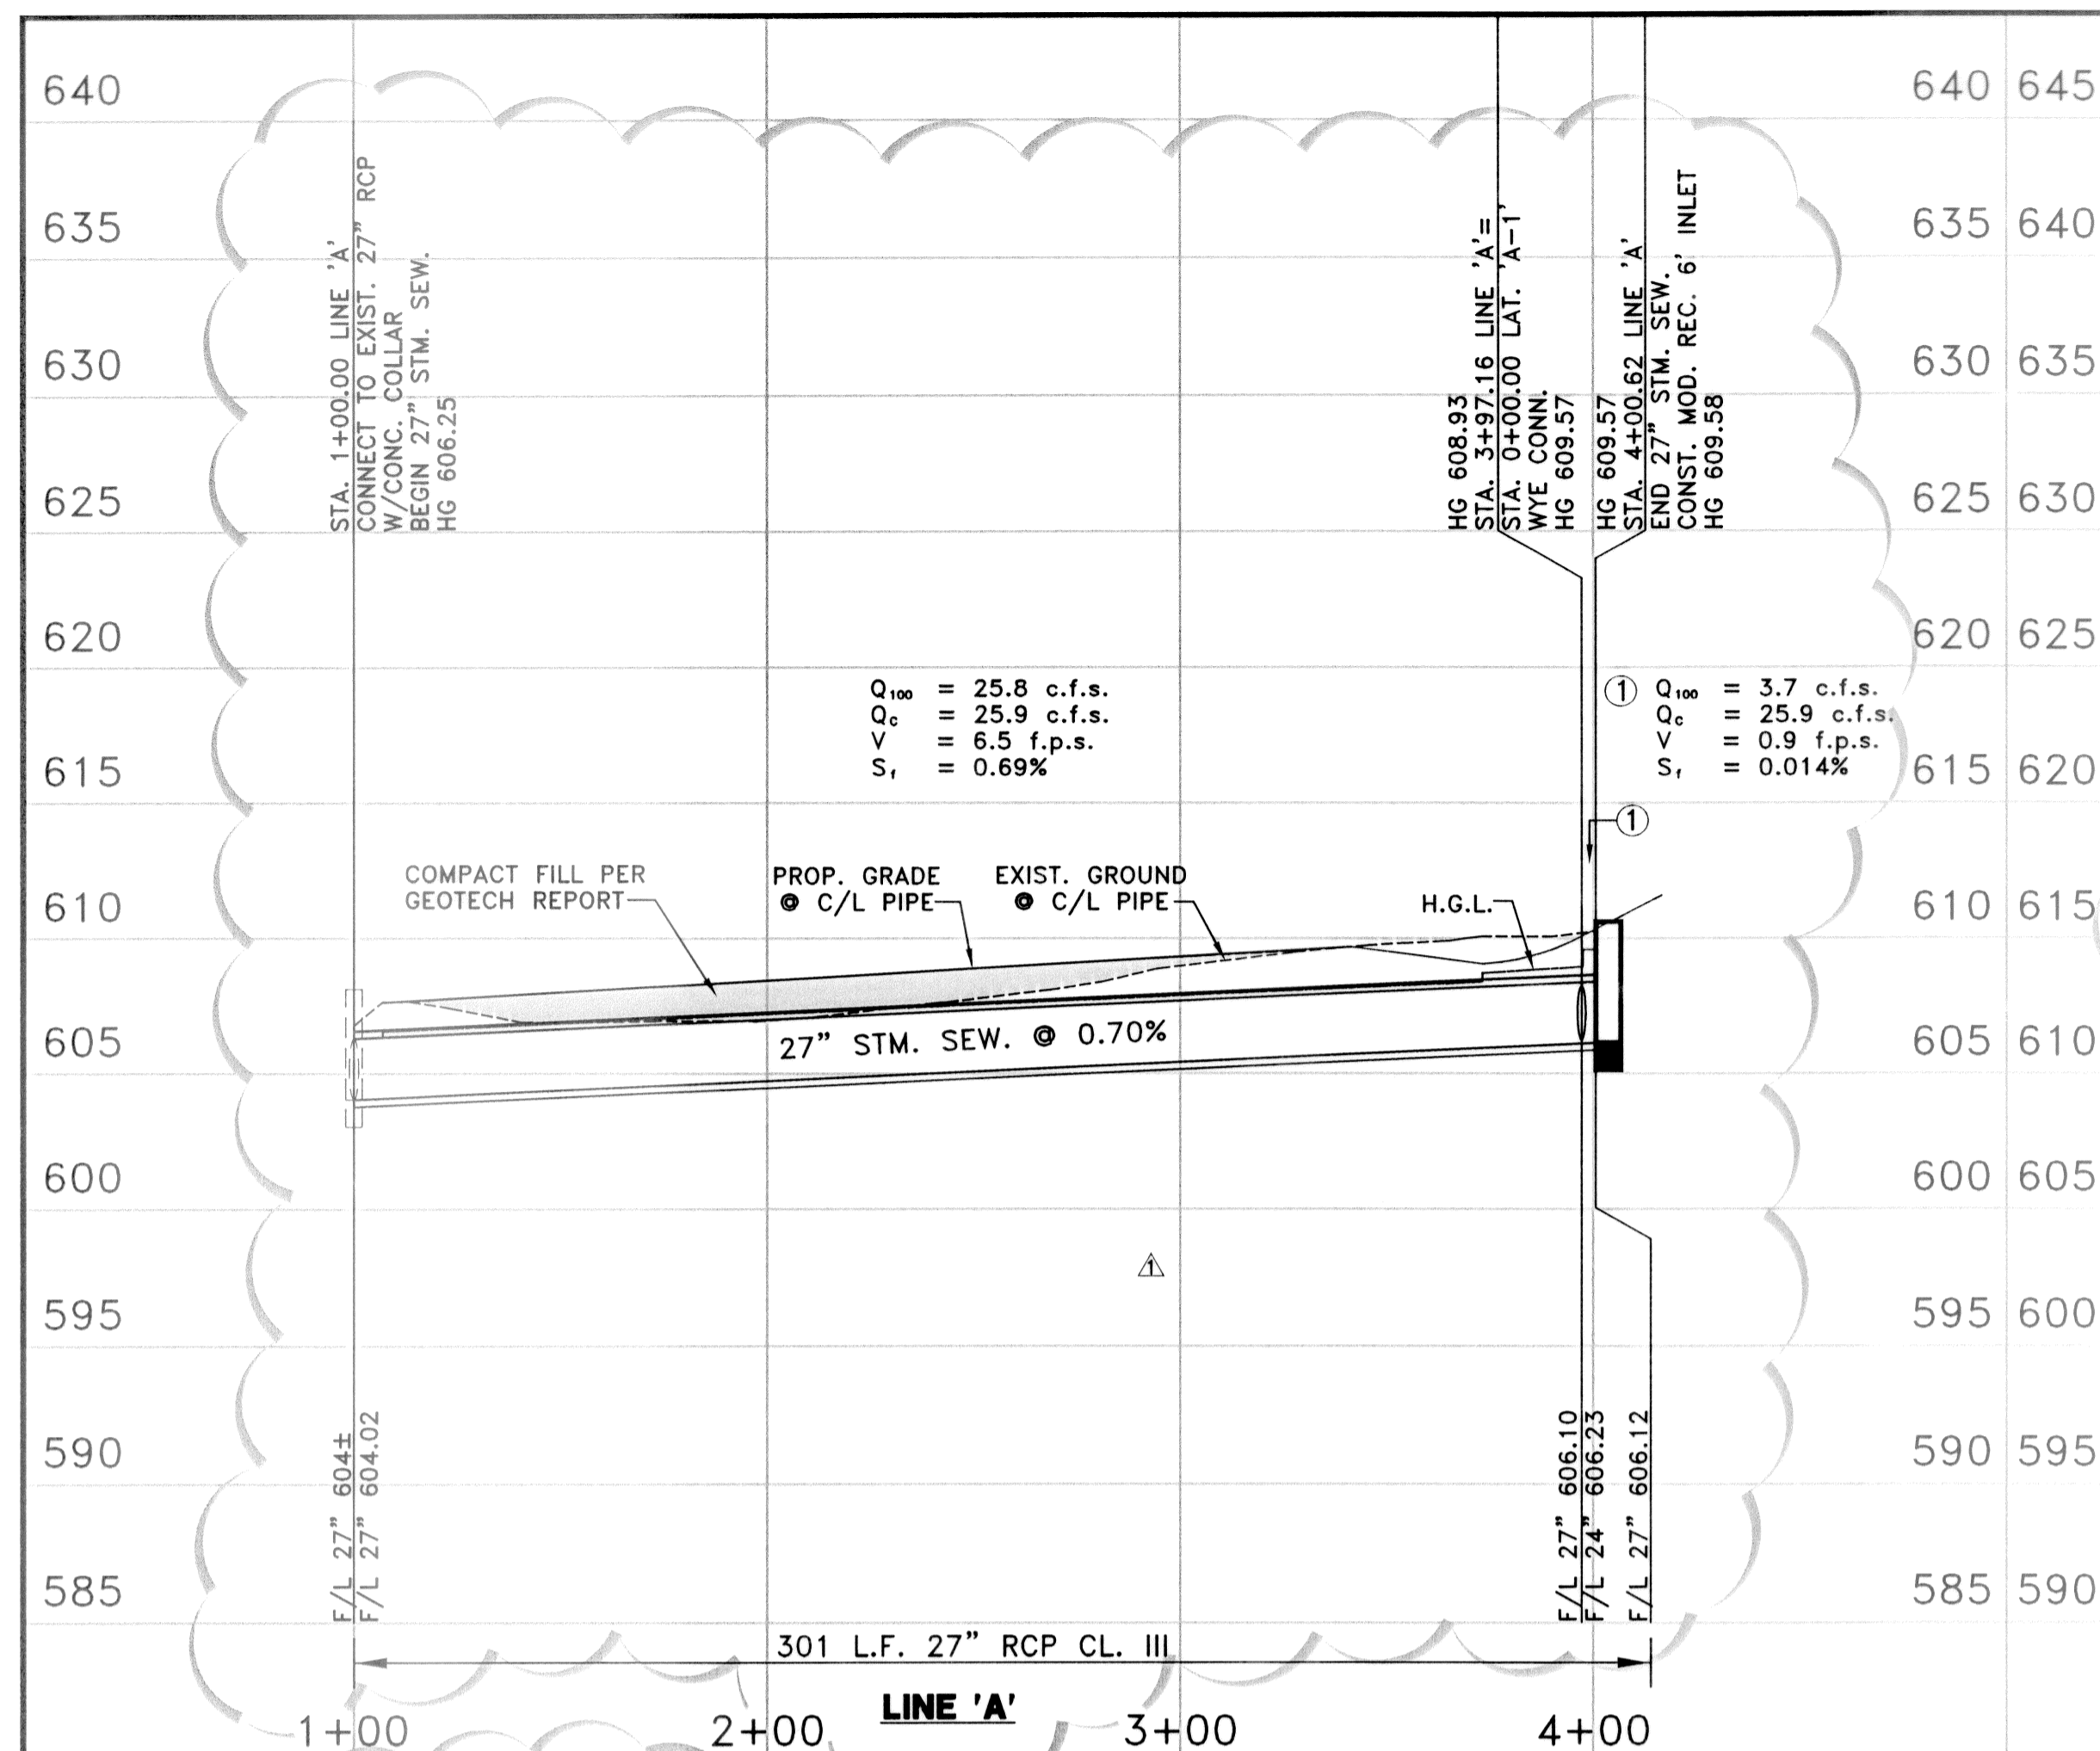

**RECORD DRAWING**  
 BASED ON CONTRACTOR MARKUPS  
 NOT FIELD SURVEY

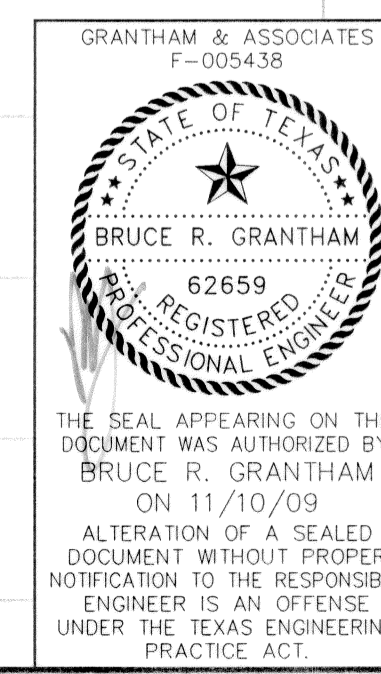

GRANTHAM & ASSOCIATES  
 F-005438

DATE: OCTOBER 2007 SCALE: 1"=40'(H)1"=6'(V) JOB NO.: 1057-06  
 DRAWN: G&A DESIGN: BRG REVIEWED: BRG DWG: 1057STORMPLN

MIXED USE DEVELOPMENT  
 TOWN OF ADDISON  
 STORM SEWER PROFILES

**SNK DEVELOPMENT INC.**

g&a Grantham & Associates  
 Civil Engineering

1919 S. SHILOH ROAD, SUITE 440, L.B. 8  
 GARLAND, TEXAS 75042 (972) 864-2333(TEL)  
 (972) 864-2334(FAX)

SHT. 7A  
 OF 11