

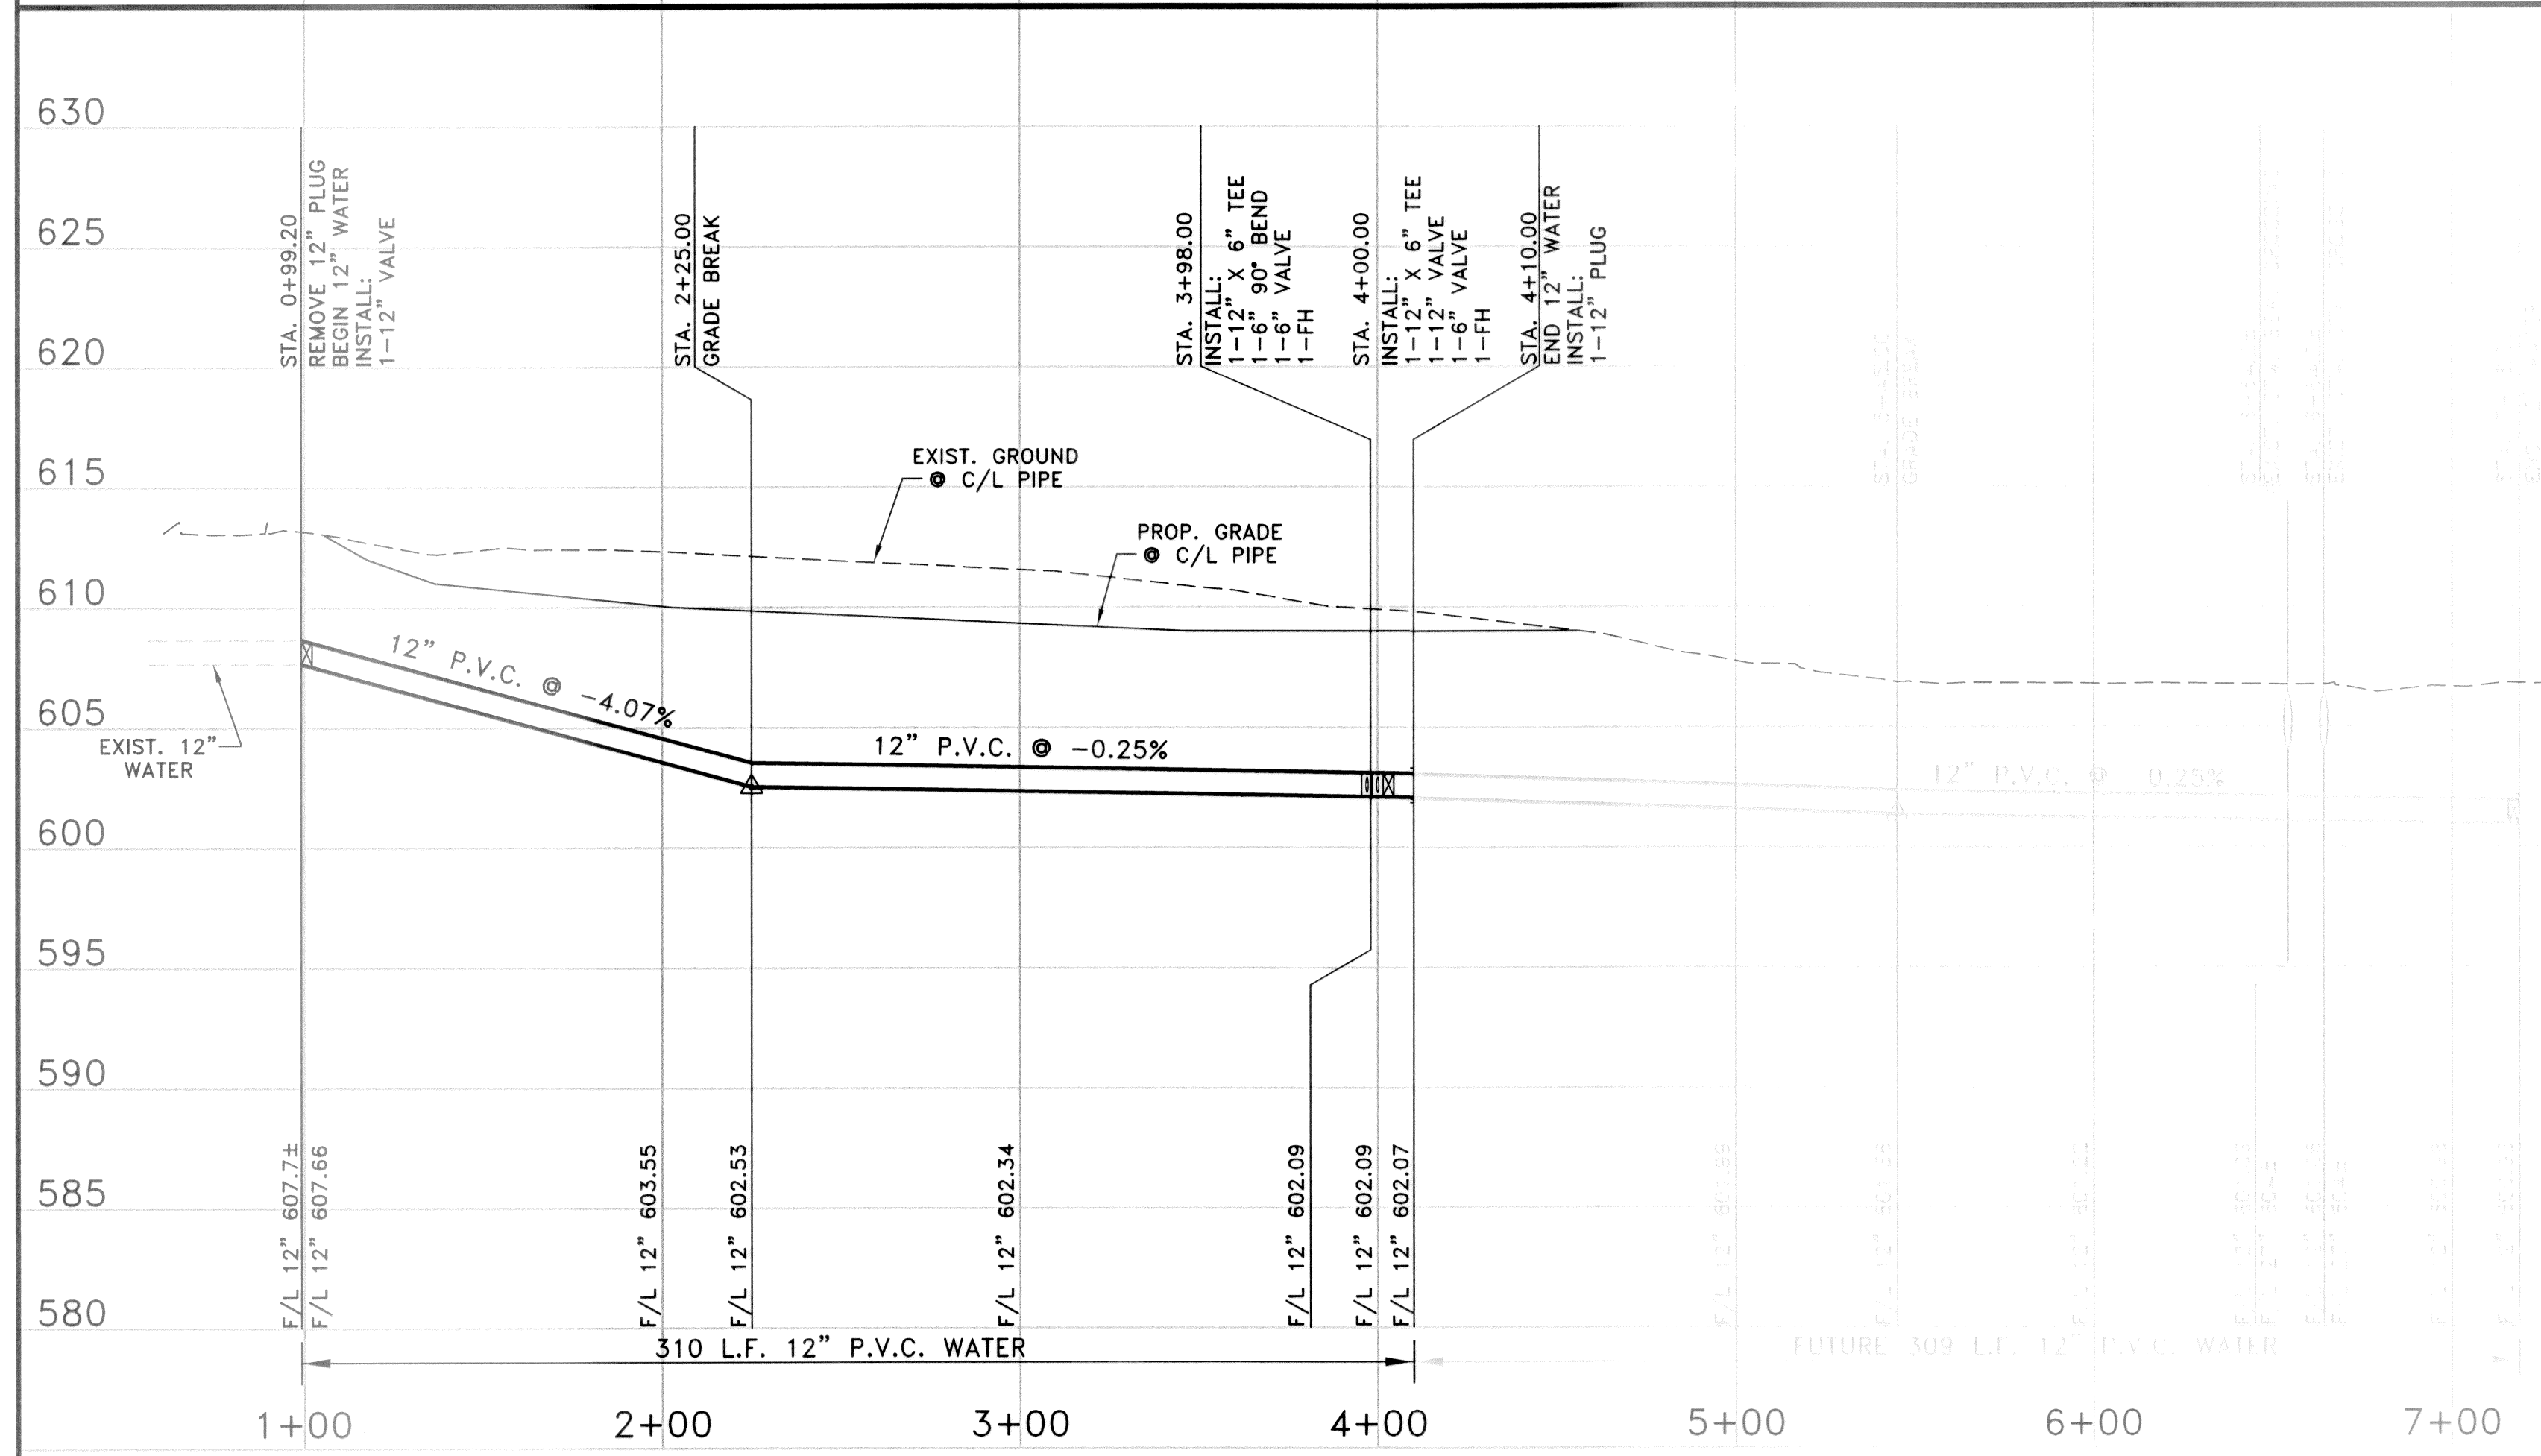


NO.	DATE	REVISION	APPROV.
1			
2			
3			

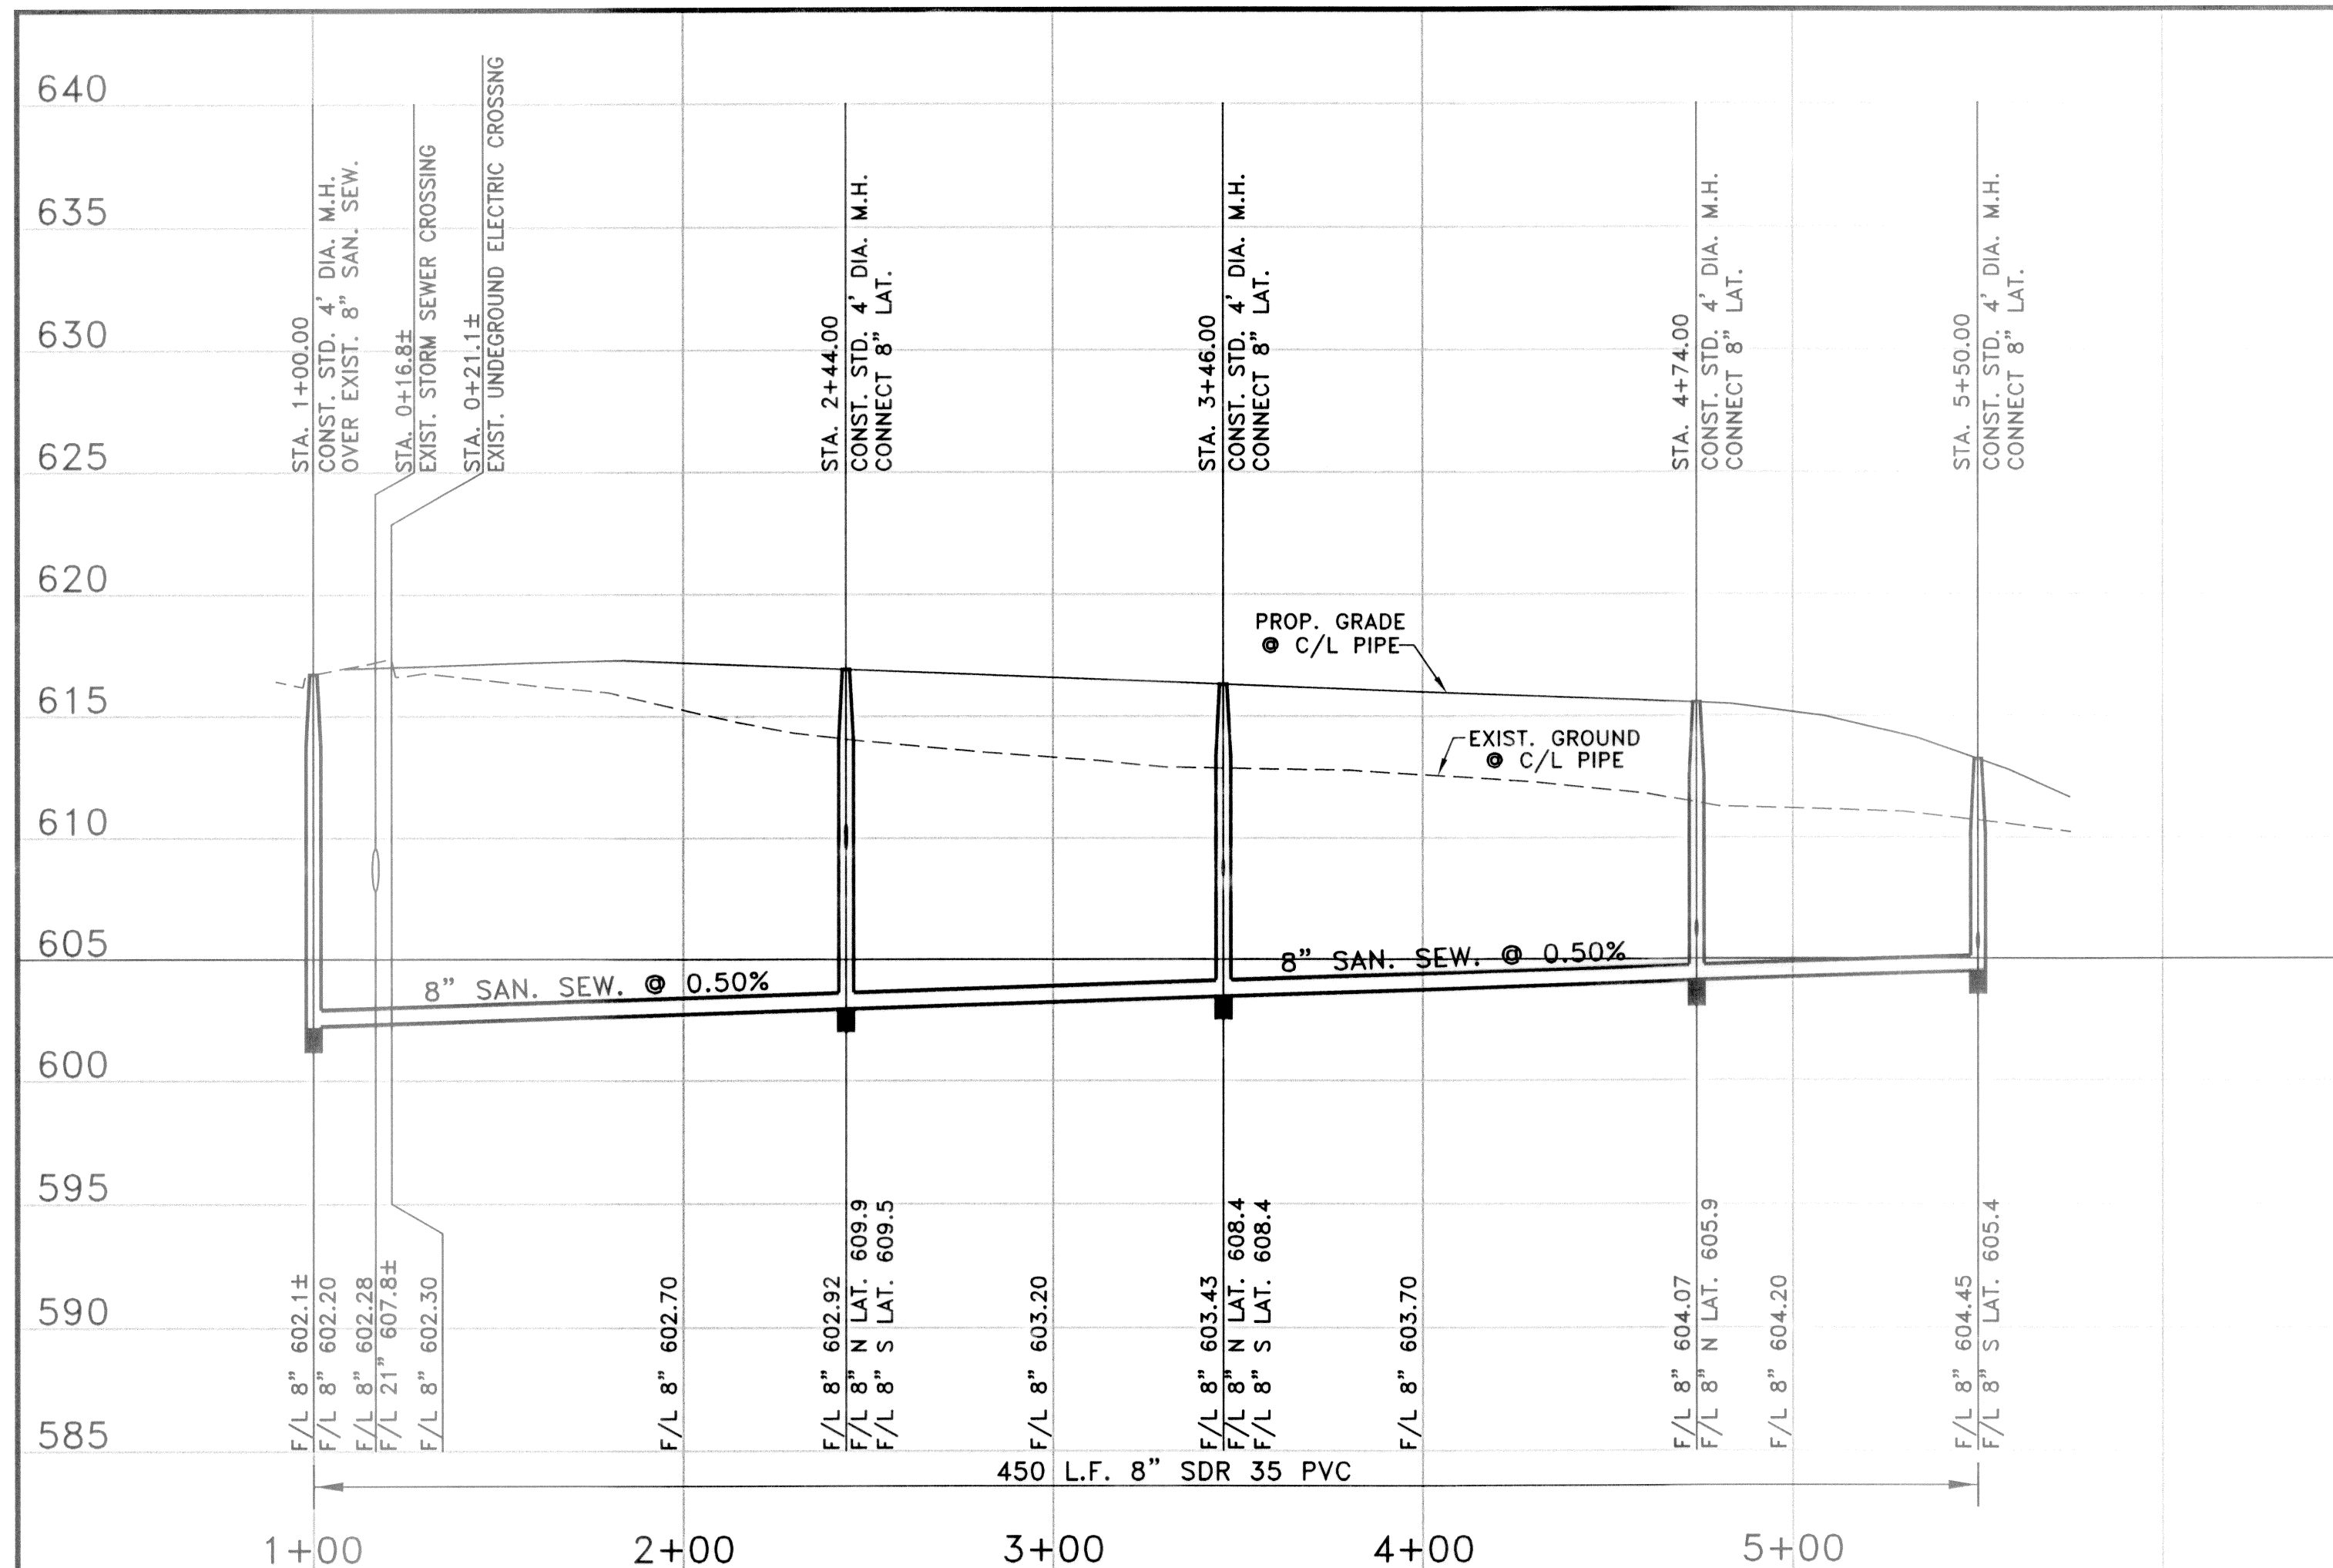

RECORD DRAWING
 BASED ON CONTRACTOR MARKUPS
 NOT FIELD SURVEY

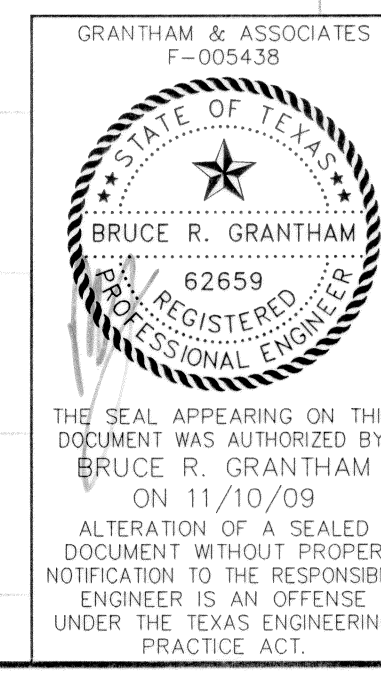

GRANTHAM & ASSOCIATES
 F-005438

DATE: APRIL 2007 SCALE: 1"=40'(H)1"=6'(V) JOB NO.: 1057-06
 DRAWN: G&A DESIGN: BRG REVIEWED: BRG DWG: 1057WATSEW01PP

MIXED USE DEVELOPMENT
 TOWN OF ADDISON
 12' WATER & SANITARY SEWER PROFILES

SNK DEVELOPMENT INC.

g&a Grantham & Associates
 Civil Engineering

1919 S. SHILOH ROAD, SUITE 440, L.B. 8
 GARLAND, TEXAS 75042 (972) 864-2333(TEL)
 (972) 864-2334(FAX)

SHT. 9
 OF 11