
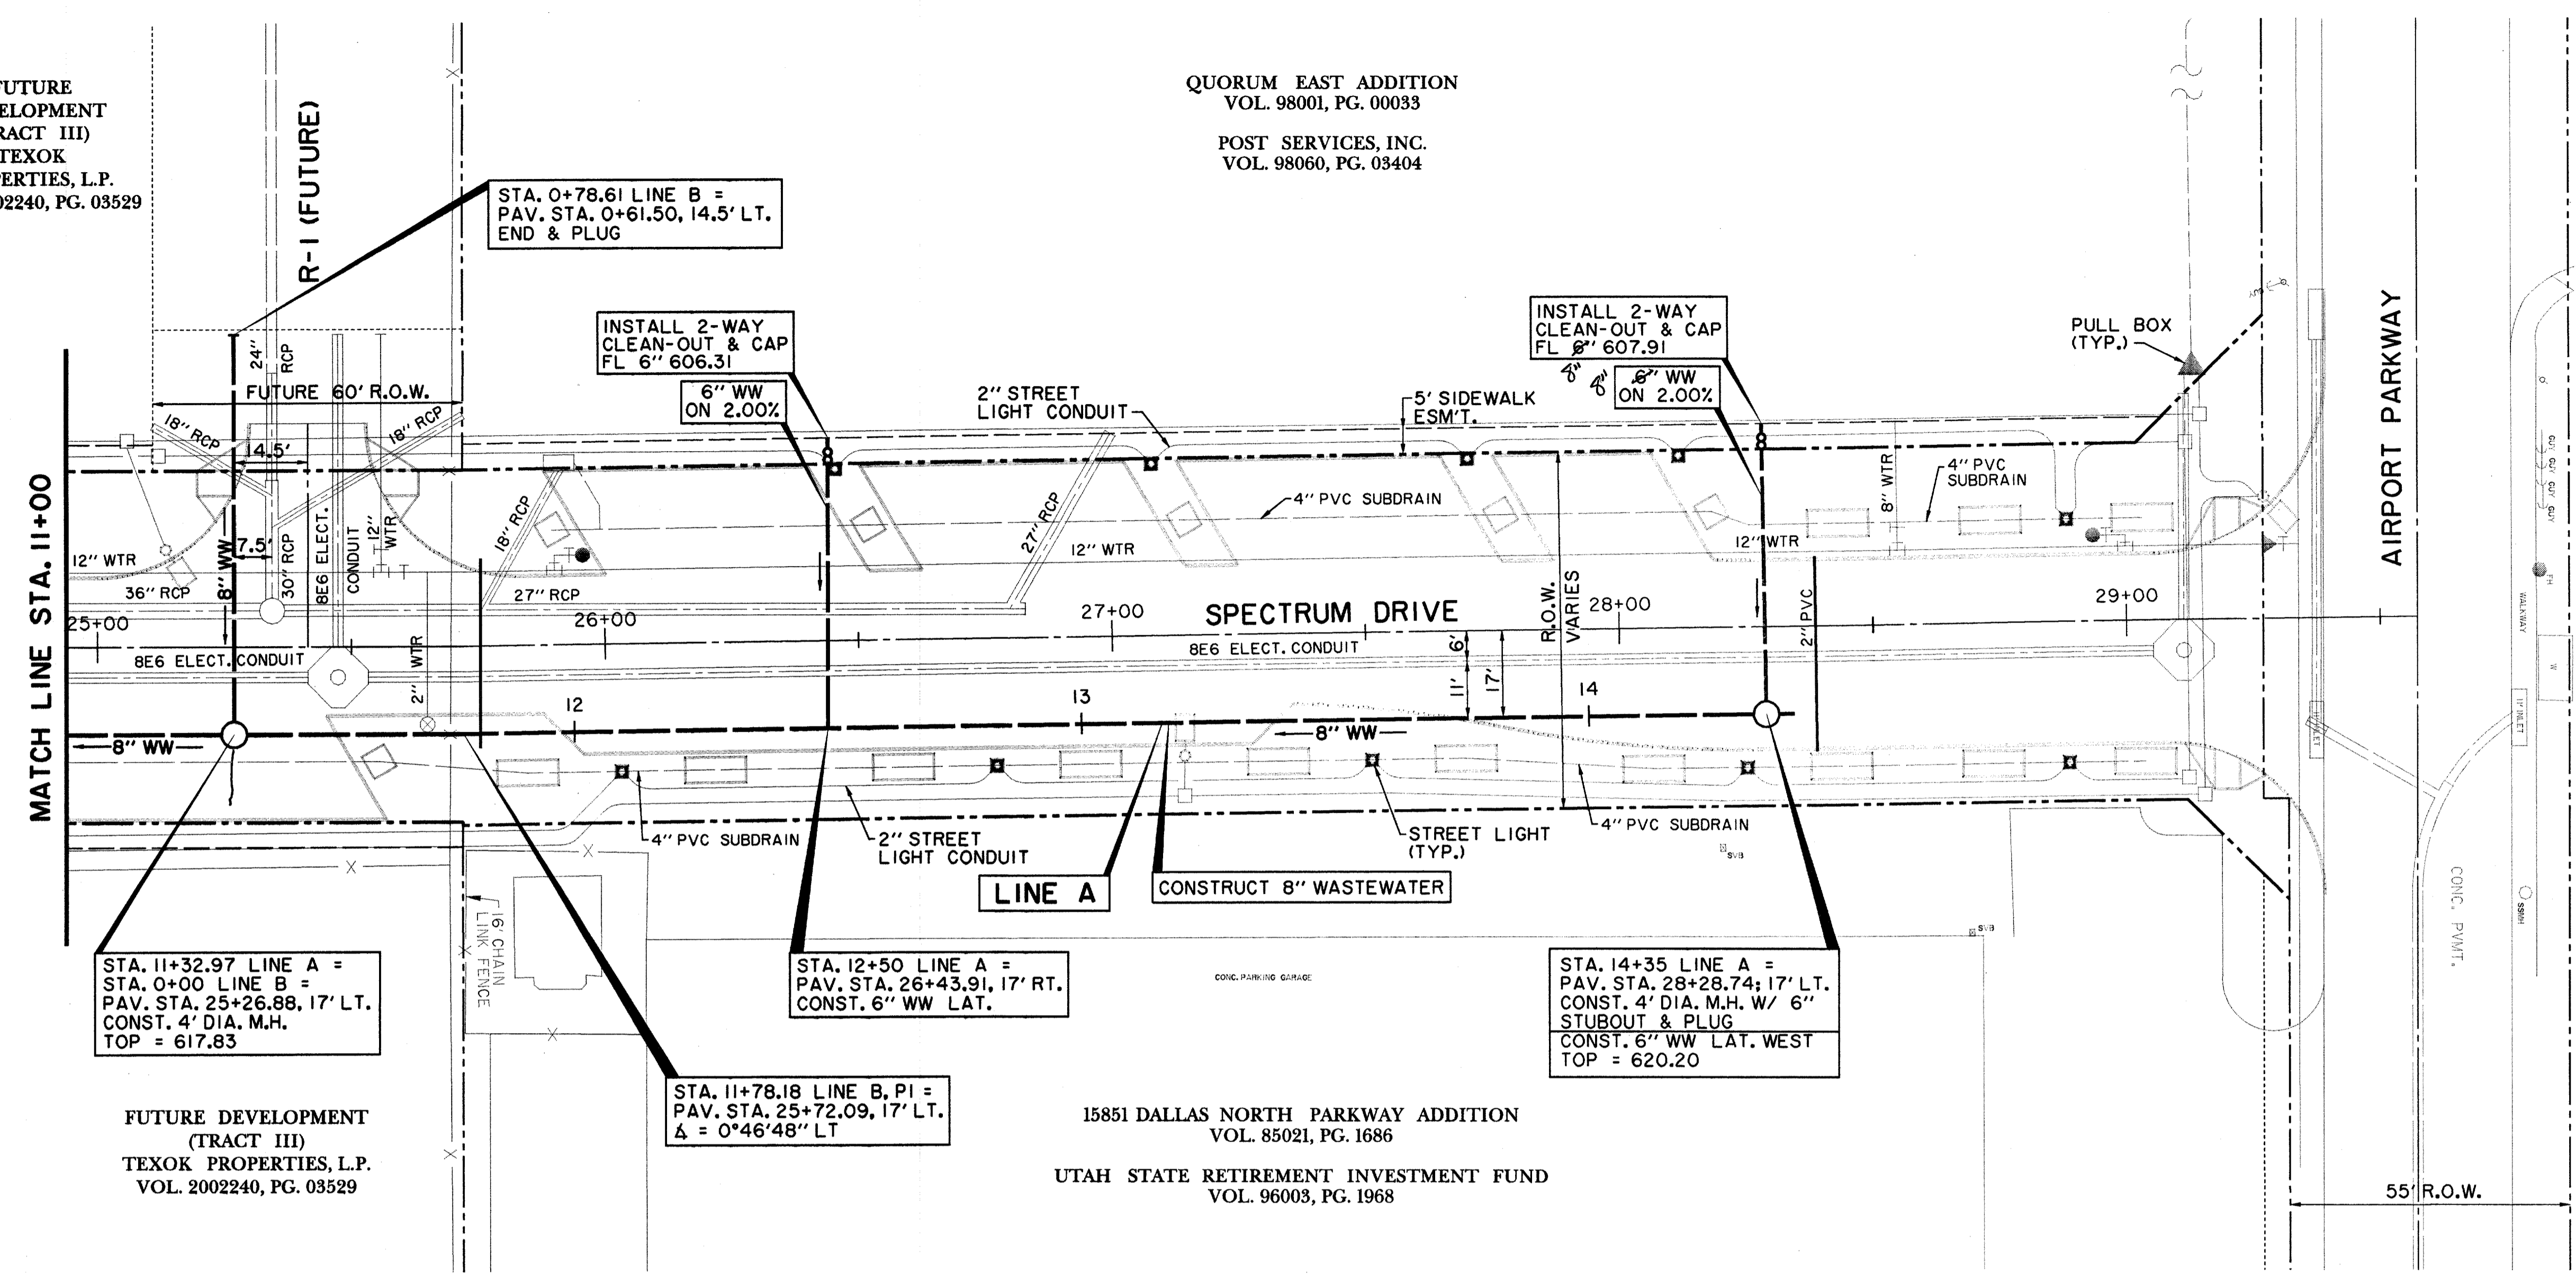


FUTURE DEVELOPMENT (TRACT III) TEXOK PROPERTIES, L.P. VOL. 2002240, PG. 03529

QUORUM EAST ADDITION VOL. 98001, PG. 00033  
POST SERVICES, INC. VOL. 98060, PG. 03404

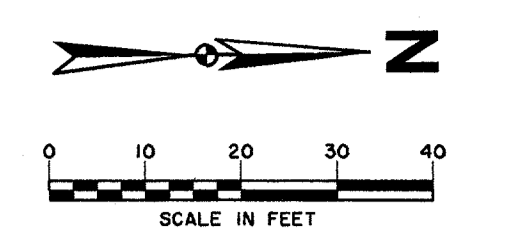


*2-6" gas laterals.*


P:\11\11\2001\11\2001\11\2001.dwg  
 11/05/04 10:00:00  
 11/07/03 10:00:00  
 11/07/03 10:00:00  
 11/07/03 10:00:00  
 11/07/03 10:00:00

FUTURE DEVELOPMENT (TRACT III) TEXOK PROPERTIES, L.P. VOL. 2002240, PG. 03529

15851 DALLAS NORTH PARKWAY ADDITION VOL. 85021, PG. 1686  
UTAH STATE RETIREMENT INVESTMENT FUND VOL. 96003, PG. 1968

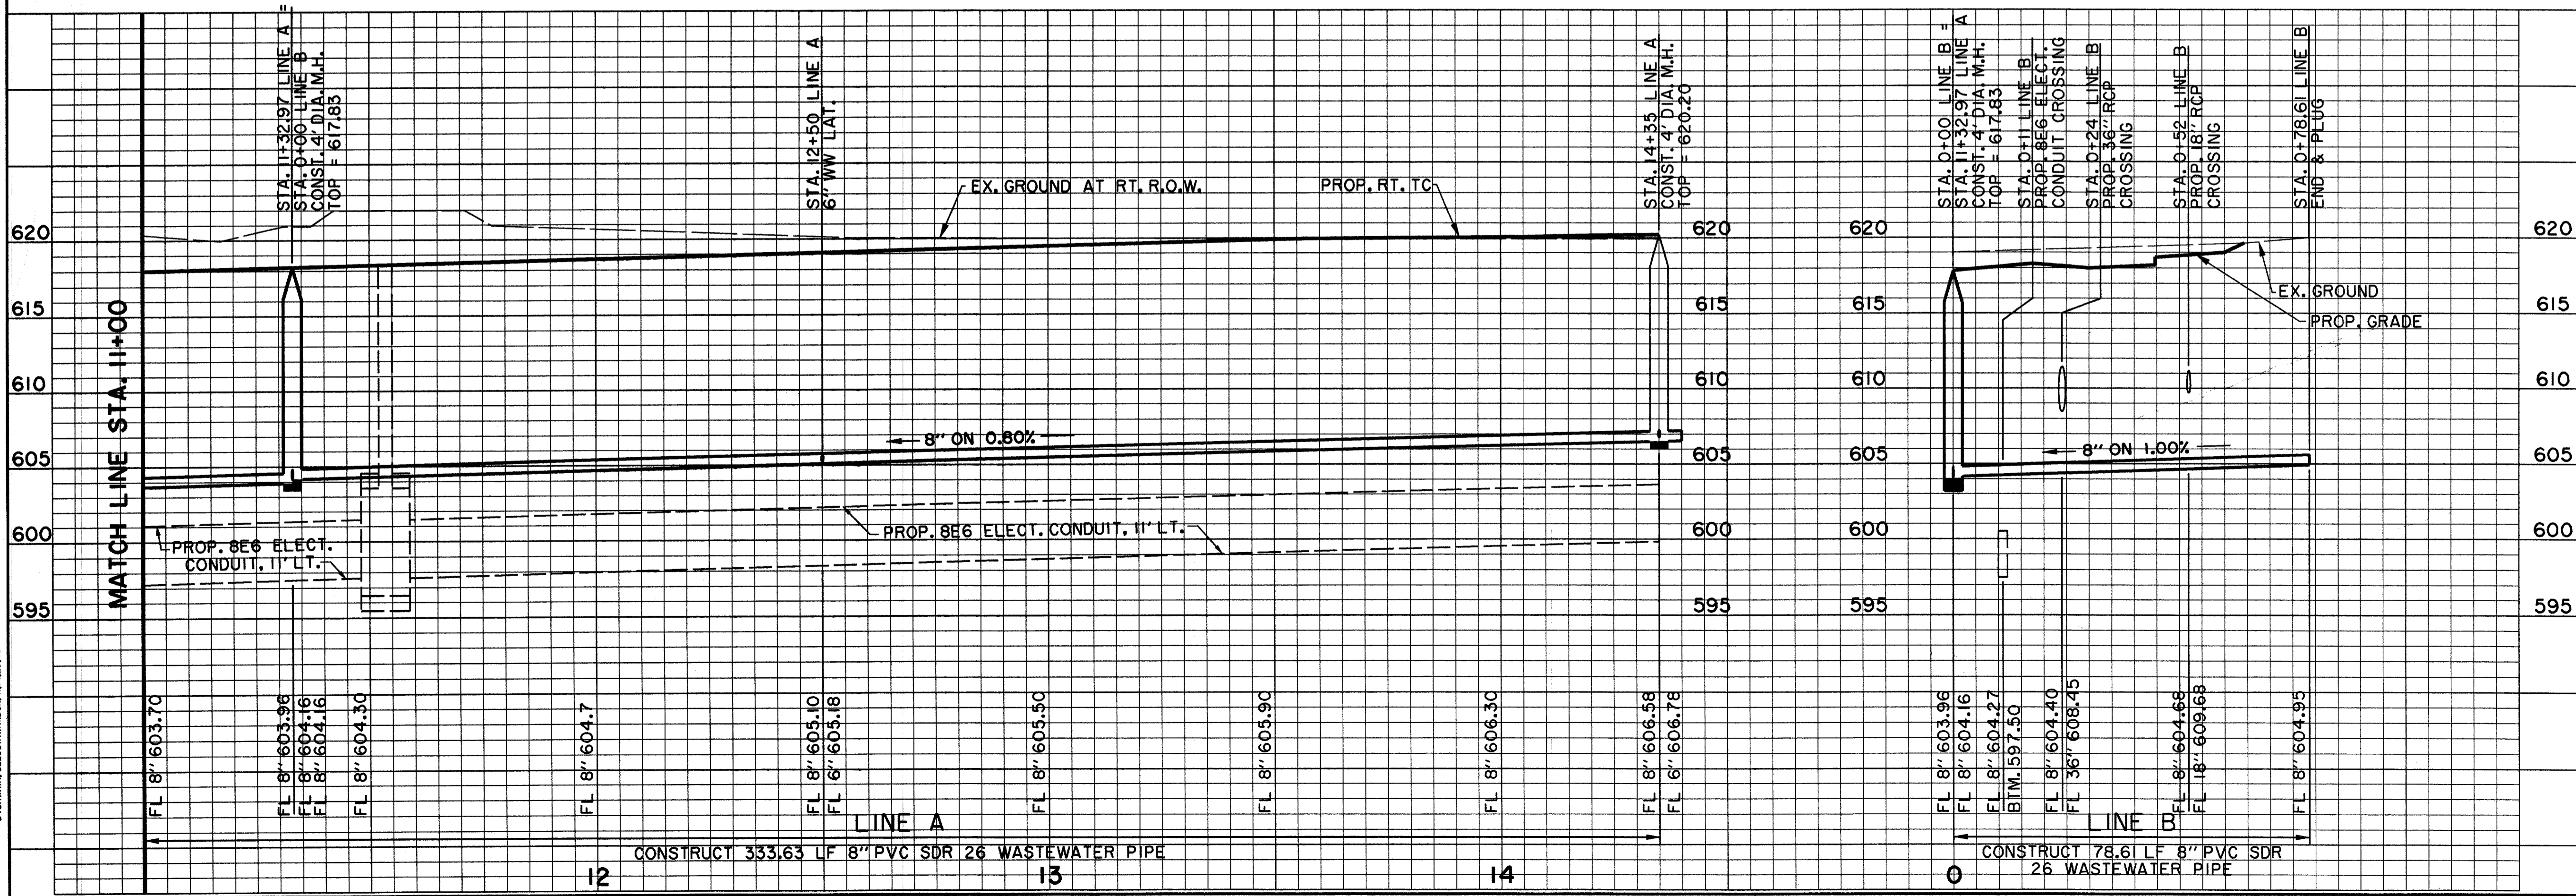

**BENCHMARKS:**  
 "□" CUT SOUTHWEST CORNER OF CURB INLET, WEST SIDE OF SPECTRUM DRIVE, ±30' NORTH OF MORRIS AVENUE. ELEV. 611.84  
 "□" CUT ON TOP EAST END OF CURB INLET ON NORTH SIDE OF MORRIS AVENUE AND ±150' EAST OF QUORUM DRIVE CENTERLINE. ELEV. 616.39

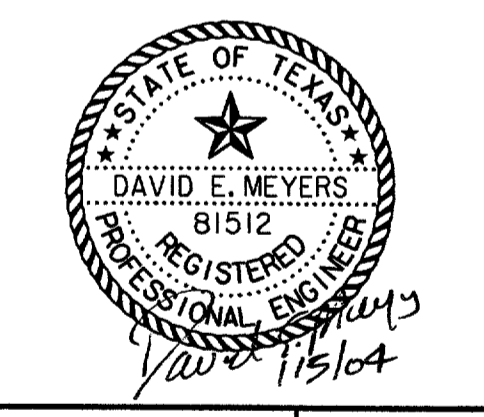

| DATE     | DESCRIPTION             | REF NO. |
|----------|-------------------------|---------|
| 1/05/04  | ISSUED FOR CONSTRUCTION |         |
| 11/07/03 | ISSUED FOR BID          |         |

| <b>WASTEWATER PLAN &amp; PROFILE</b>  |       |       |   |          |             |           |
|---|-------|-------|---|----------|-------------|-----------|
| <b>LINE A</b>   |       |       |   |          |             |           |
| <b>SPECTRUM DRIVE EXTENSION</b>   |       |       |   |          |             |           |
| <b>TOWN OF ADDISON, TEXAS</b>   |       |       |   |          |             |           |
| <small>HUFF-ZOLLERS, INC.<br/>         3131 McKinney Ave., Suite 600, Dallas, TX 75204<br/>         Phone (214) 871-3311/Fax (214) 871-0757</small> |       |       |   |          |             |           |
| DESIGN  | DRAWN | APPR. | SCALE   | DATE     | PROJECT NO. | NO.       |
| HZI   | HZI   | DEM   | H <sub>1</sub> :1"=20'<br>V <sub>1</sub> :1"=6' | NOV 2003 | 01-3220-01  | <b>38</b> |

P:\11\11\2001\11\2001\11\2001.dwg  
 11/05/04 10:00:00  
 11/07/03 10:00:00  
 11/07/03 10:00:00  
 11/07/03 10:00:00  
 11/07/03 10:00:00