




SPECTRUM CENTER

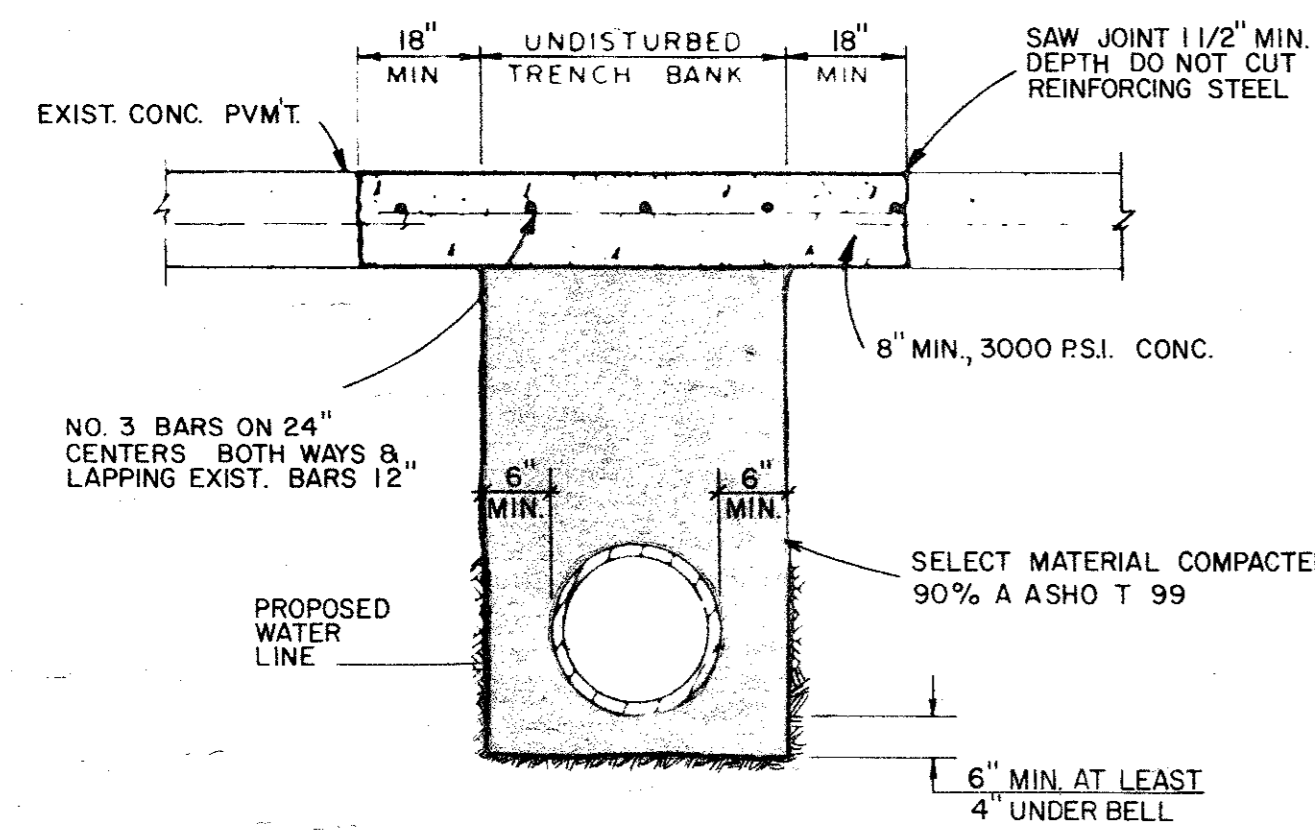

CONCRETE STREET REPAIR DETAIL

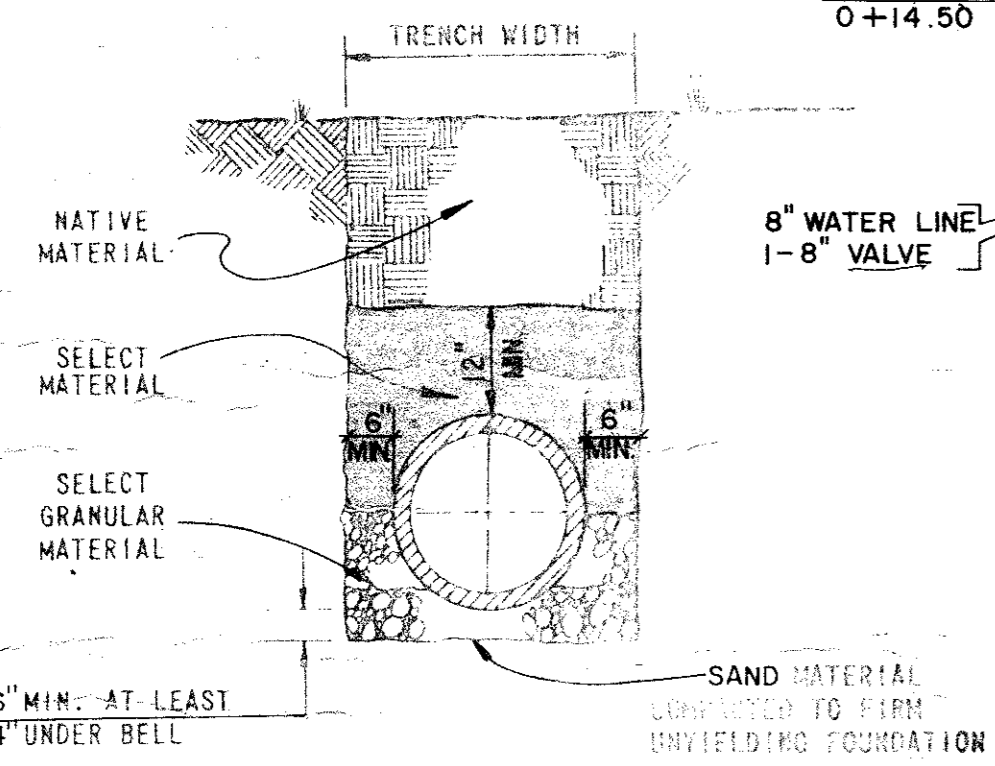


WATER & SEWER LINE EMBEDMENT DETAIL

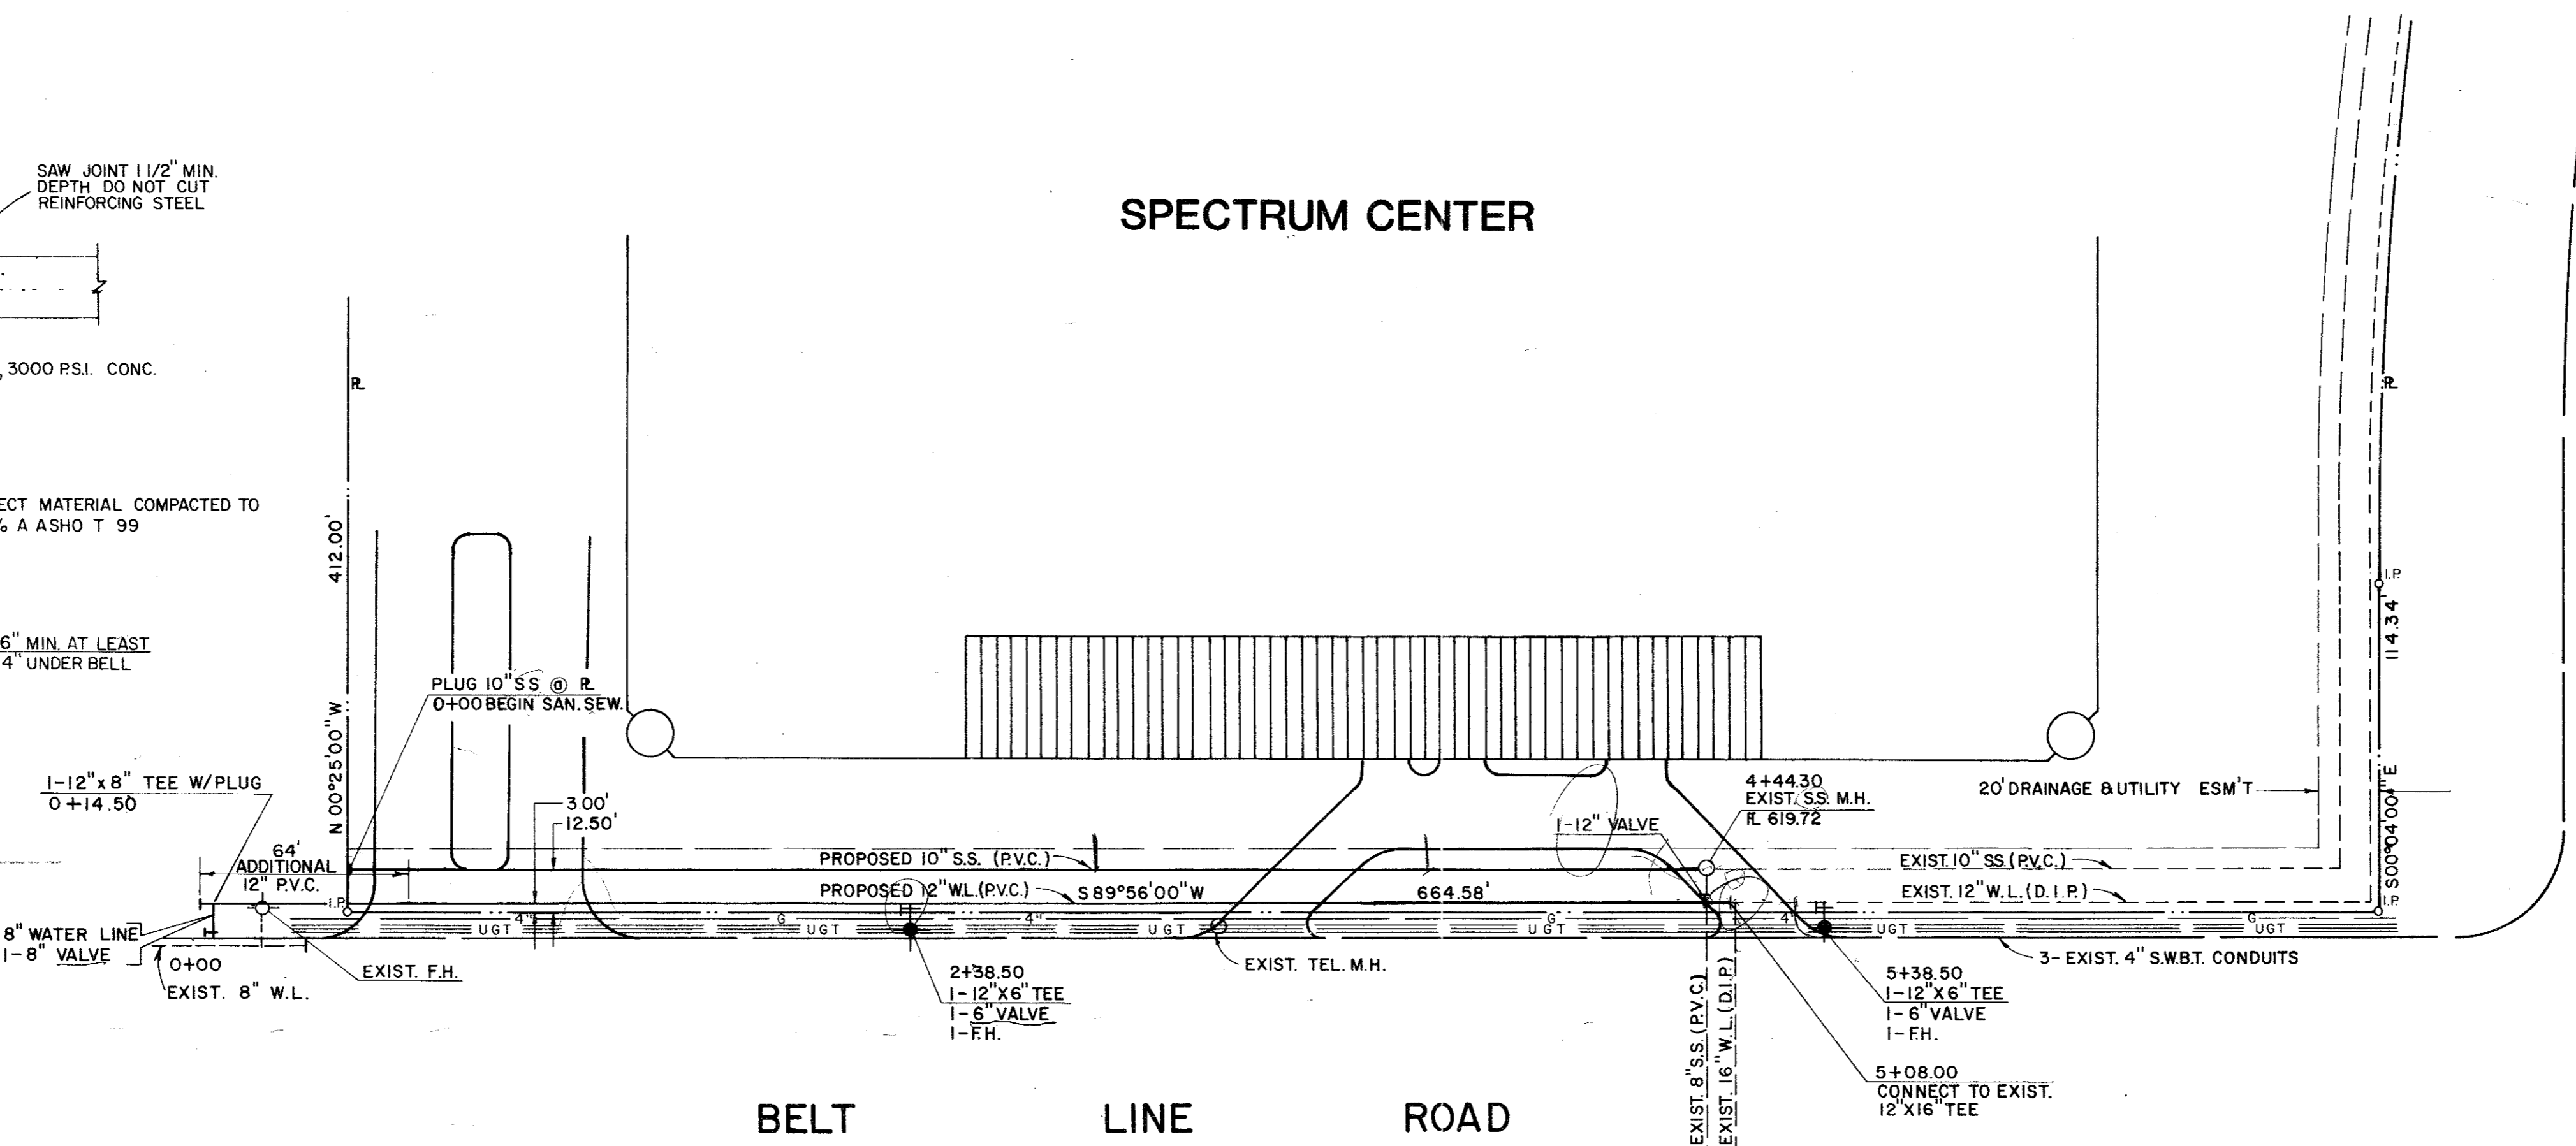

BELT LINE ROAD

DALLAS PARKWAY

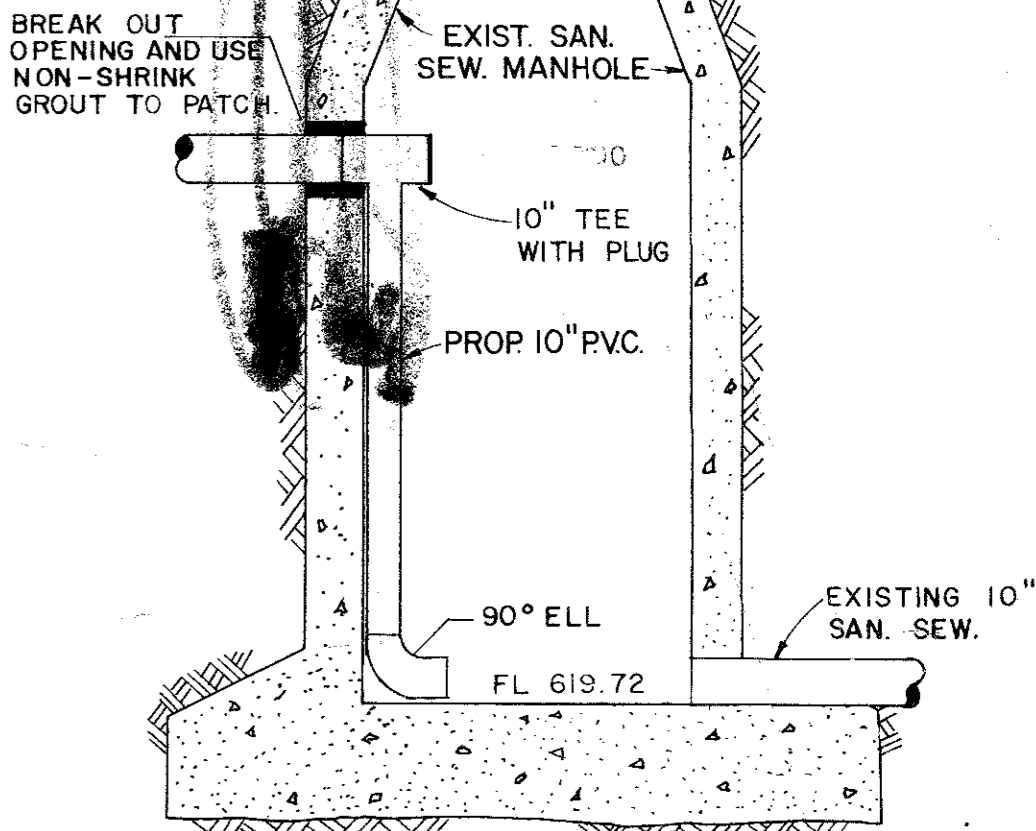

PROPOSED DROP @ EXISTING SANITARY SEWER MANHOLE


- GENERAL NOTES
1. 12" Water Line to be P.V.C. (Per City of Addison Standards).
 2. Fire Hydrants to be Mueller Centurians with 4" Steamers, and 2" Hose Connections, NST.
 3. Gate Valves to be Mueller Valves.
 4. Copper Tracer Wire to be placed on top of Water Lines and tied to Gate Valves and Fire Hydrants.

John Maggione



SCALE: 1"=40' HORIZ.
 1"=4' VERT.

B.M.-WATER DEPT. B.M. AT N.W. CORNER DALLAS PKWY. & BELT LINE RD.
 ELEV. 632.10

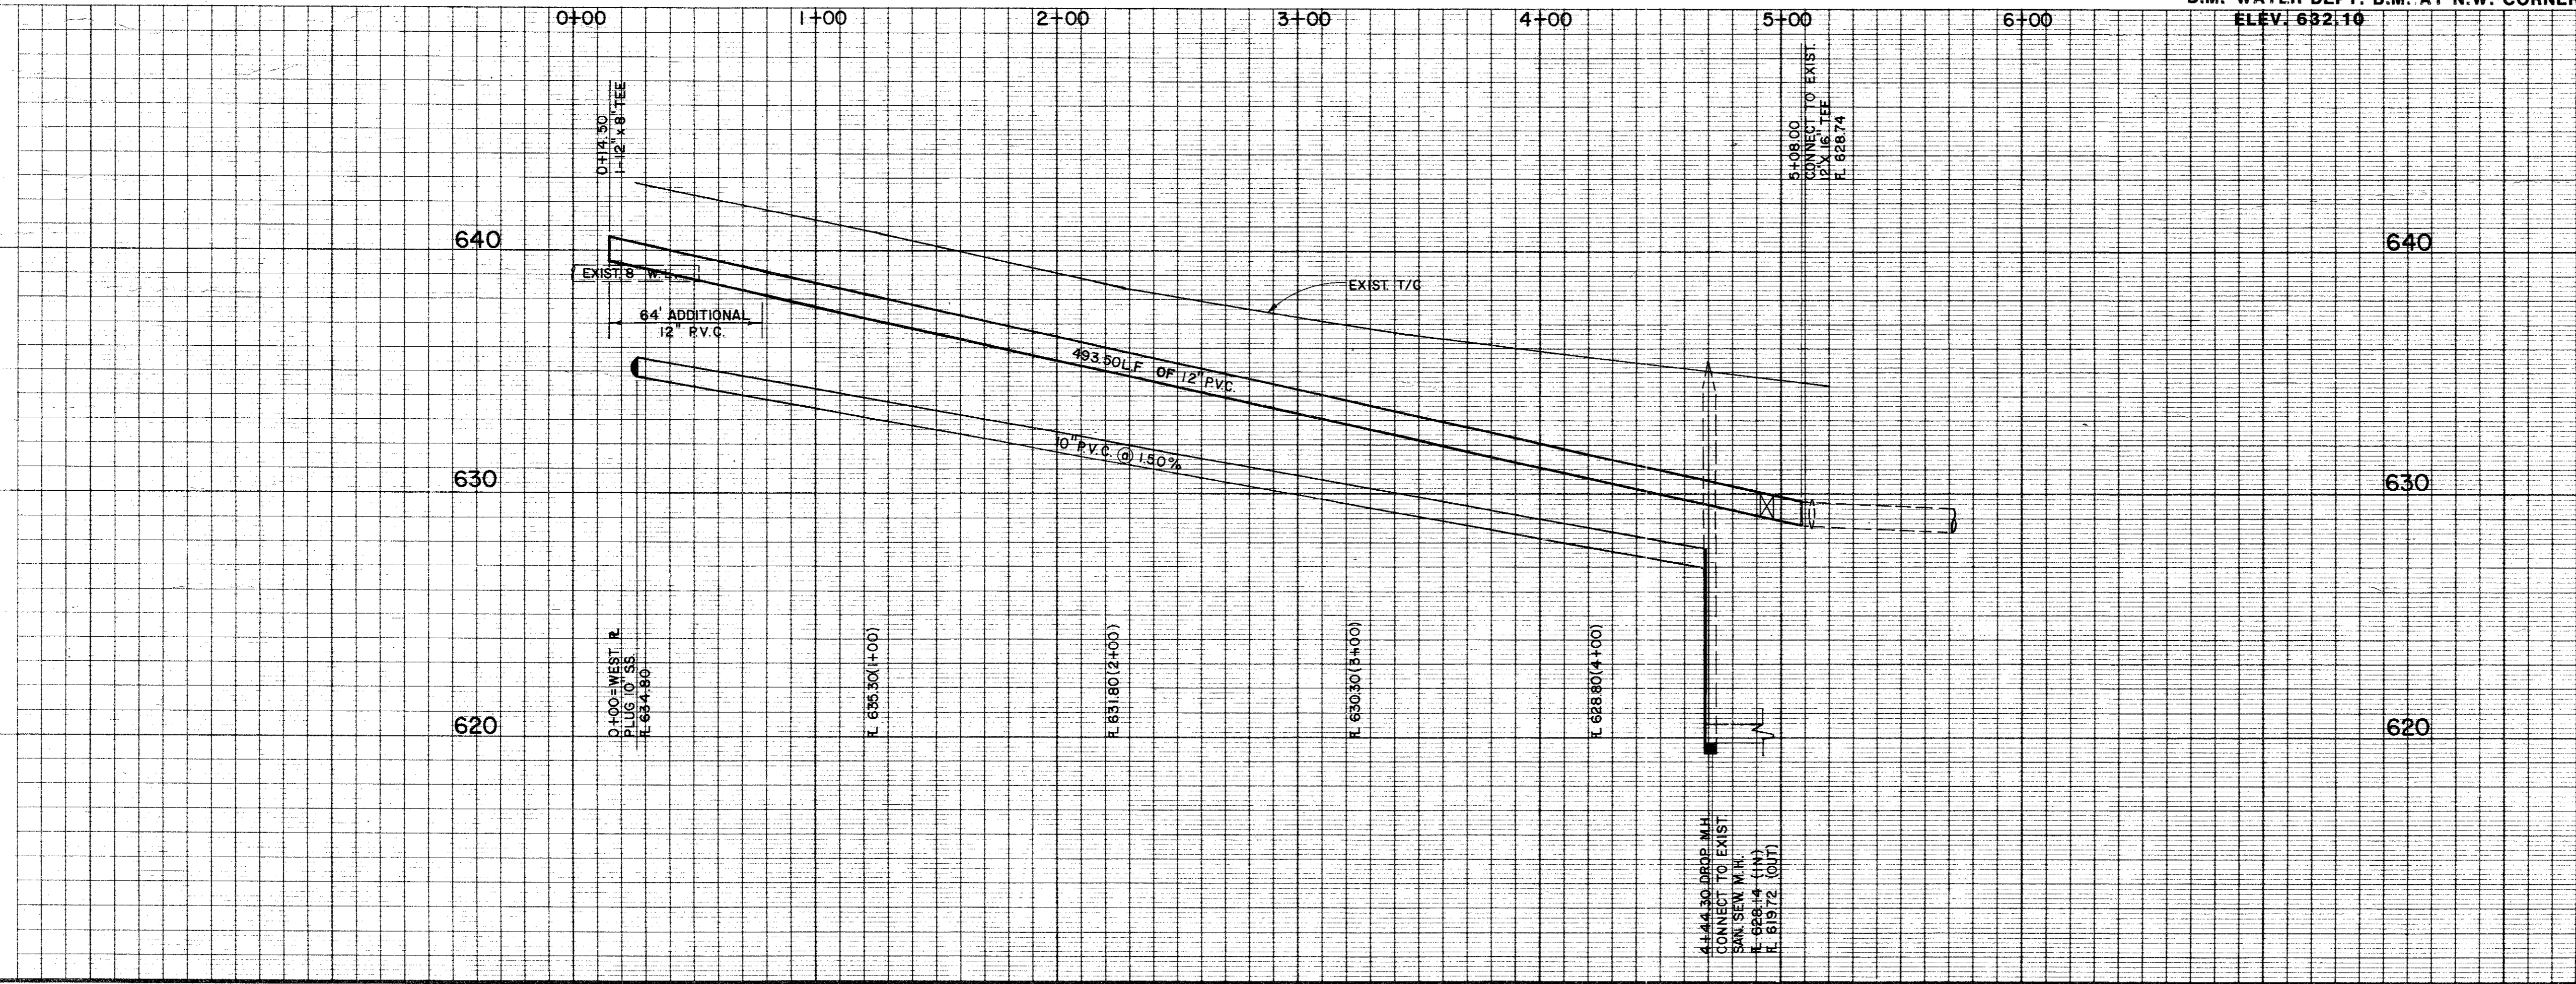

AS-BUILT

WATER & SEWER LINE EXTENSION
 SPECTRUM CENTER

CITY OF ADDISON
 DALLAS COUNTY, TEXAS



SUB. REC. REV.

DRAWN BY: G.A.I.D. PROJECT NO. 9034-243
 DATE: 10/81 FILE NO.

FEB 15 1982