

# CITIES OF ADDISON AND FARMERS BRANCH

## DALLAS COUNTY, TEXAS

### CONSTRUCTION PLANS FOR: SPRING VALLEY ROAD


MARSH LANE TO MIDWAY ROAD  
PROJECT LENGTH = 5132 FT.

#### CITY OF FARMERS BRANCH

JOHN DODD - MAYOR  
CAROL DINGMAN - MAYOR PRO-TEM  
FRED JOHNSON  
HERB WEIDINGER  
BILL GLANCY  
DAVE BLAIR

#### CITY OF ADDISON

JERRY J. REDDING - MAYOR  
COUNCIL MEMBERS:  
JOHN B. ALLEN  
RICHARD RODER  
WILLIAM F. SELLMAYER  
BARRY FINKELSTEIN  
STEWART BEATTY

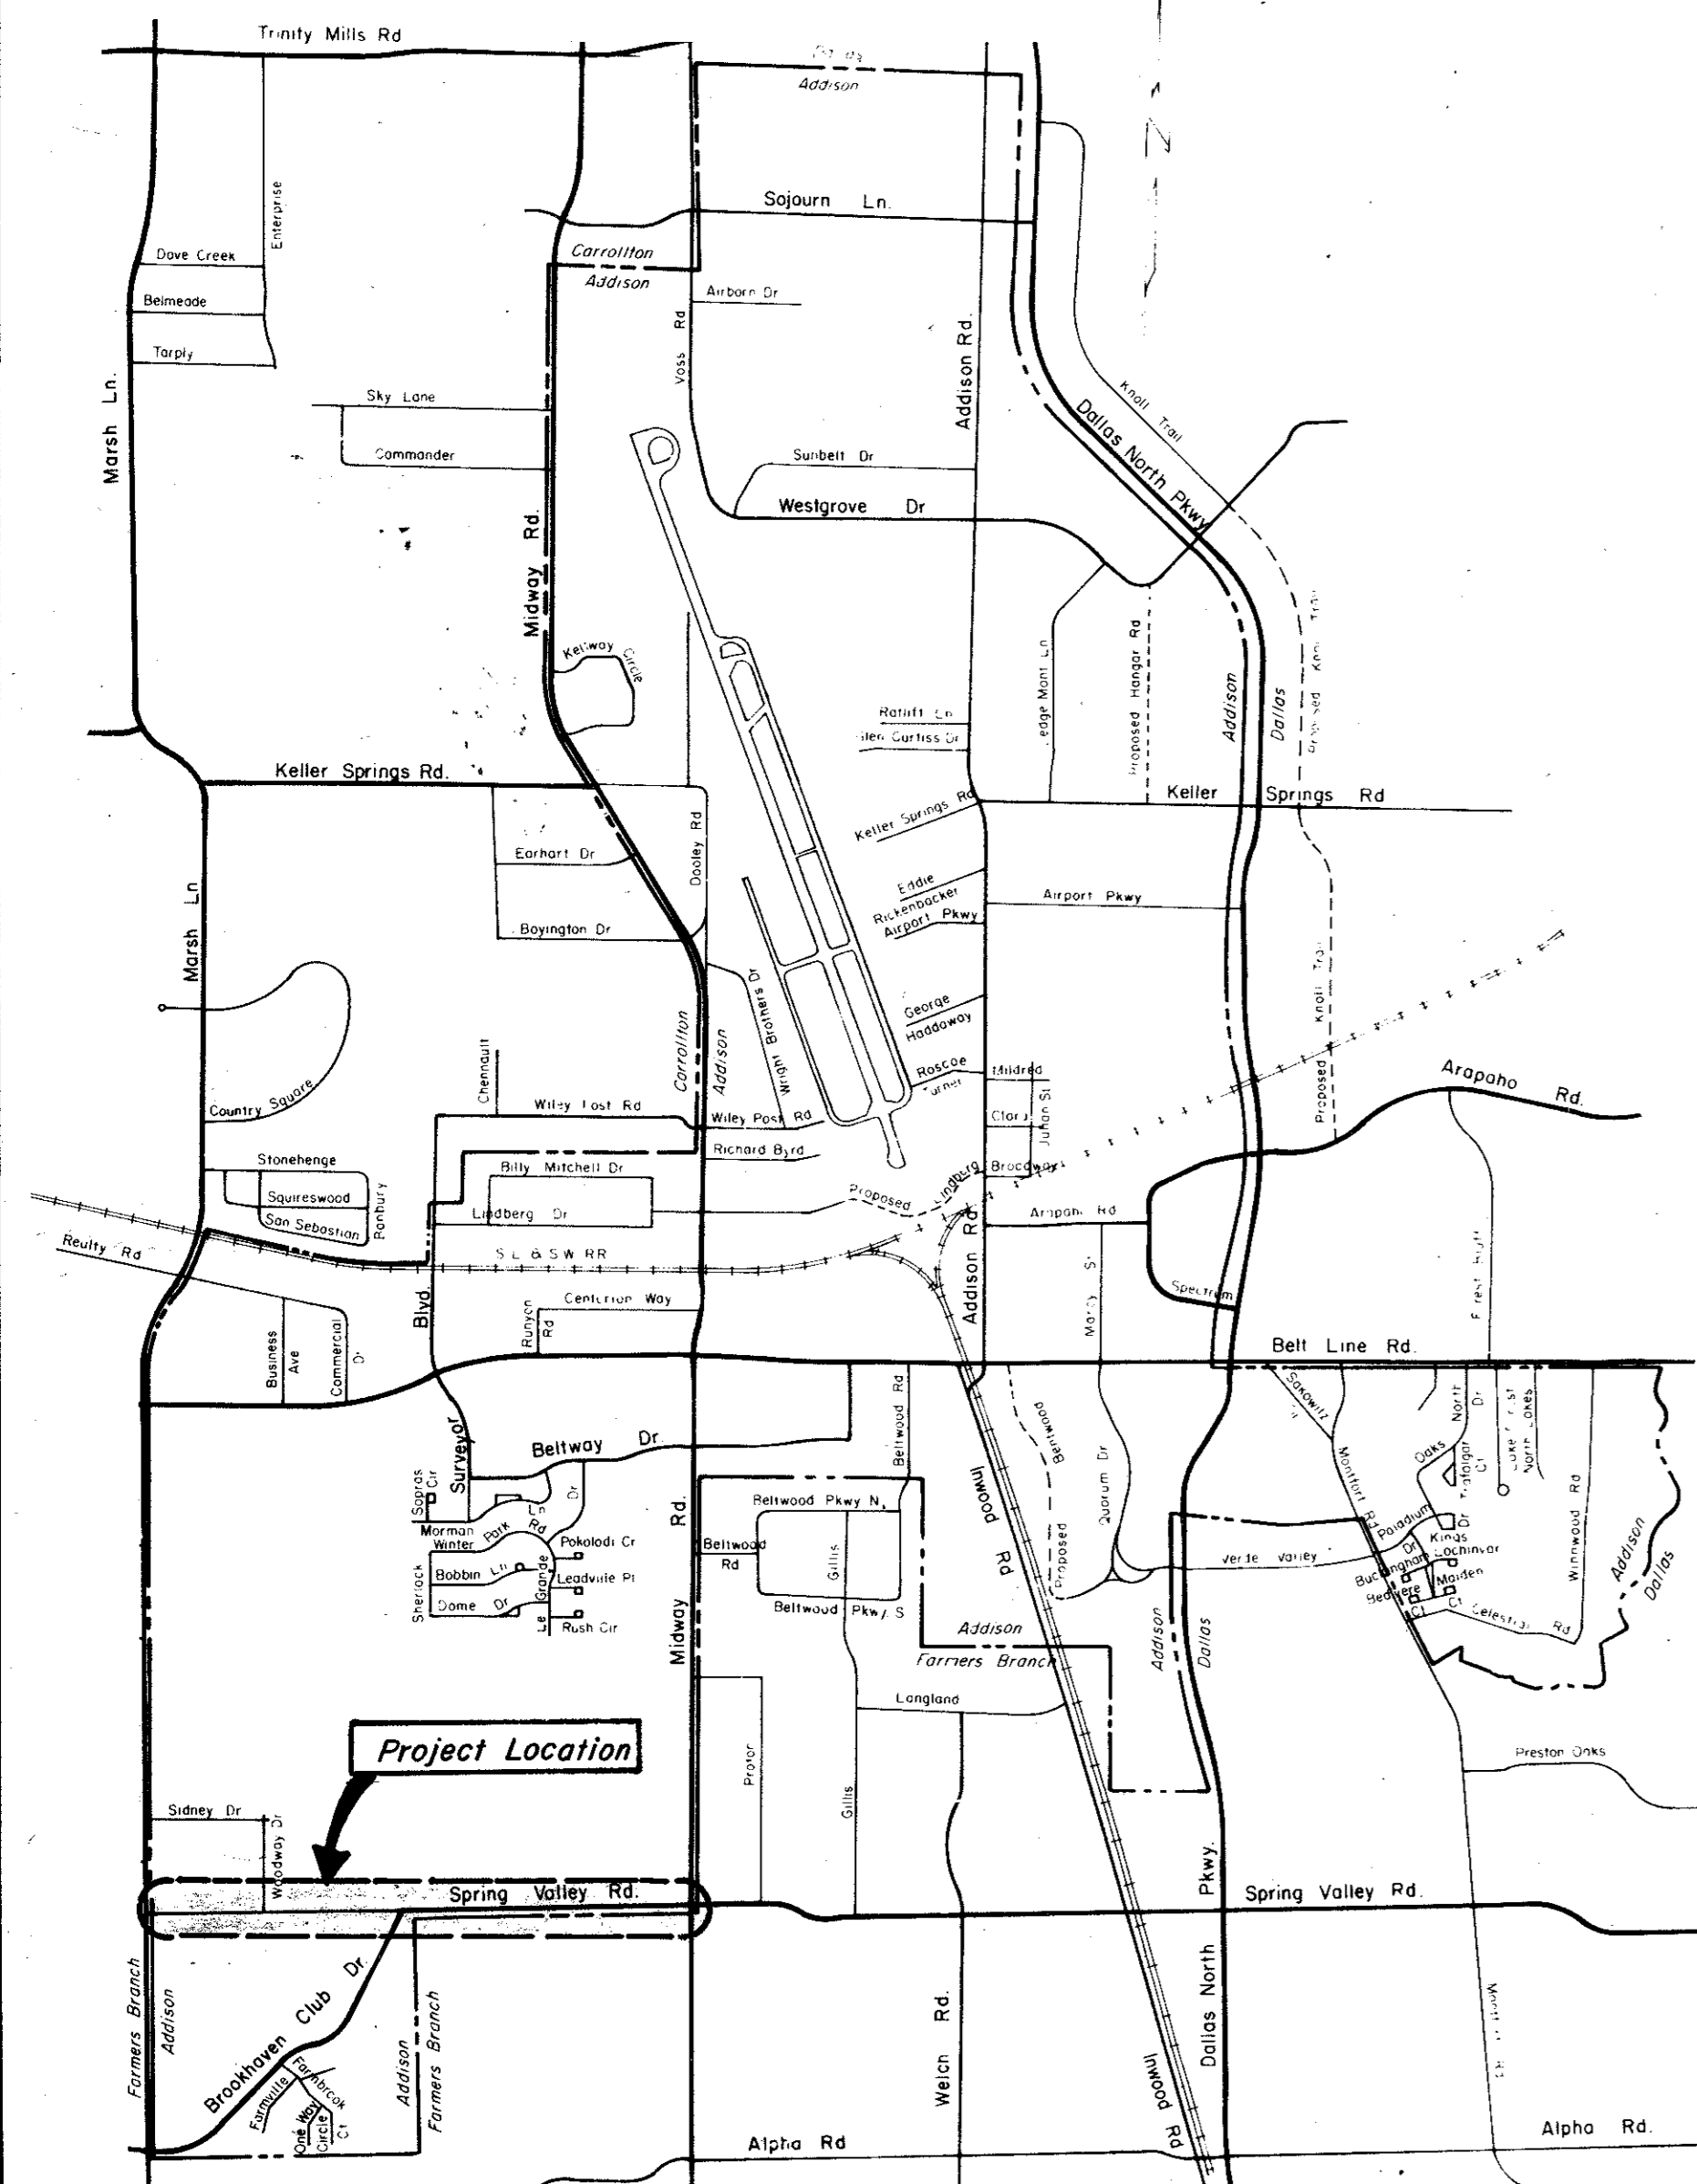

GINN INC.  
CONSULTING ENGINEERS  
DALLAS, TEXAS  
1982

Record Set 5/9/85

CITY OF FARMERS BRANCH

Approved By: *Earl Deland*

DATE: *Nov. 23, 1982*

CITY OF ADDISON

Approved By: *Jerry Redding*  
Mayor

DATE: *Nov 23, 1982*