


Record Set 5/9/85

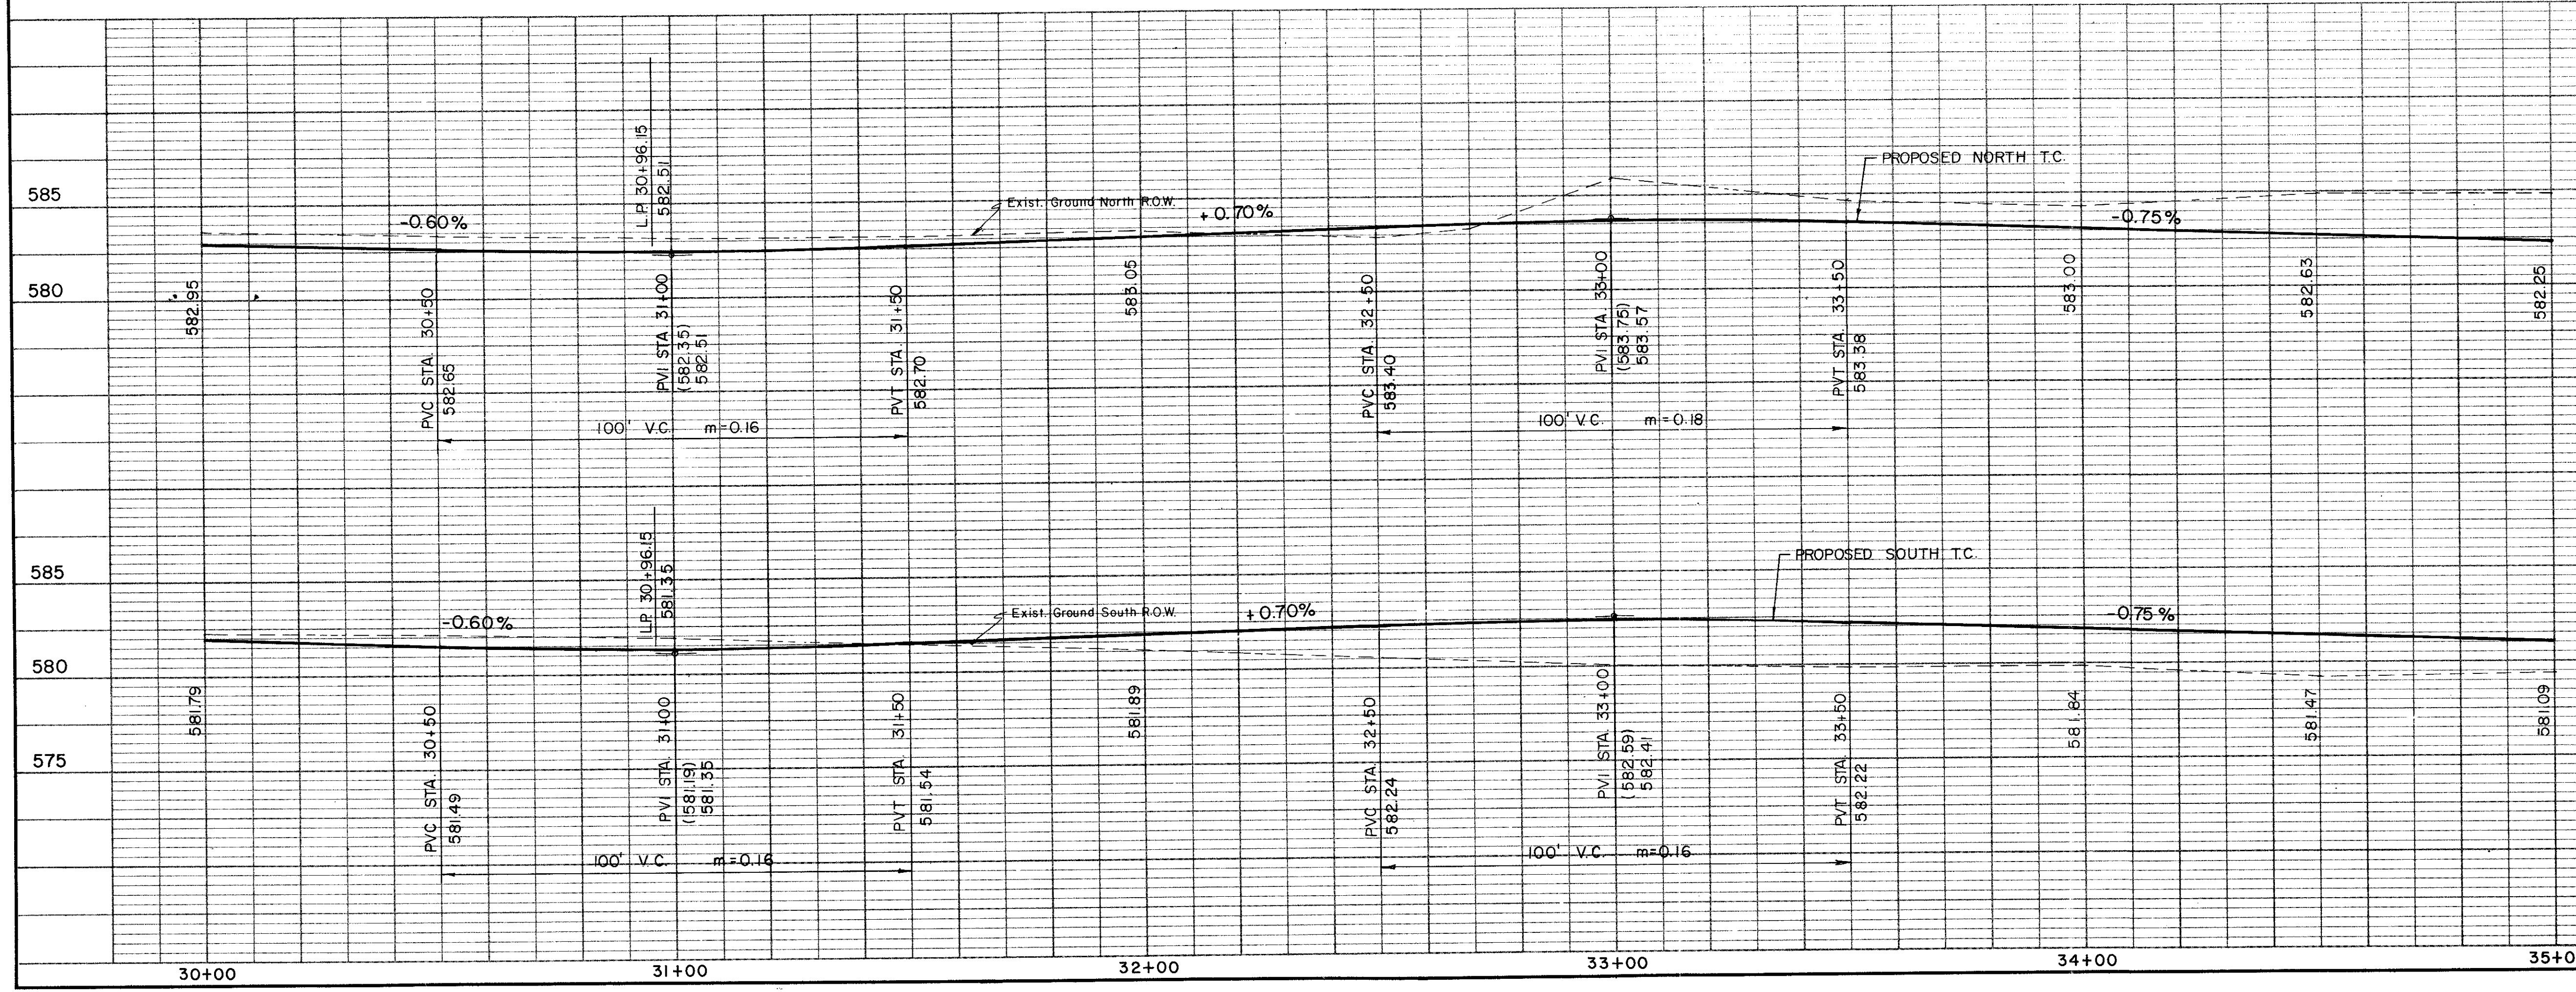

DESIGNED - GF-HJ	DRAWN - S.M.-GF	DATE -	FILE J-178
APPROVED - H.W.G.	CHECKED - HBJ	SCALE - H=1"=20'/V=1"=5'	SHEET 10 OF

1 of 2 Gas Relocated  
 NO. \_\_\_\_\_ REVISION \_\_\_\_\_ BY \_\_\_\_\_ DATE 7/9/82  
 CITY OF ADDISON  
 DALLAS COUNTY, TEXAS  
**SPRING VALLEY ROAD**  
 Sta. 30+00 to Sta. 35+00  
**PAVING**  
**GINN, INC.**  
 Consulting Engineers Dallas, Texas